THIS MAP WAS PREPARED FOR ASSESSMENT PURPOSE ONLY.

SECTION 24 T.23S. R. 8 W. W.M.
DOUGLAS COUNTY

1" = 400

23 8 24

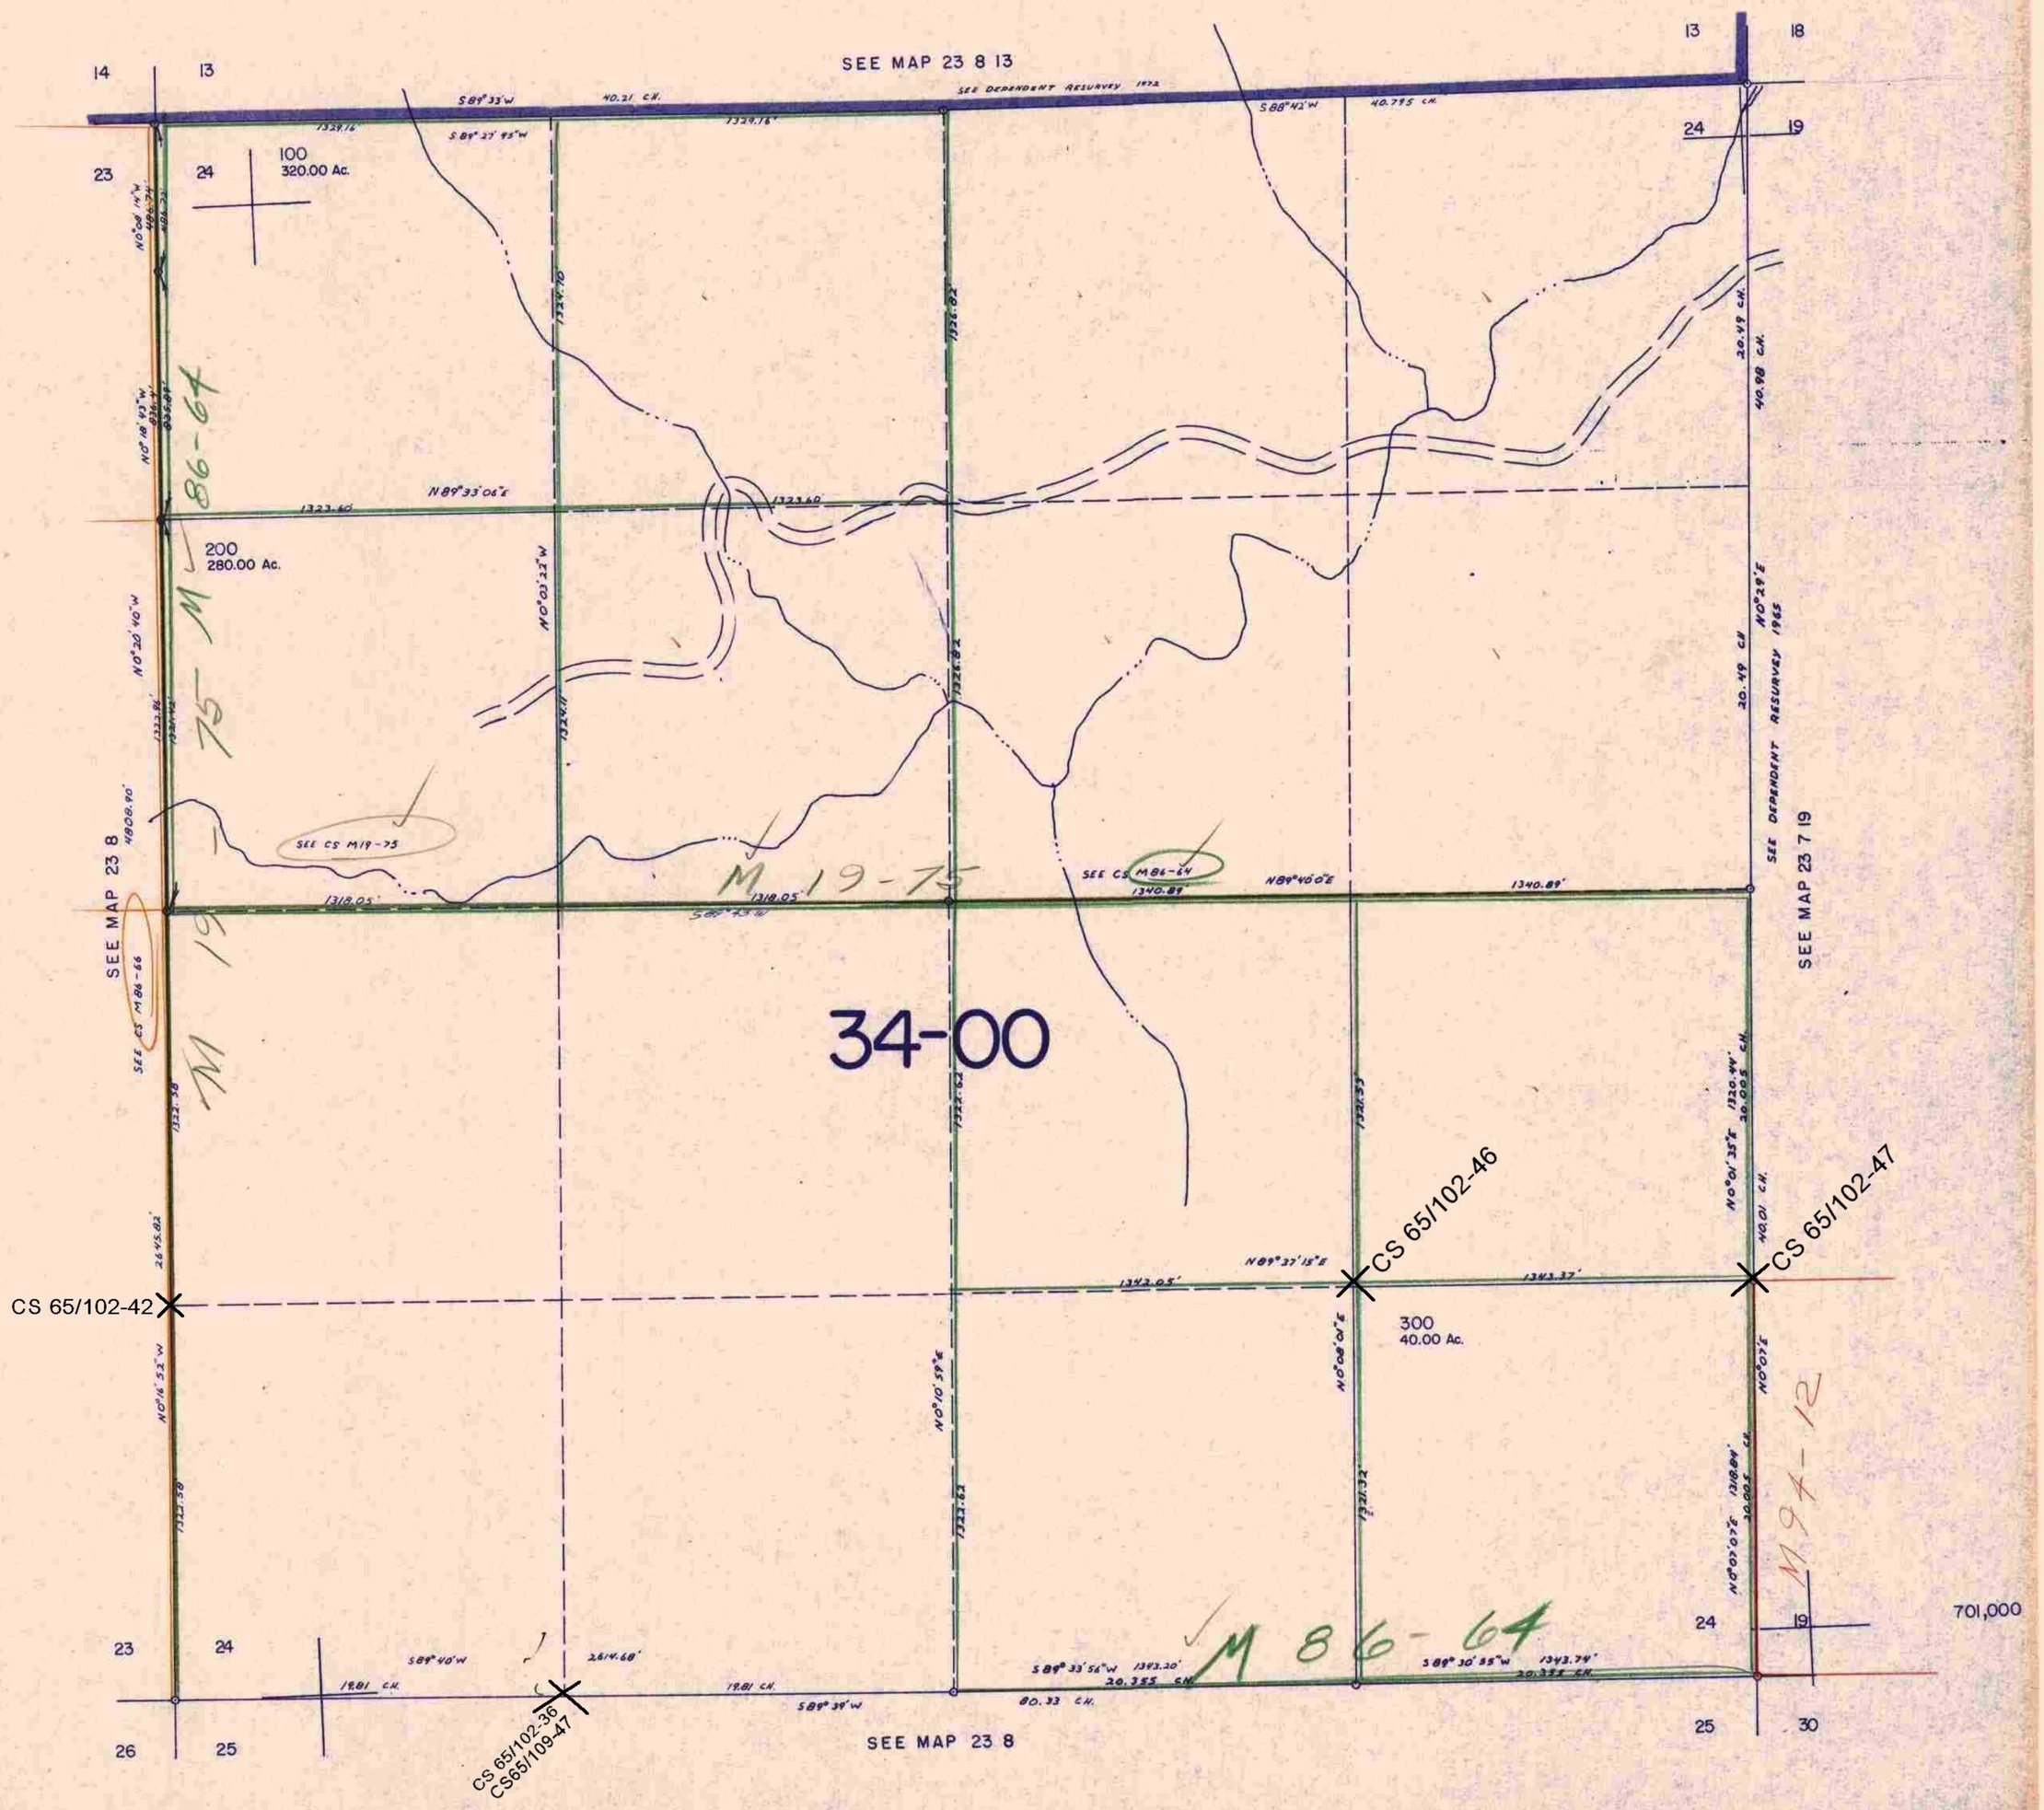

23 8 24

10/83