THIS MAP WAS PREPARED FOR ASSESSMENT PURPOSE ONLY.

SECTION 14 T.23S. R.10W. W.M.
DOUGLAS COUNTY

1"=400'

23 10 14

CANCELLED No's 201

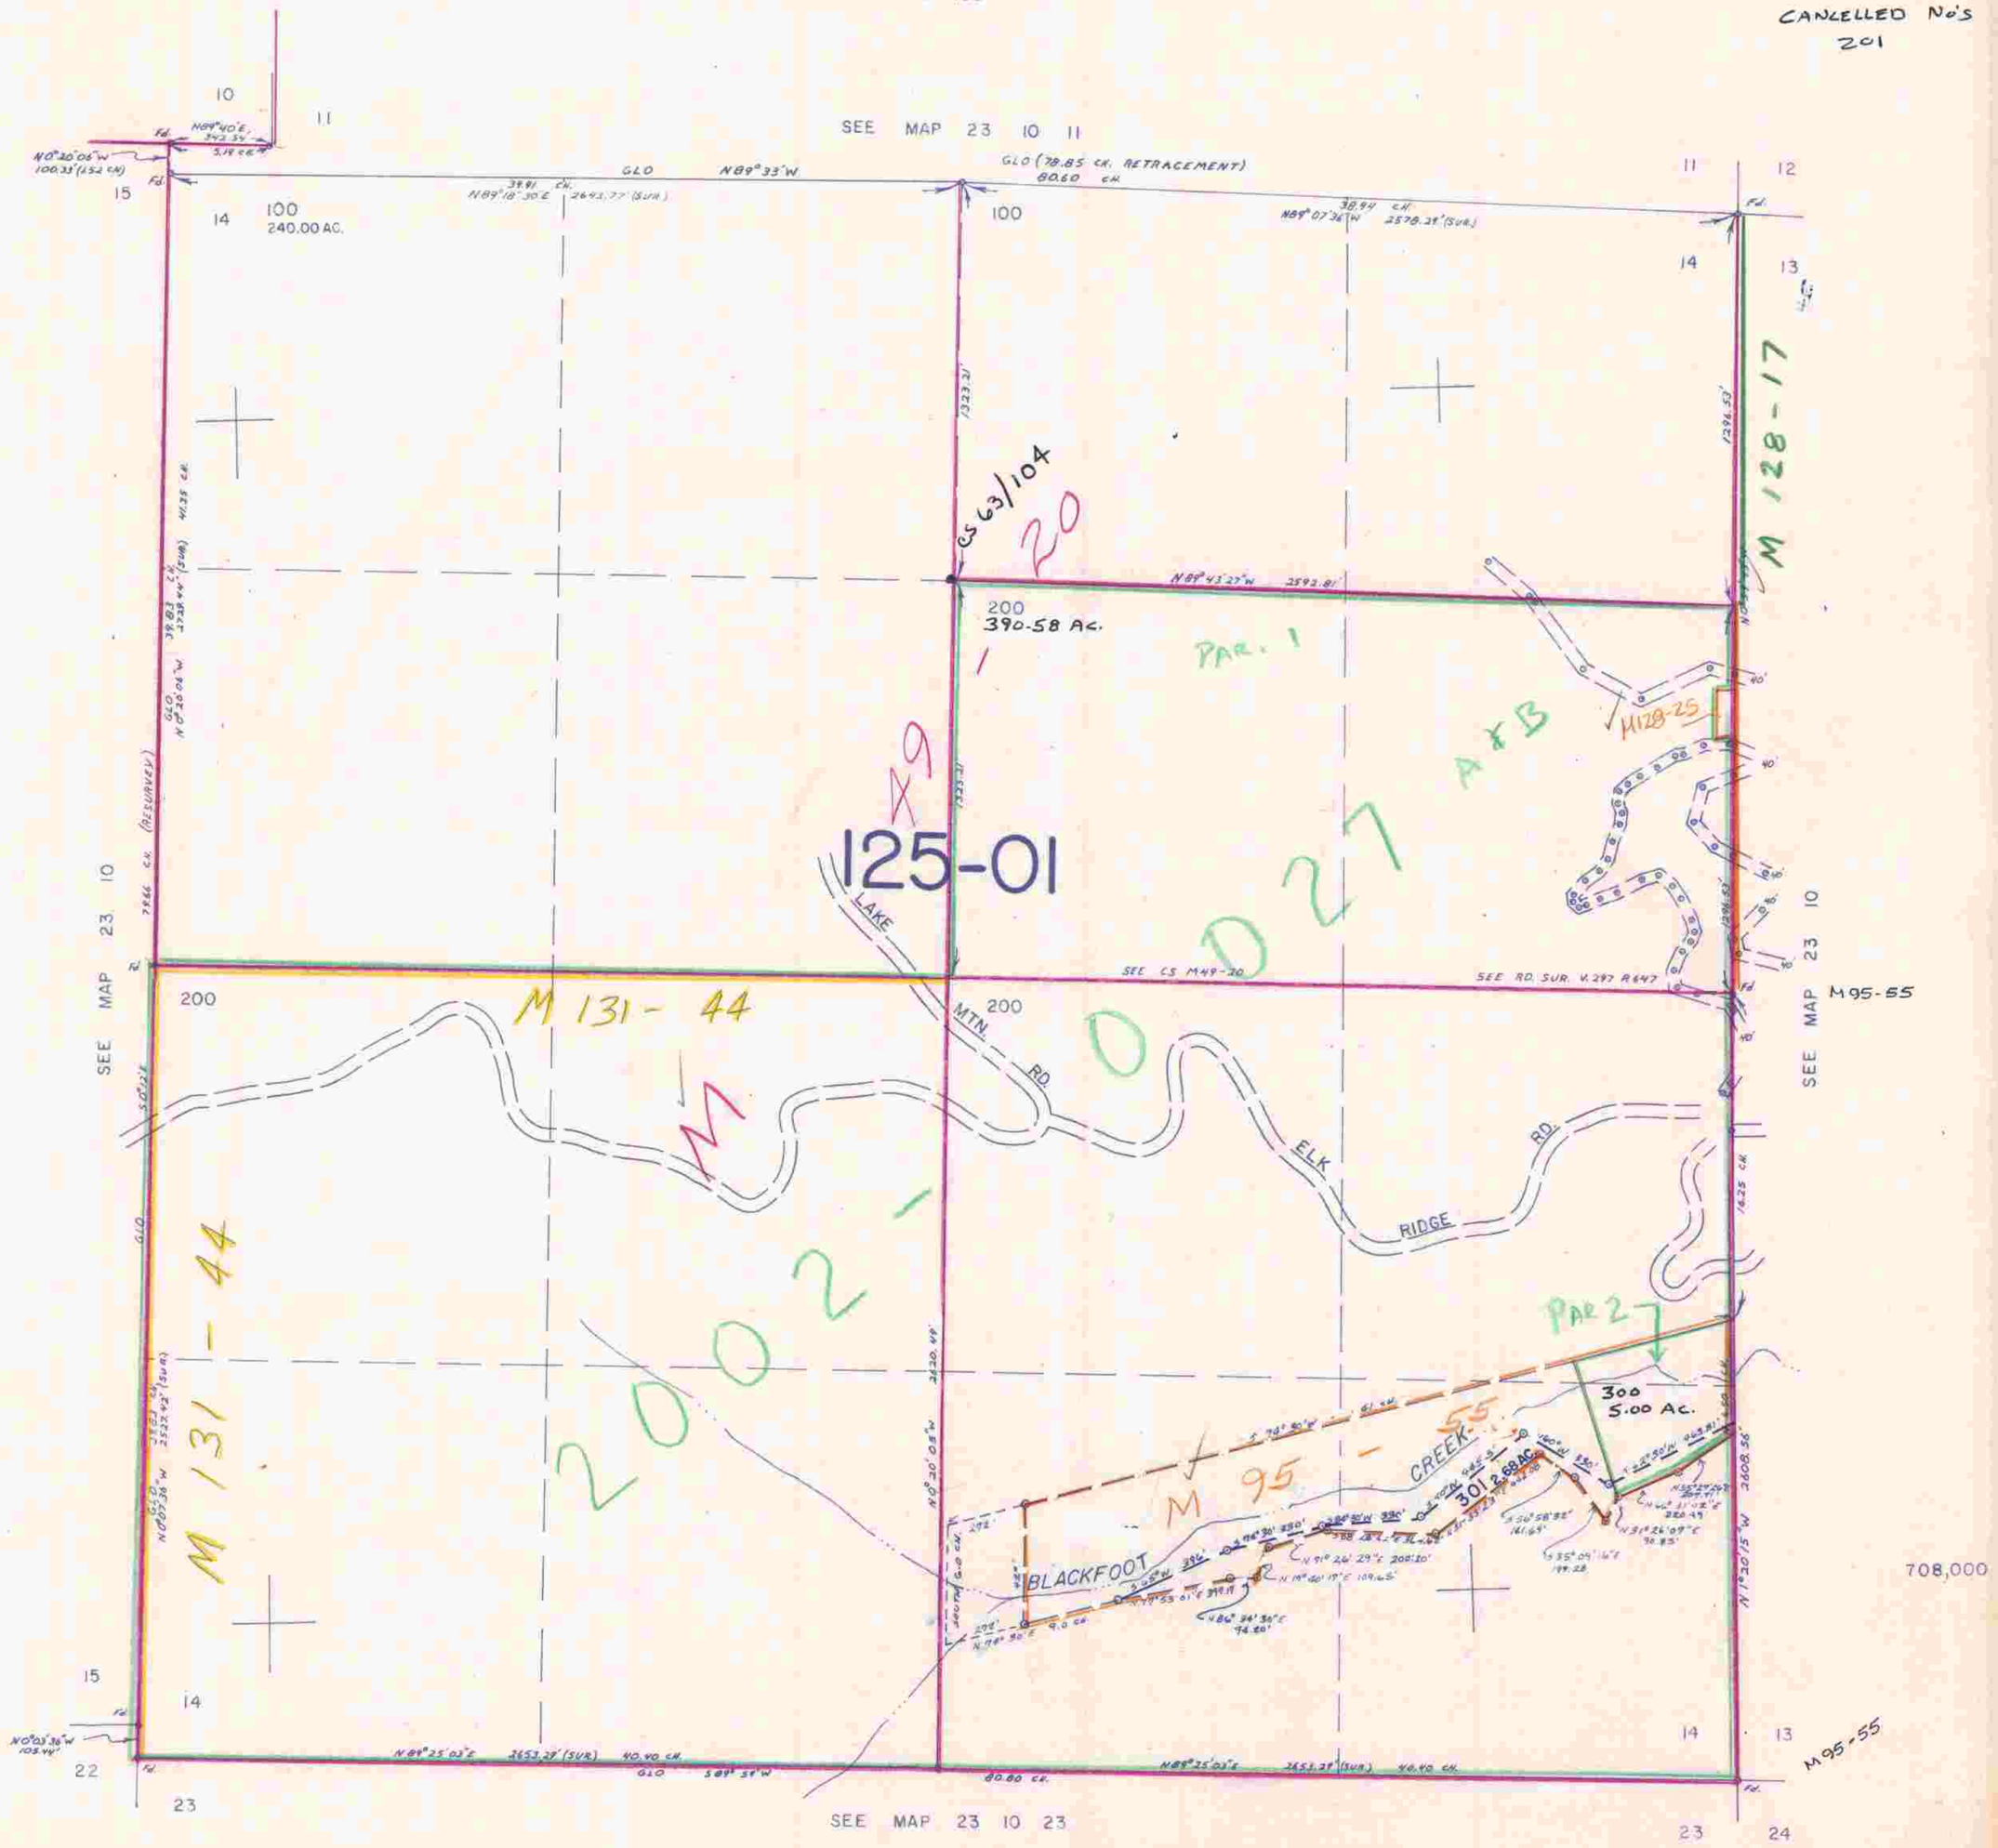

23 10 14