NE1/4 SEC. 31 T.24S. R.3W. W.M.
DOUGLAS COUNTY

1"=200'

THIS MAP WAS PREPARED FOR ASSESSMENT PURPOSE ONLY.

1/4 COR.

30 29
31 32

CANCELLED NOS.

200
200 MI

SEE MAP 24 3 31

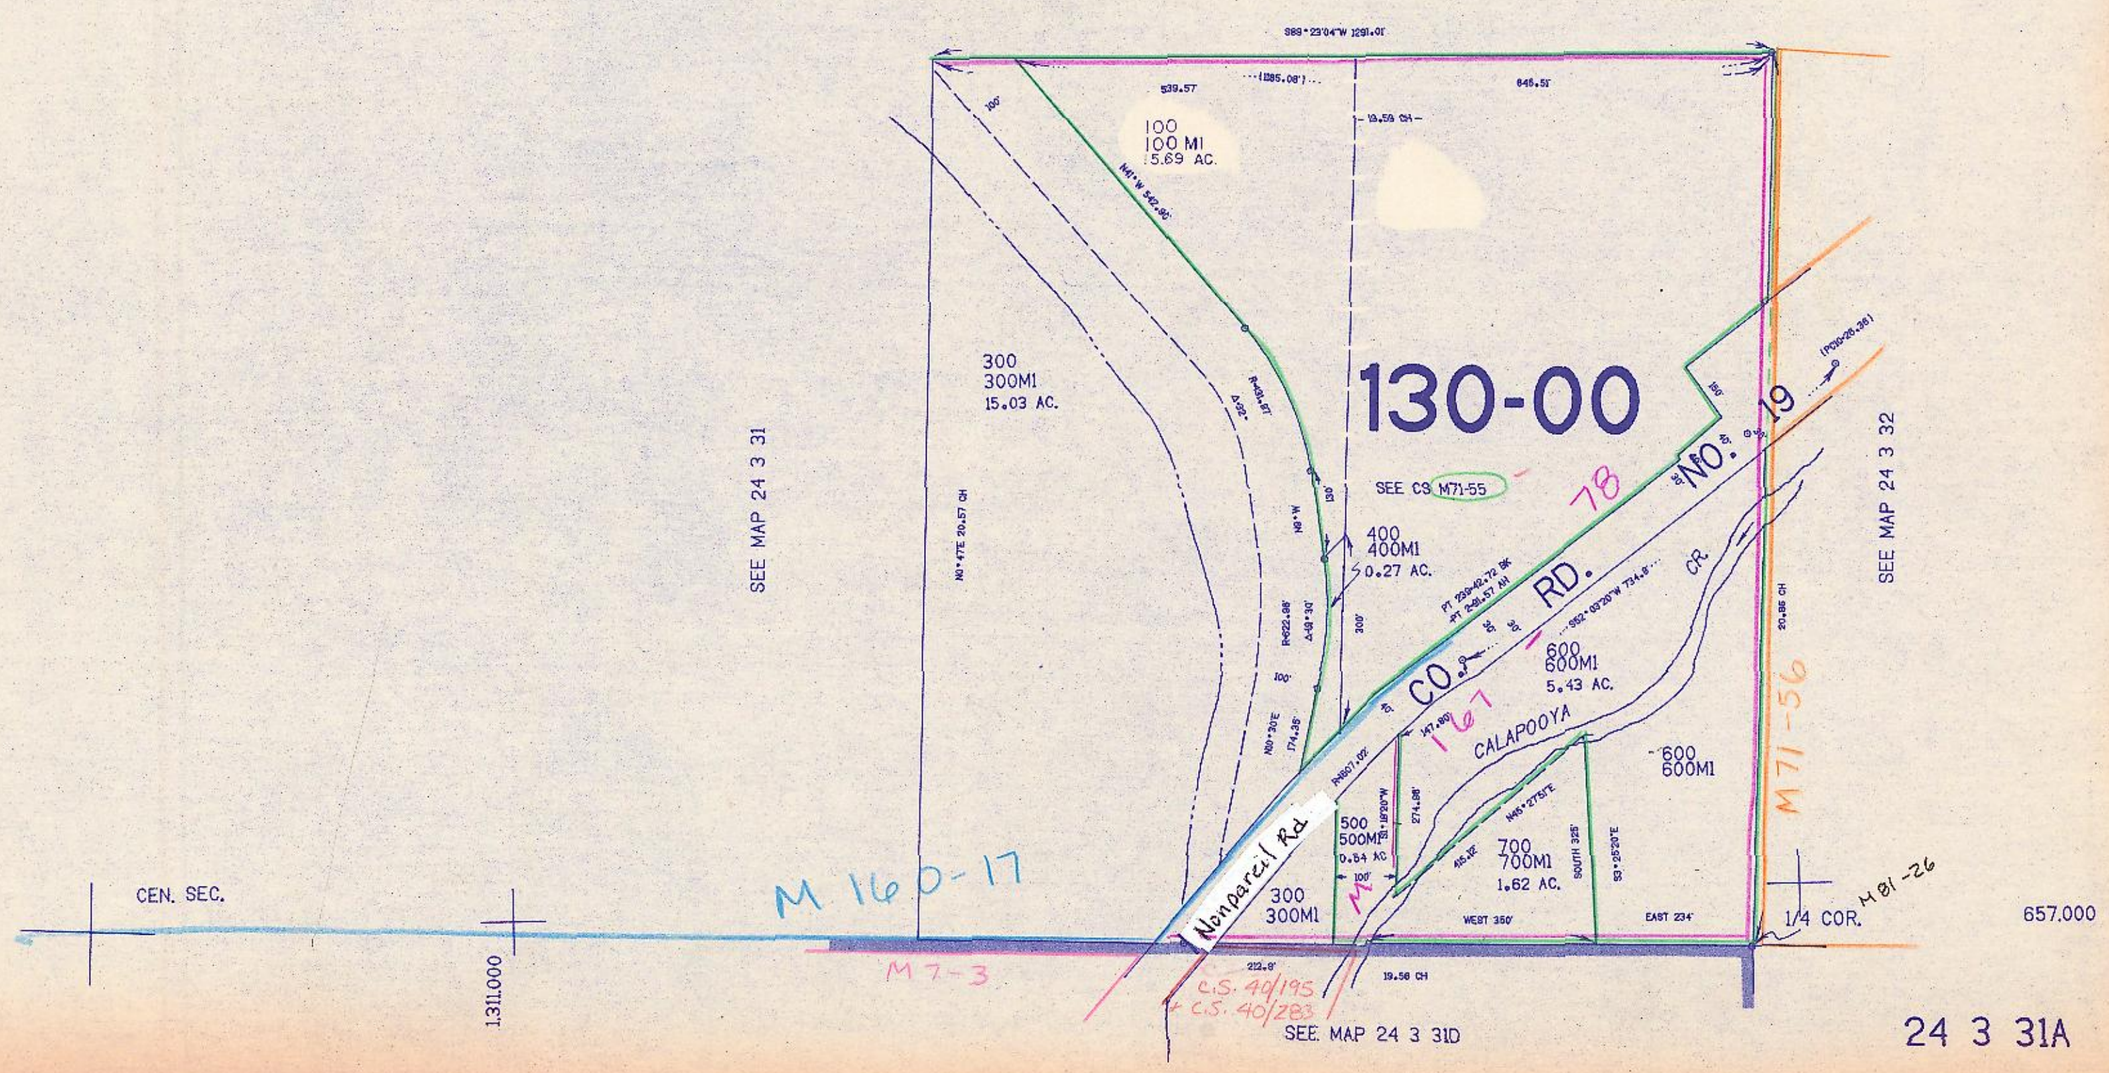

8/90