


THIS MAP WAS PREPARED FOR ASSESSMENT PURPOSE ONLY.

T.24S. R.4W. W.M. DOUGLAS COUNTY

24 4 & INDEX

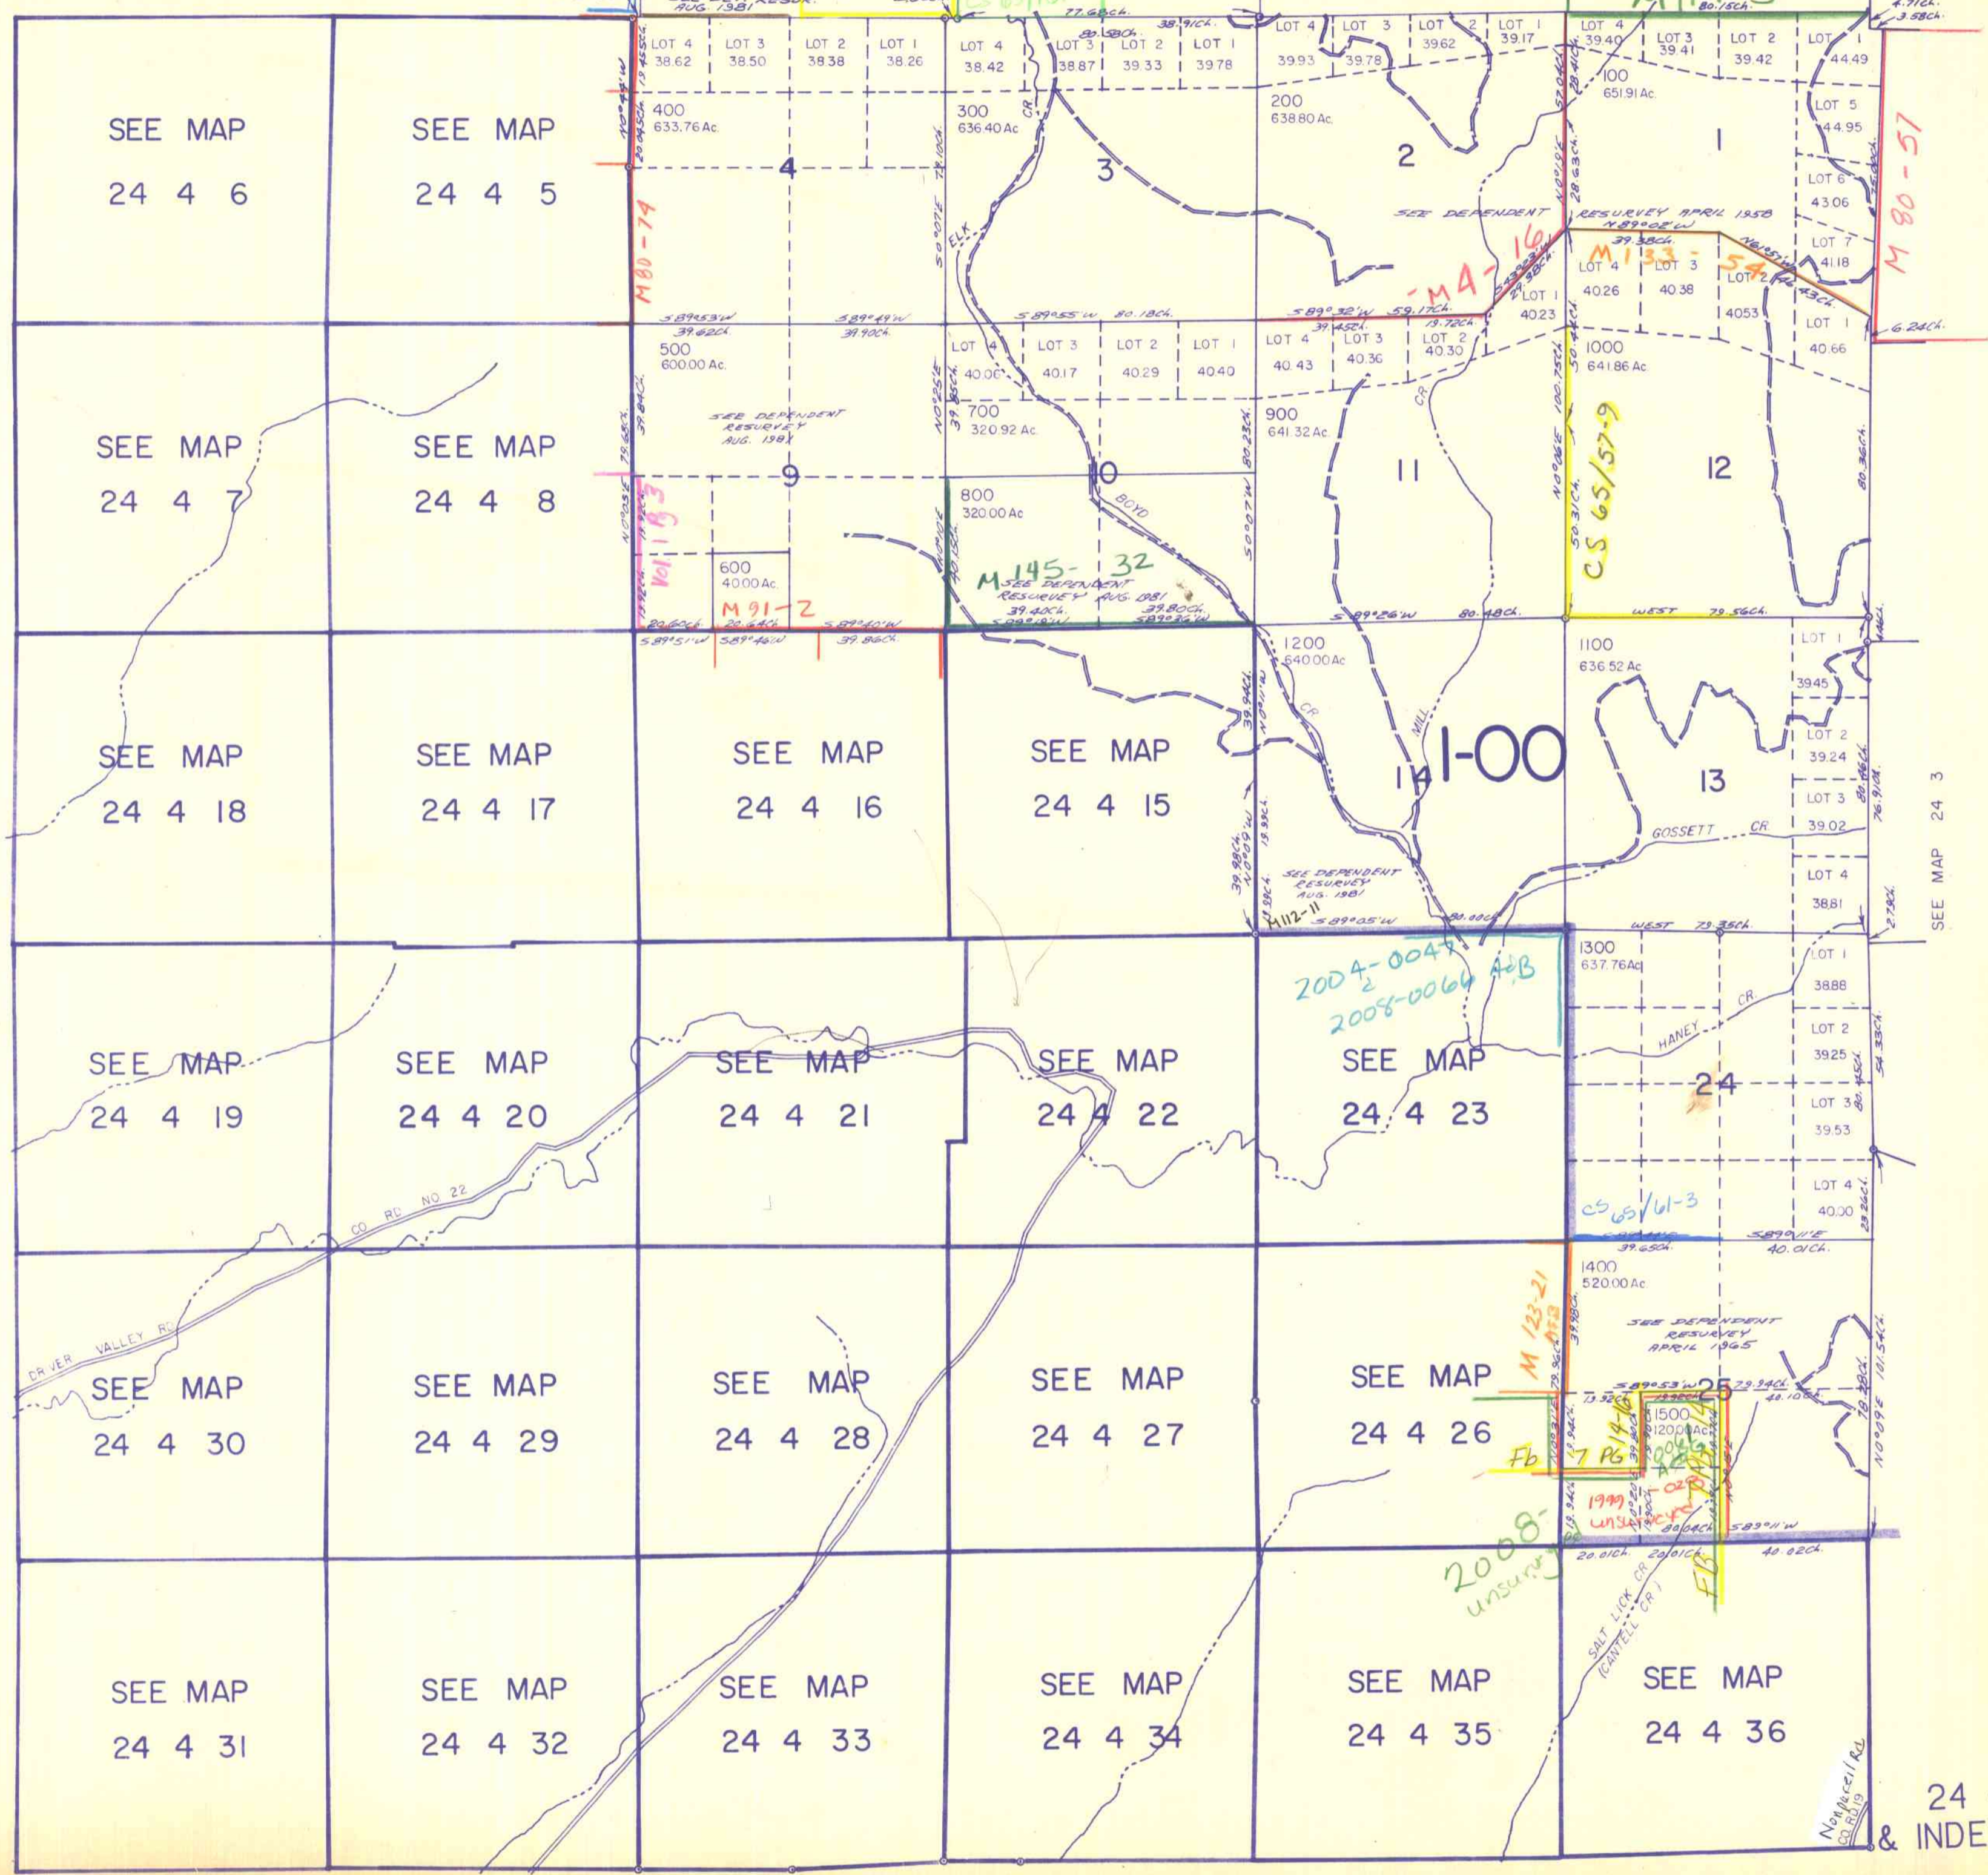

SEE MAP 24 5

SEE MAP 24 3

SEE MAP 25 4

24 4 & INDEX

10/92 BC