THIS MAP WAS PREPARED FOR ASSESSMENT PURPOSE ONLY.

SEC.8 T.24S. R.4W. W.M.
DOUGLAS COUNTY
1" = 400'

REVISED ON 8-9-11
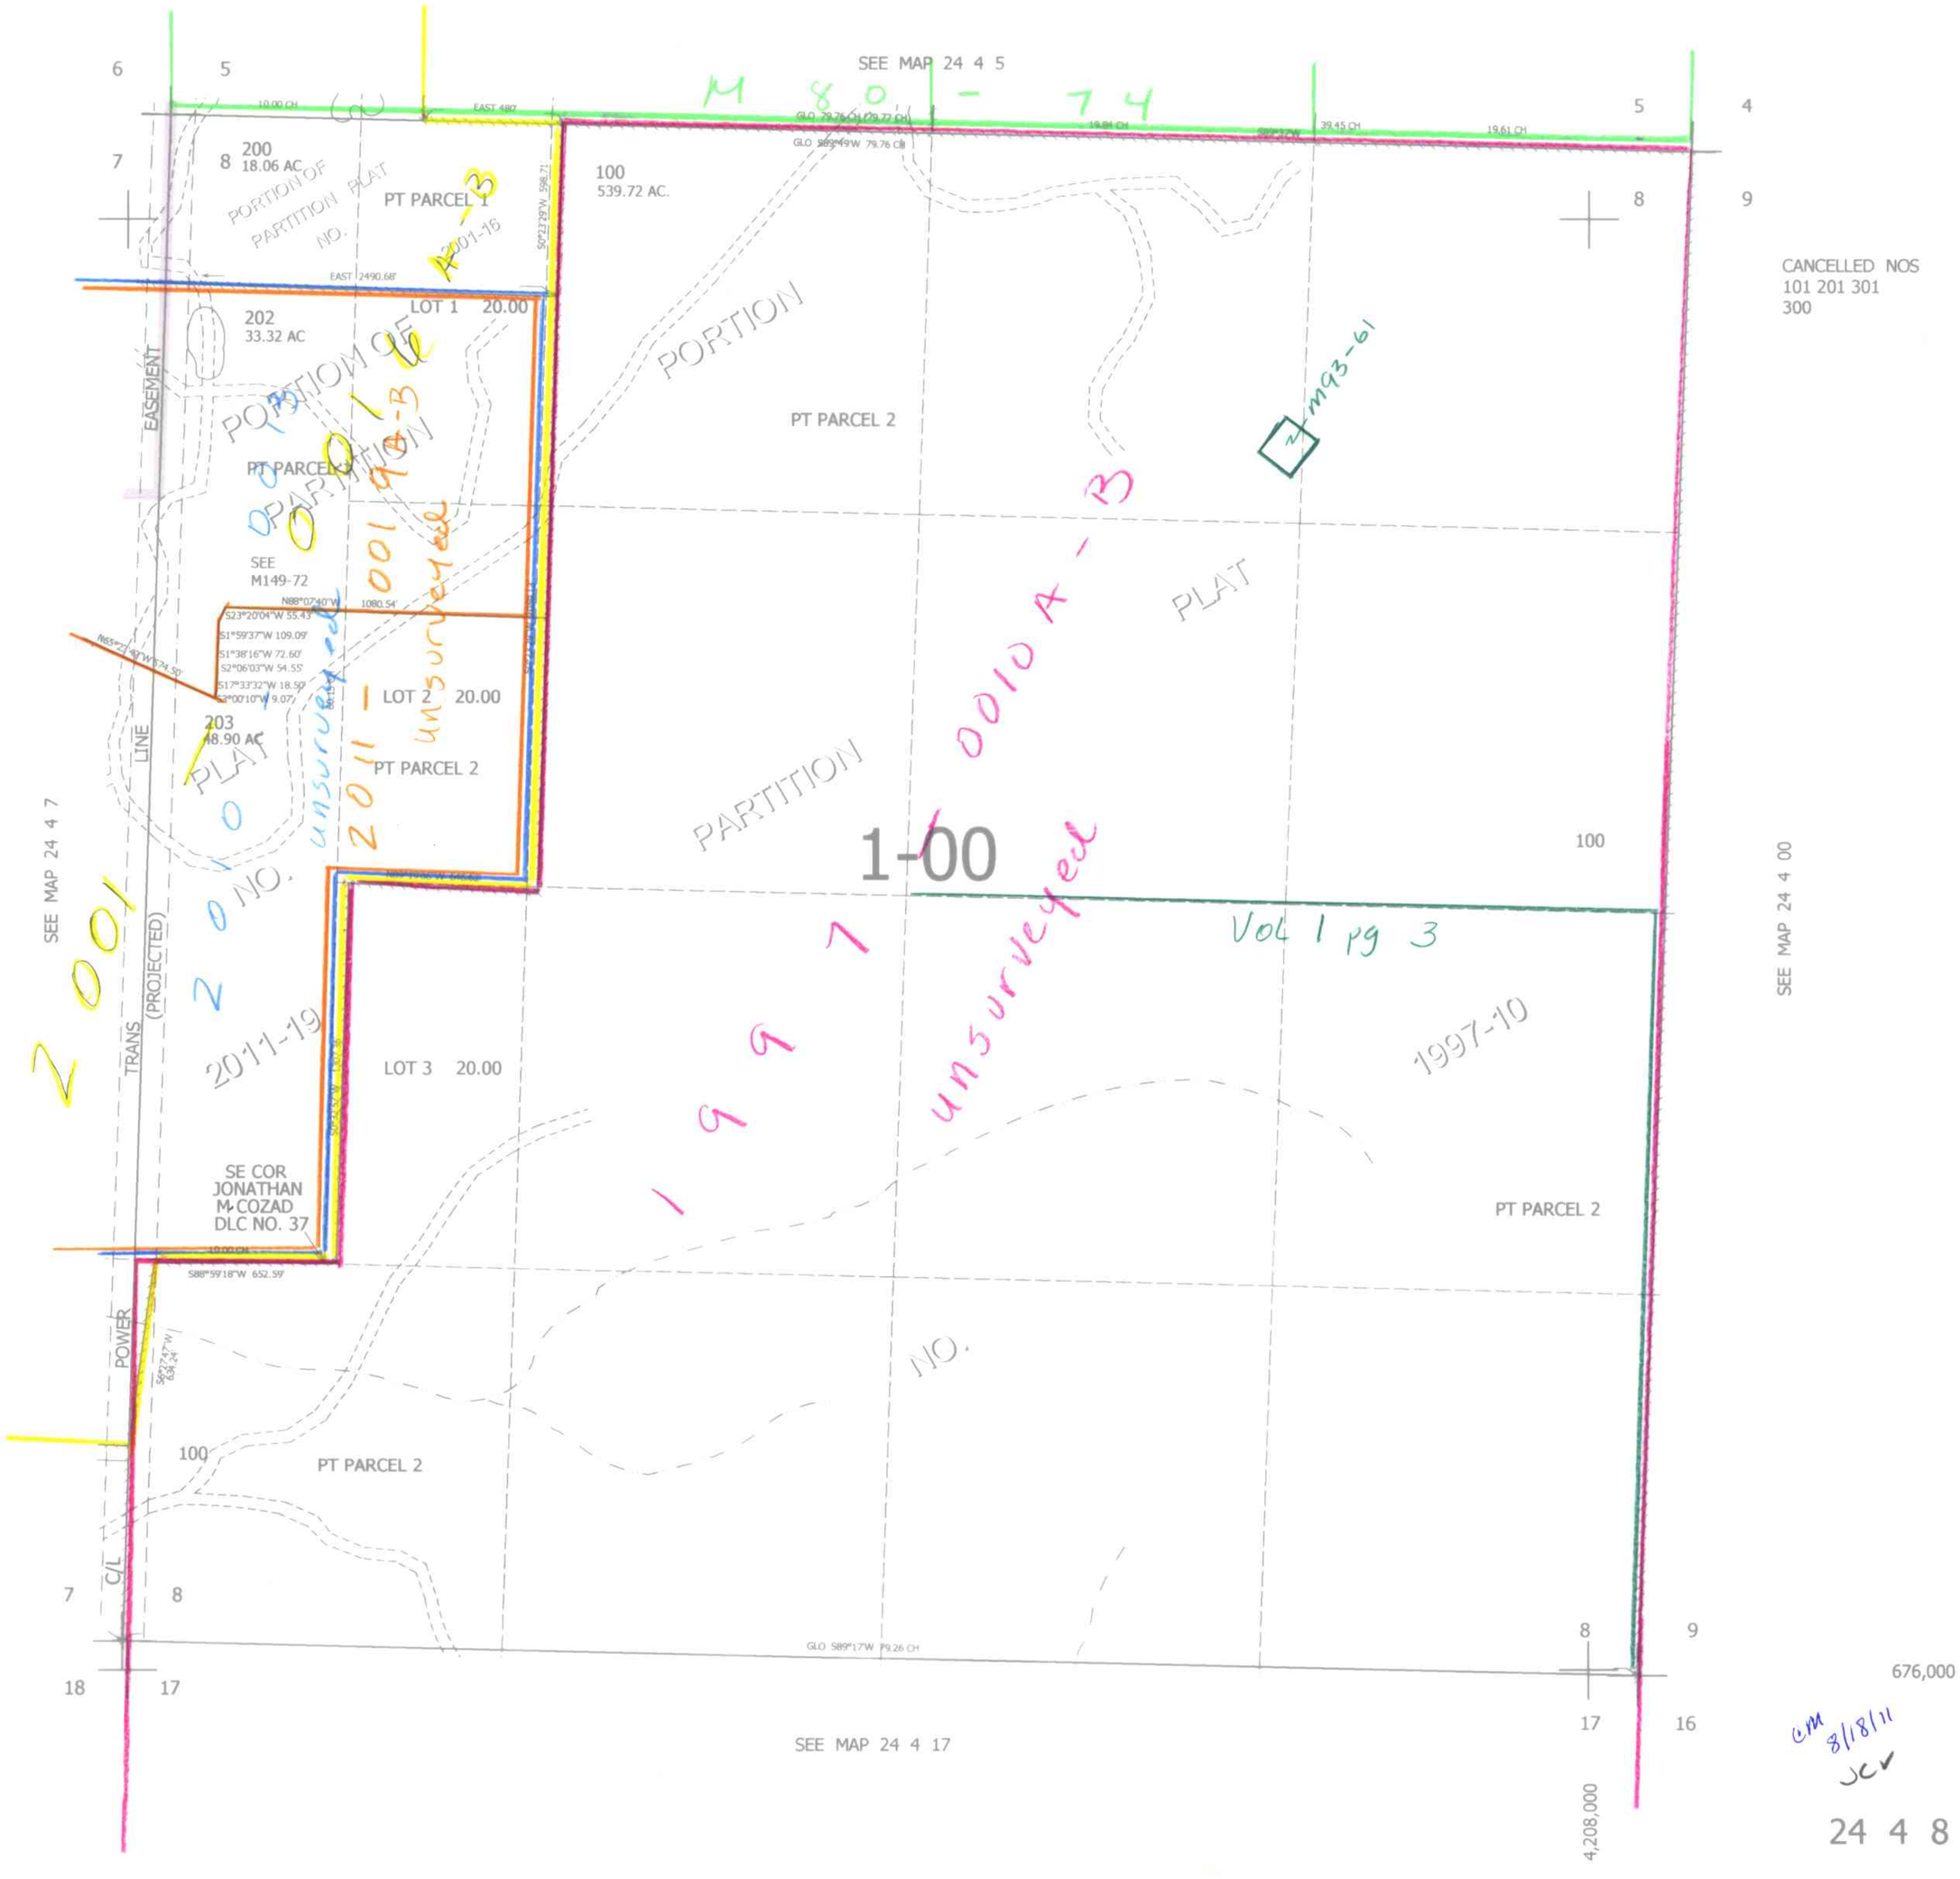
24 4 8