SECTION 33 T.24S. R.4W. W.M.
DOUGLAS COUNTY

1"=400'
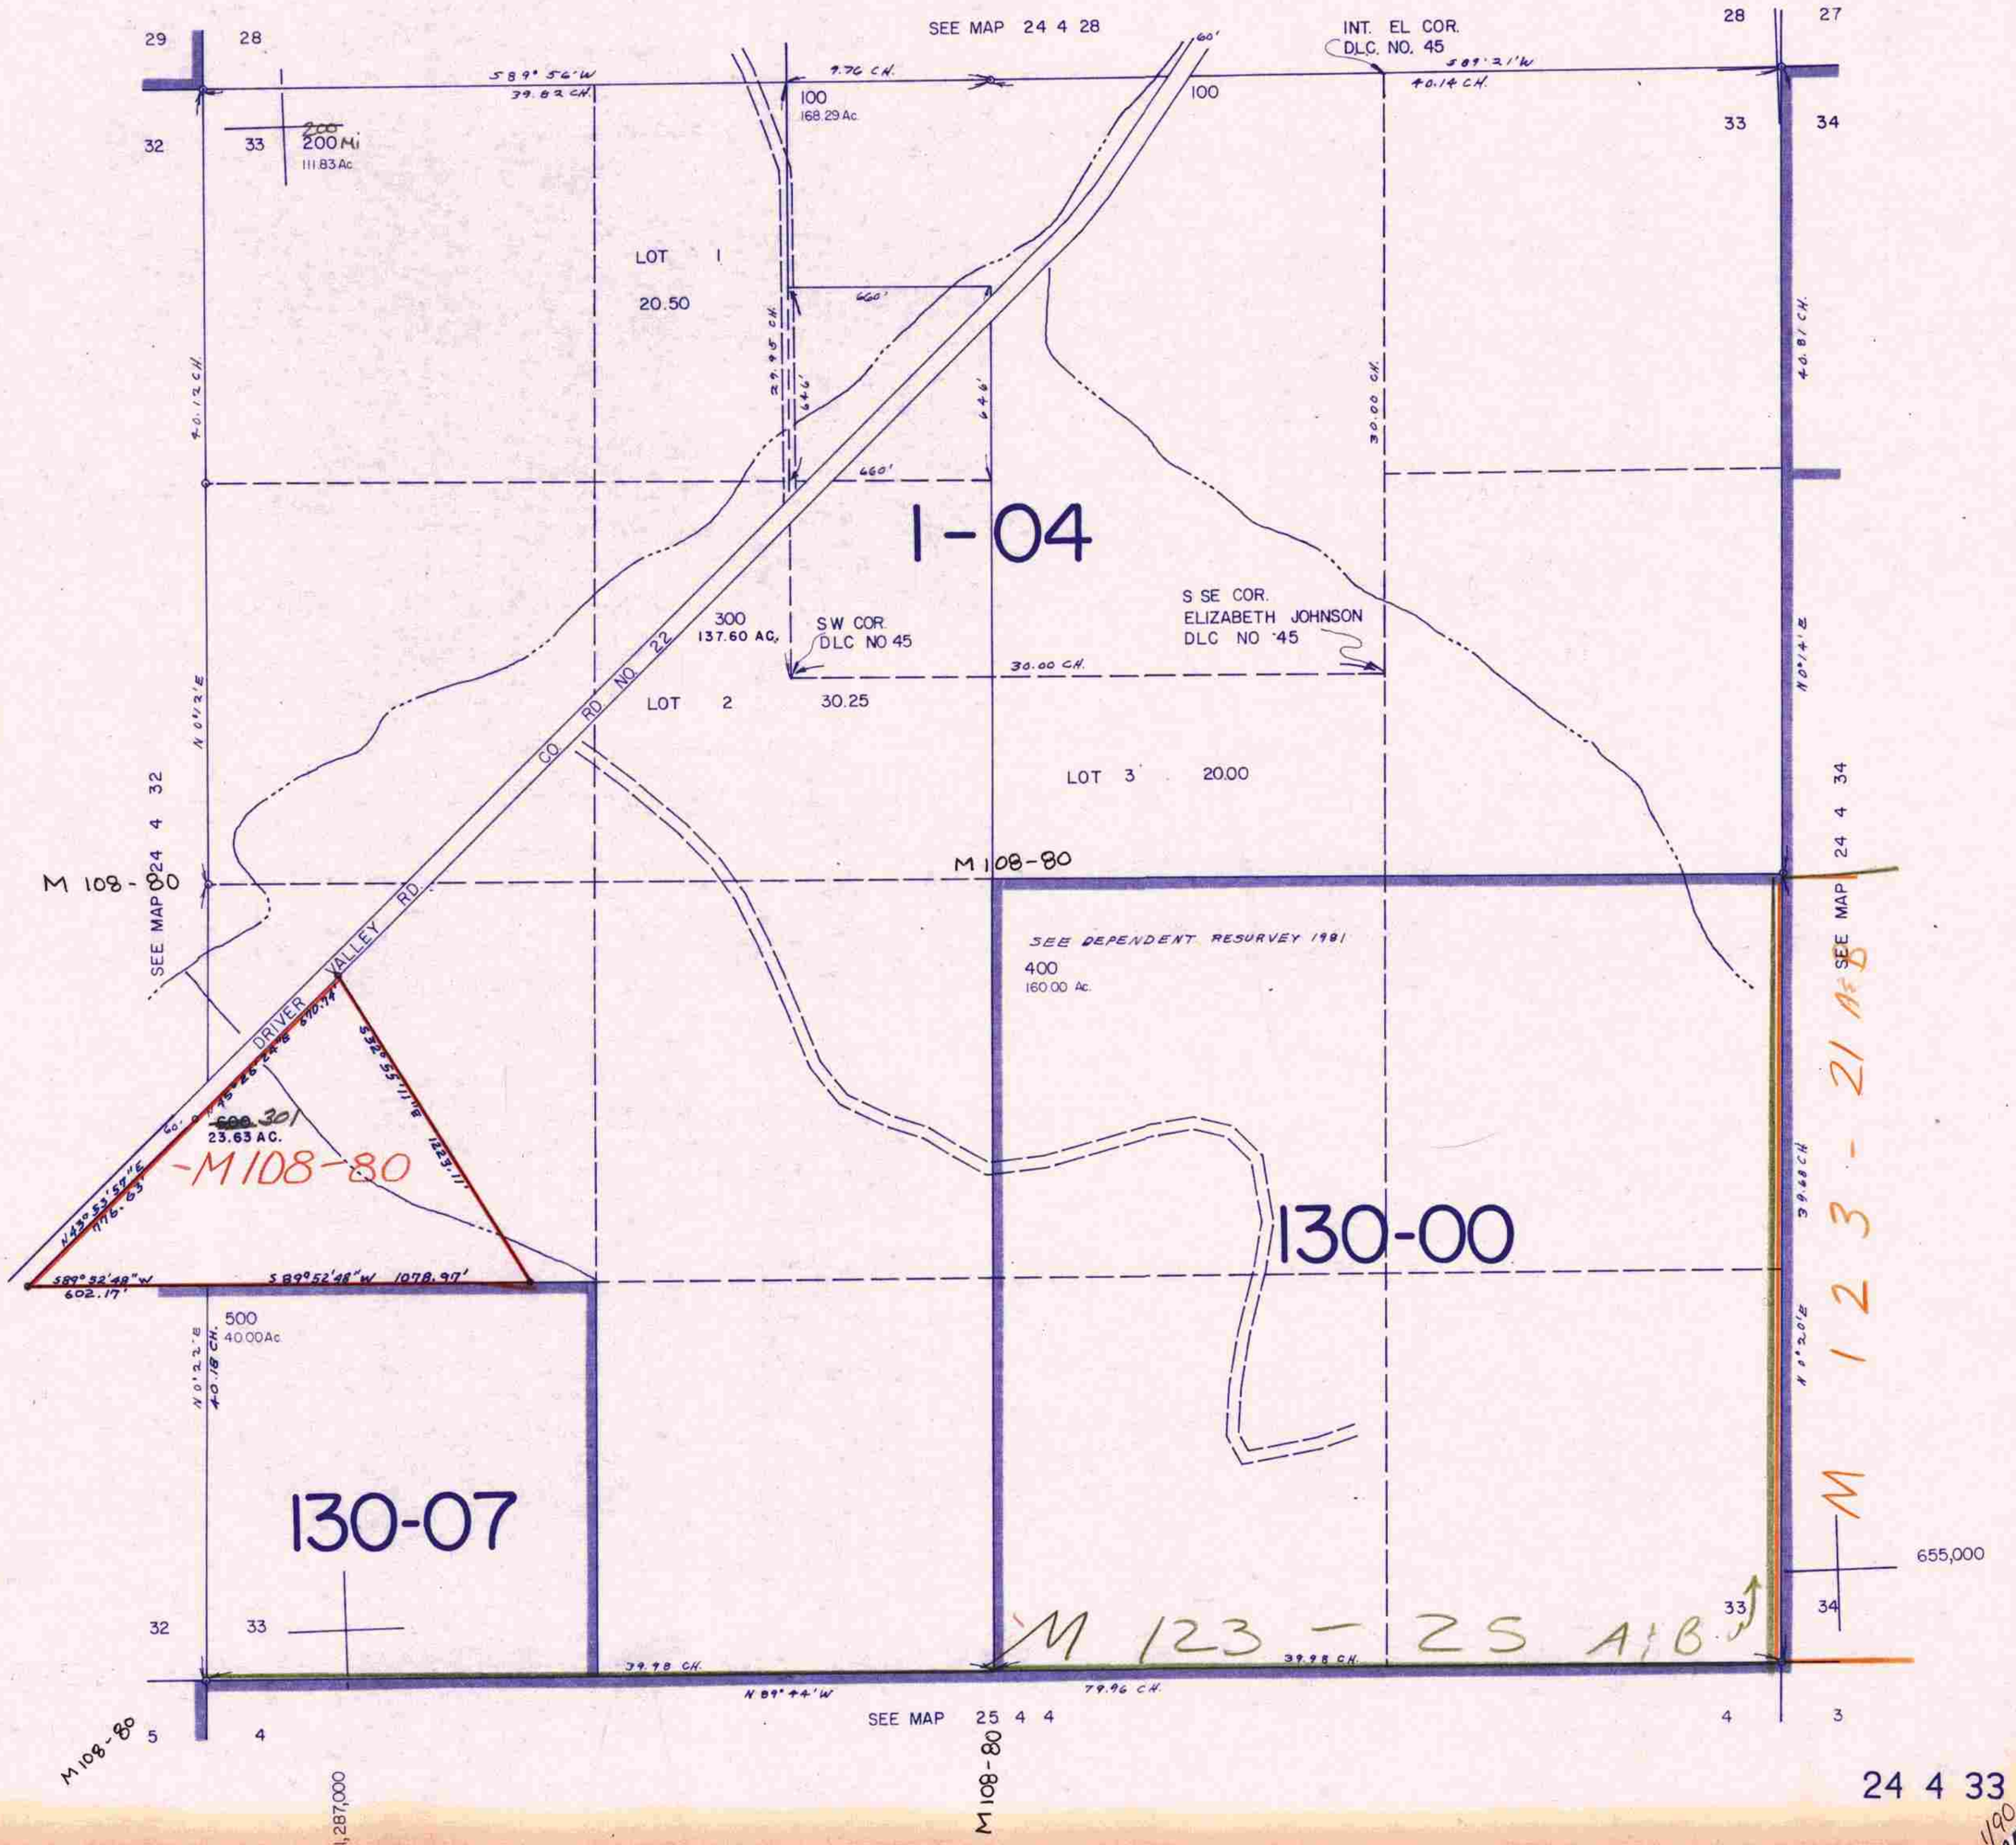
THIS MAP WAS PREPARED FOR ASSESSMENT PURPOSE ONLY.