THIS MAP WAS PREPARED FOR ASSESSMENT PURPOSE ONLY

SEC. 6 T.24S. R.5 W W.M.
DOUGLAS COUNTY

1" = 400'

REVISED ON
10-4-00
2-24-04

24 5 6

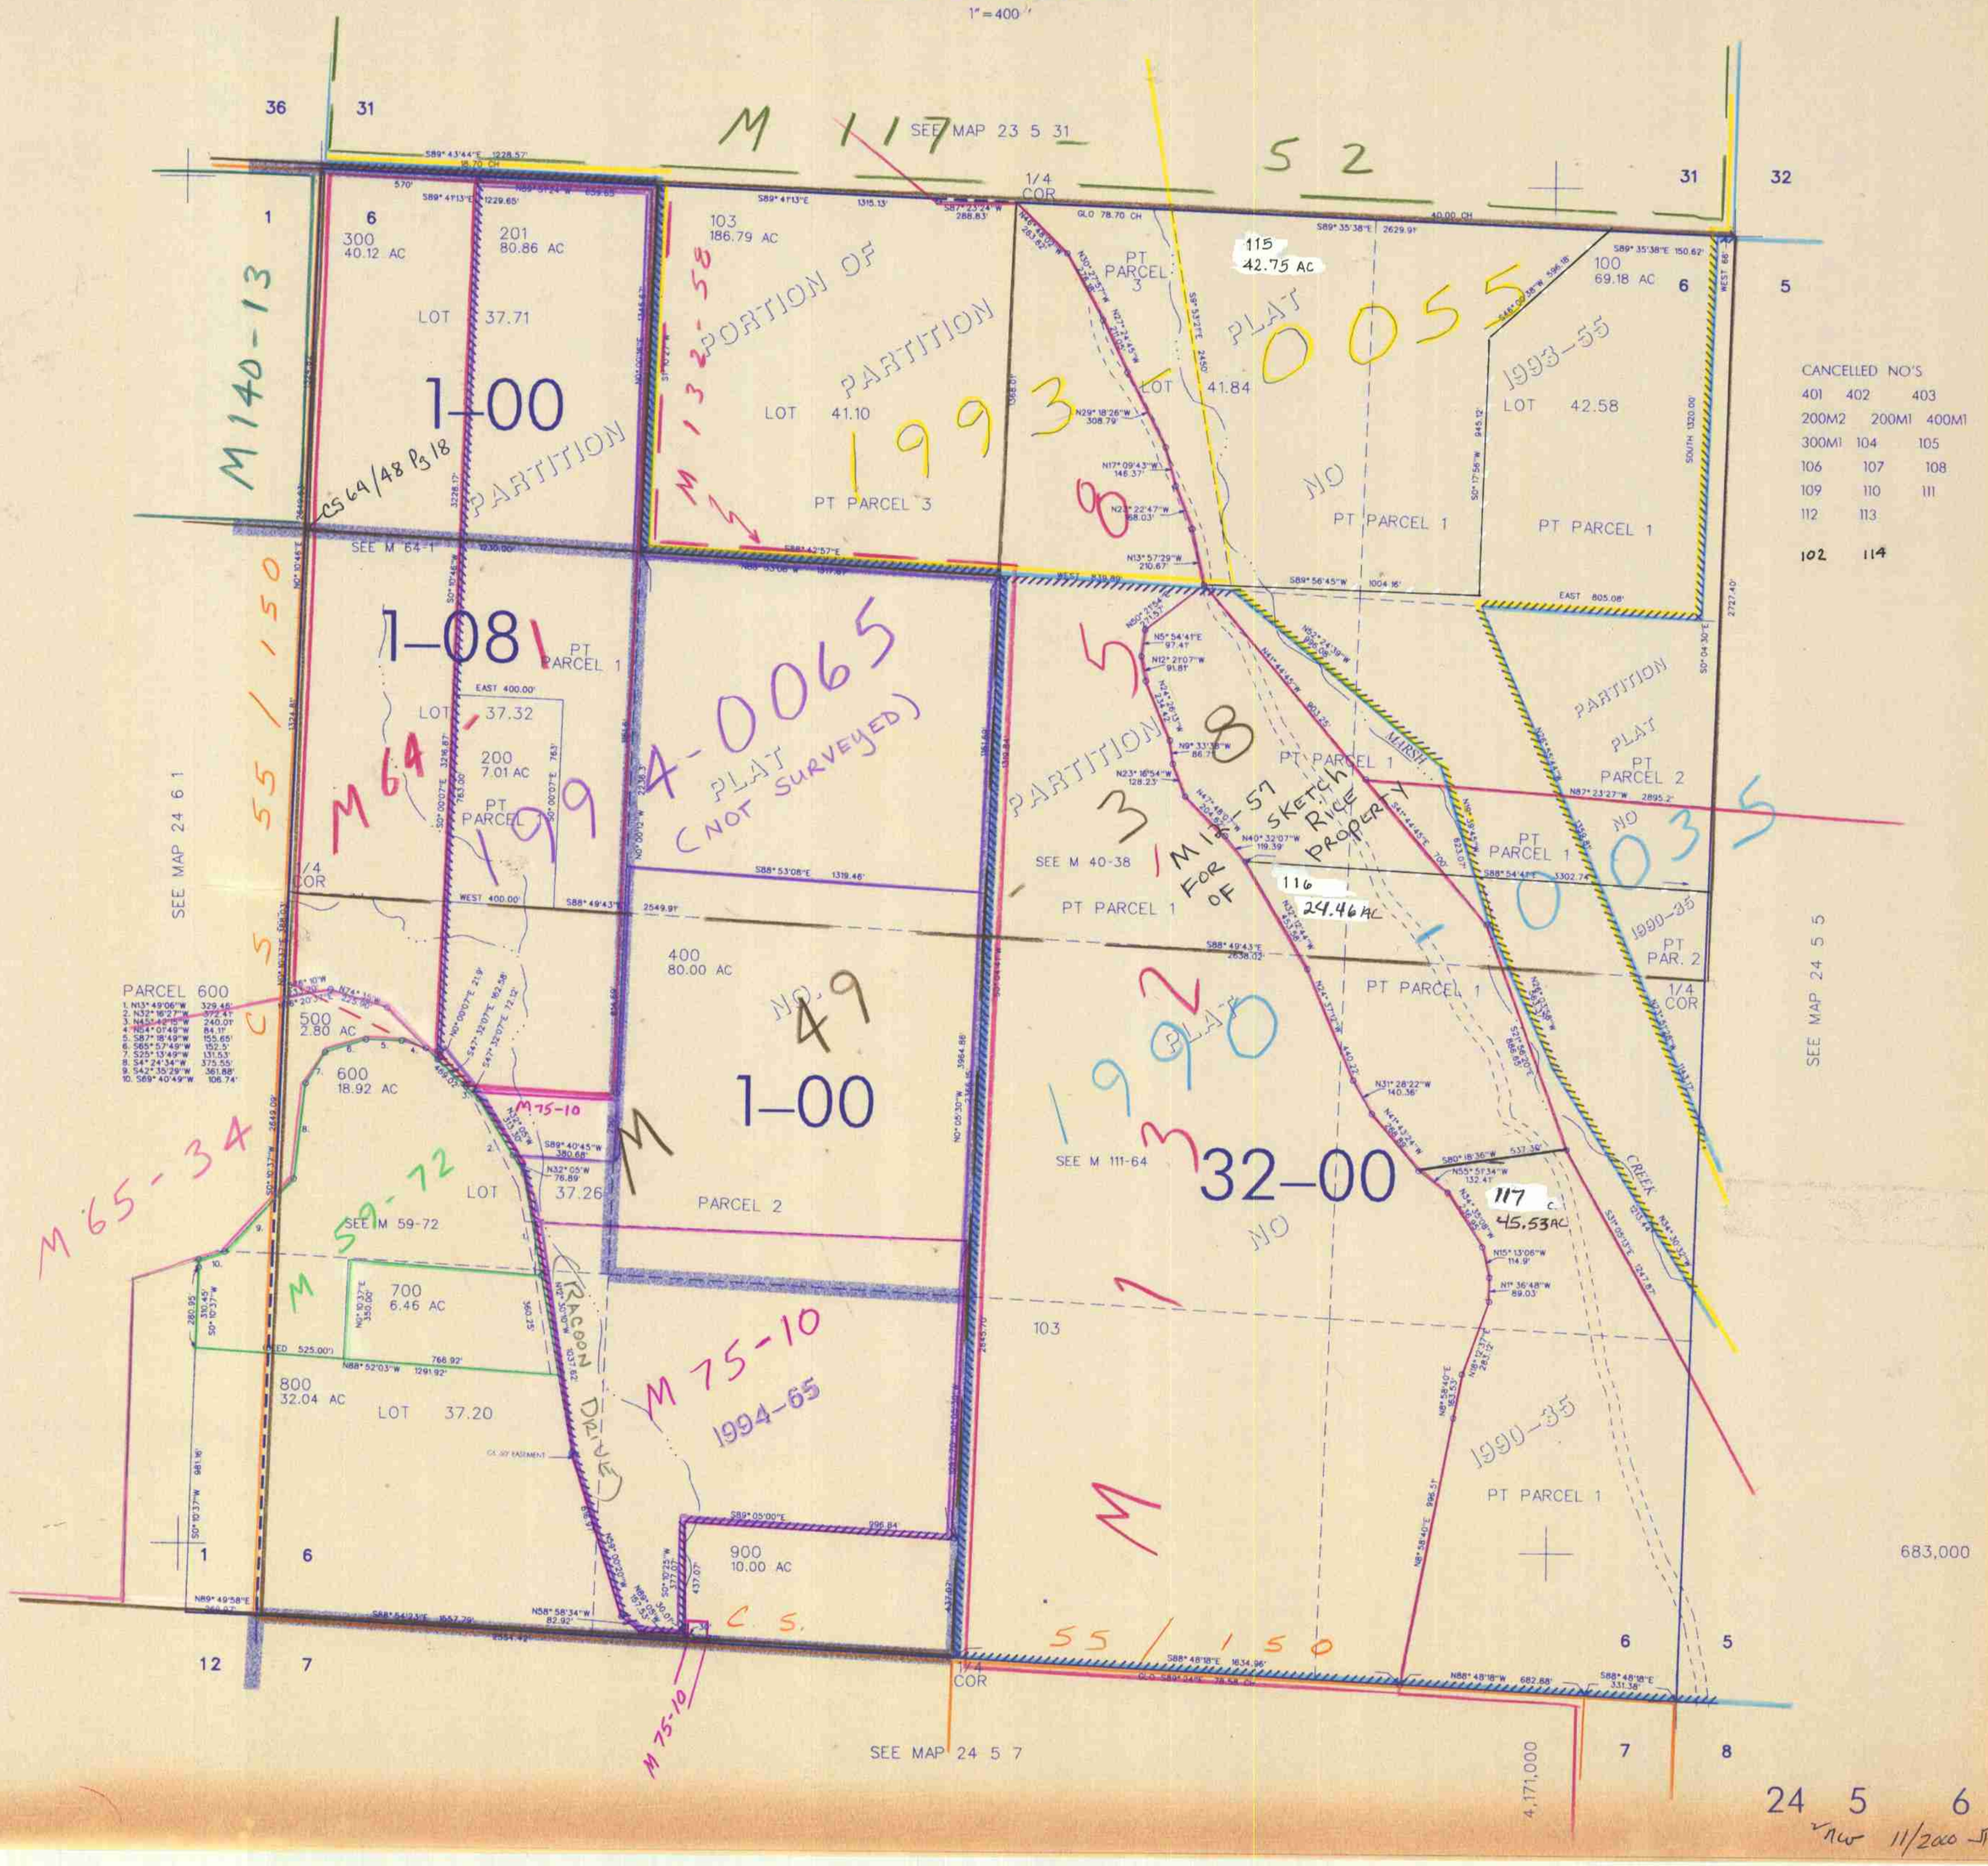

24 5 6

rev 11/2000 JP