THIS MAP WAS PREPARED FOR ASSESSMENT PURPOSE ONLY

# SEC. 28 T.24S. R. 5W W.M.
# DOUGLAS COUNTY

1" = 400'

REVISED ON 2-8-99

24 5 28

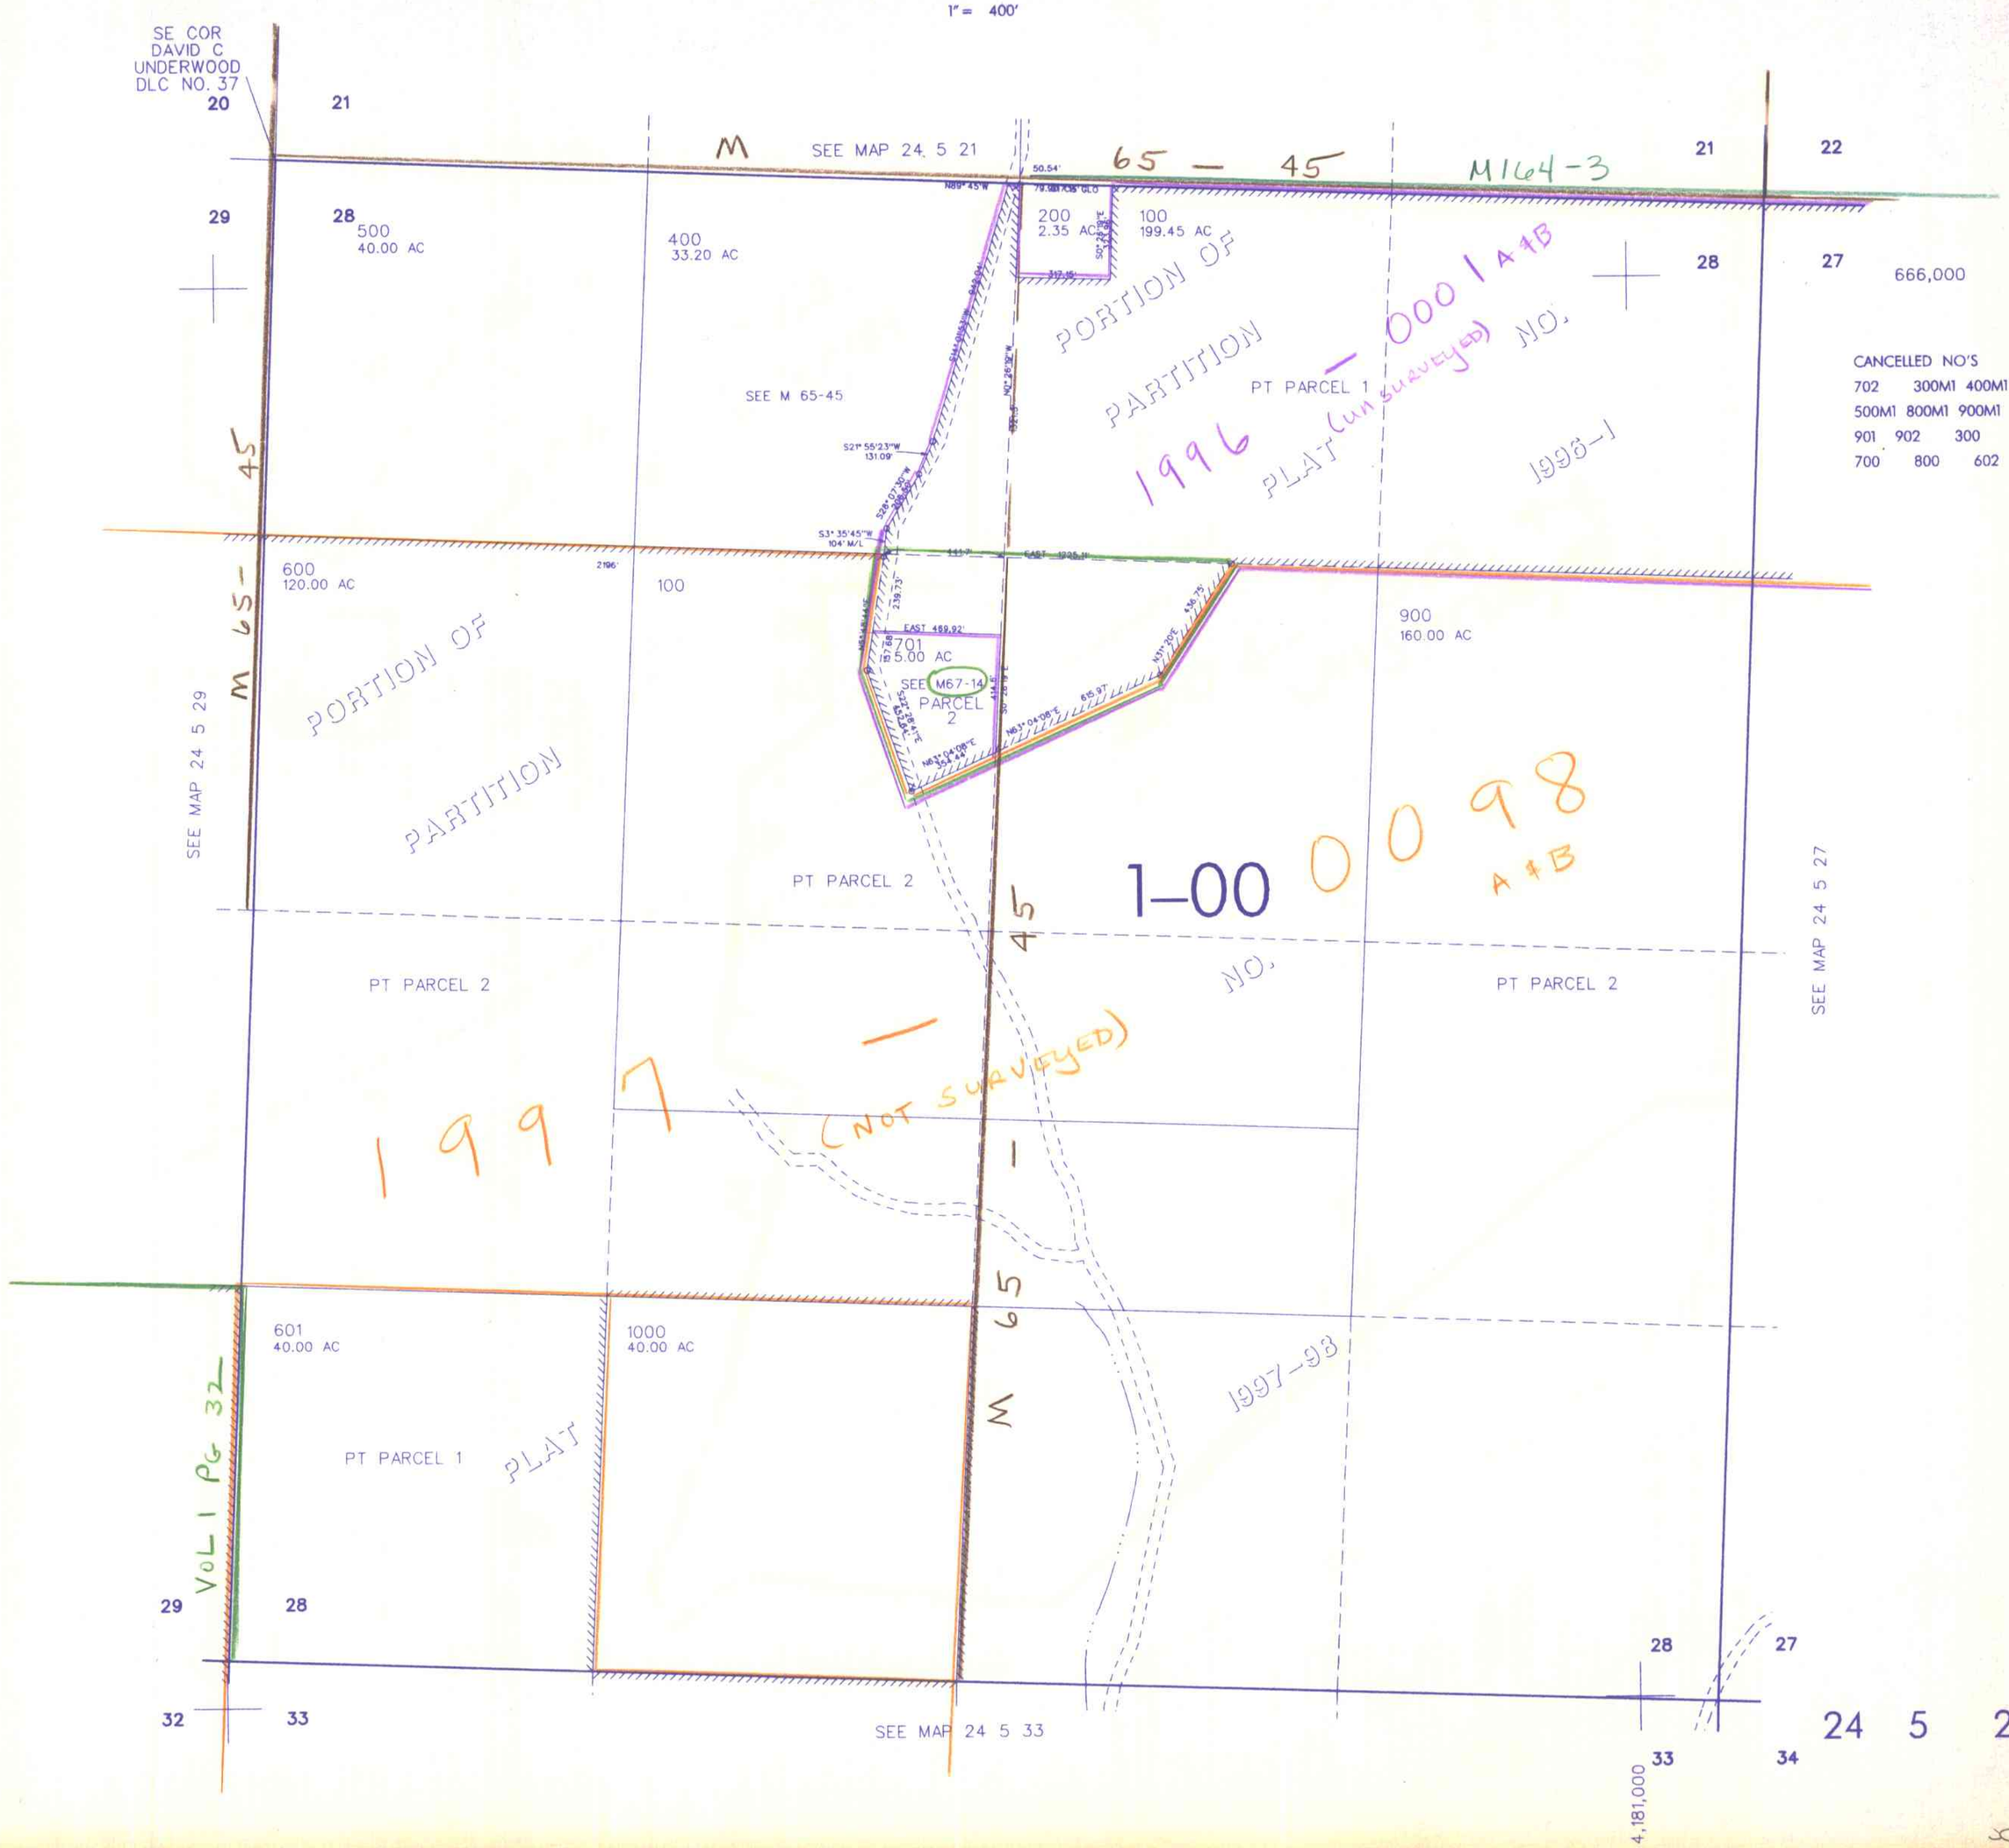


nw 3/99