SECTION 30 T.24S. R.5W. W.M.
DOUGLAS COUNTY

1"=400'

THIS MAP WAS PREPARED FOR ASSESSMENT PURPOSE ONLY.
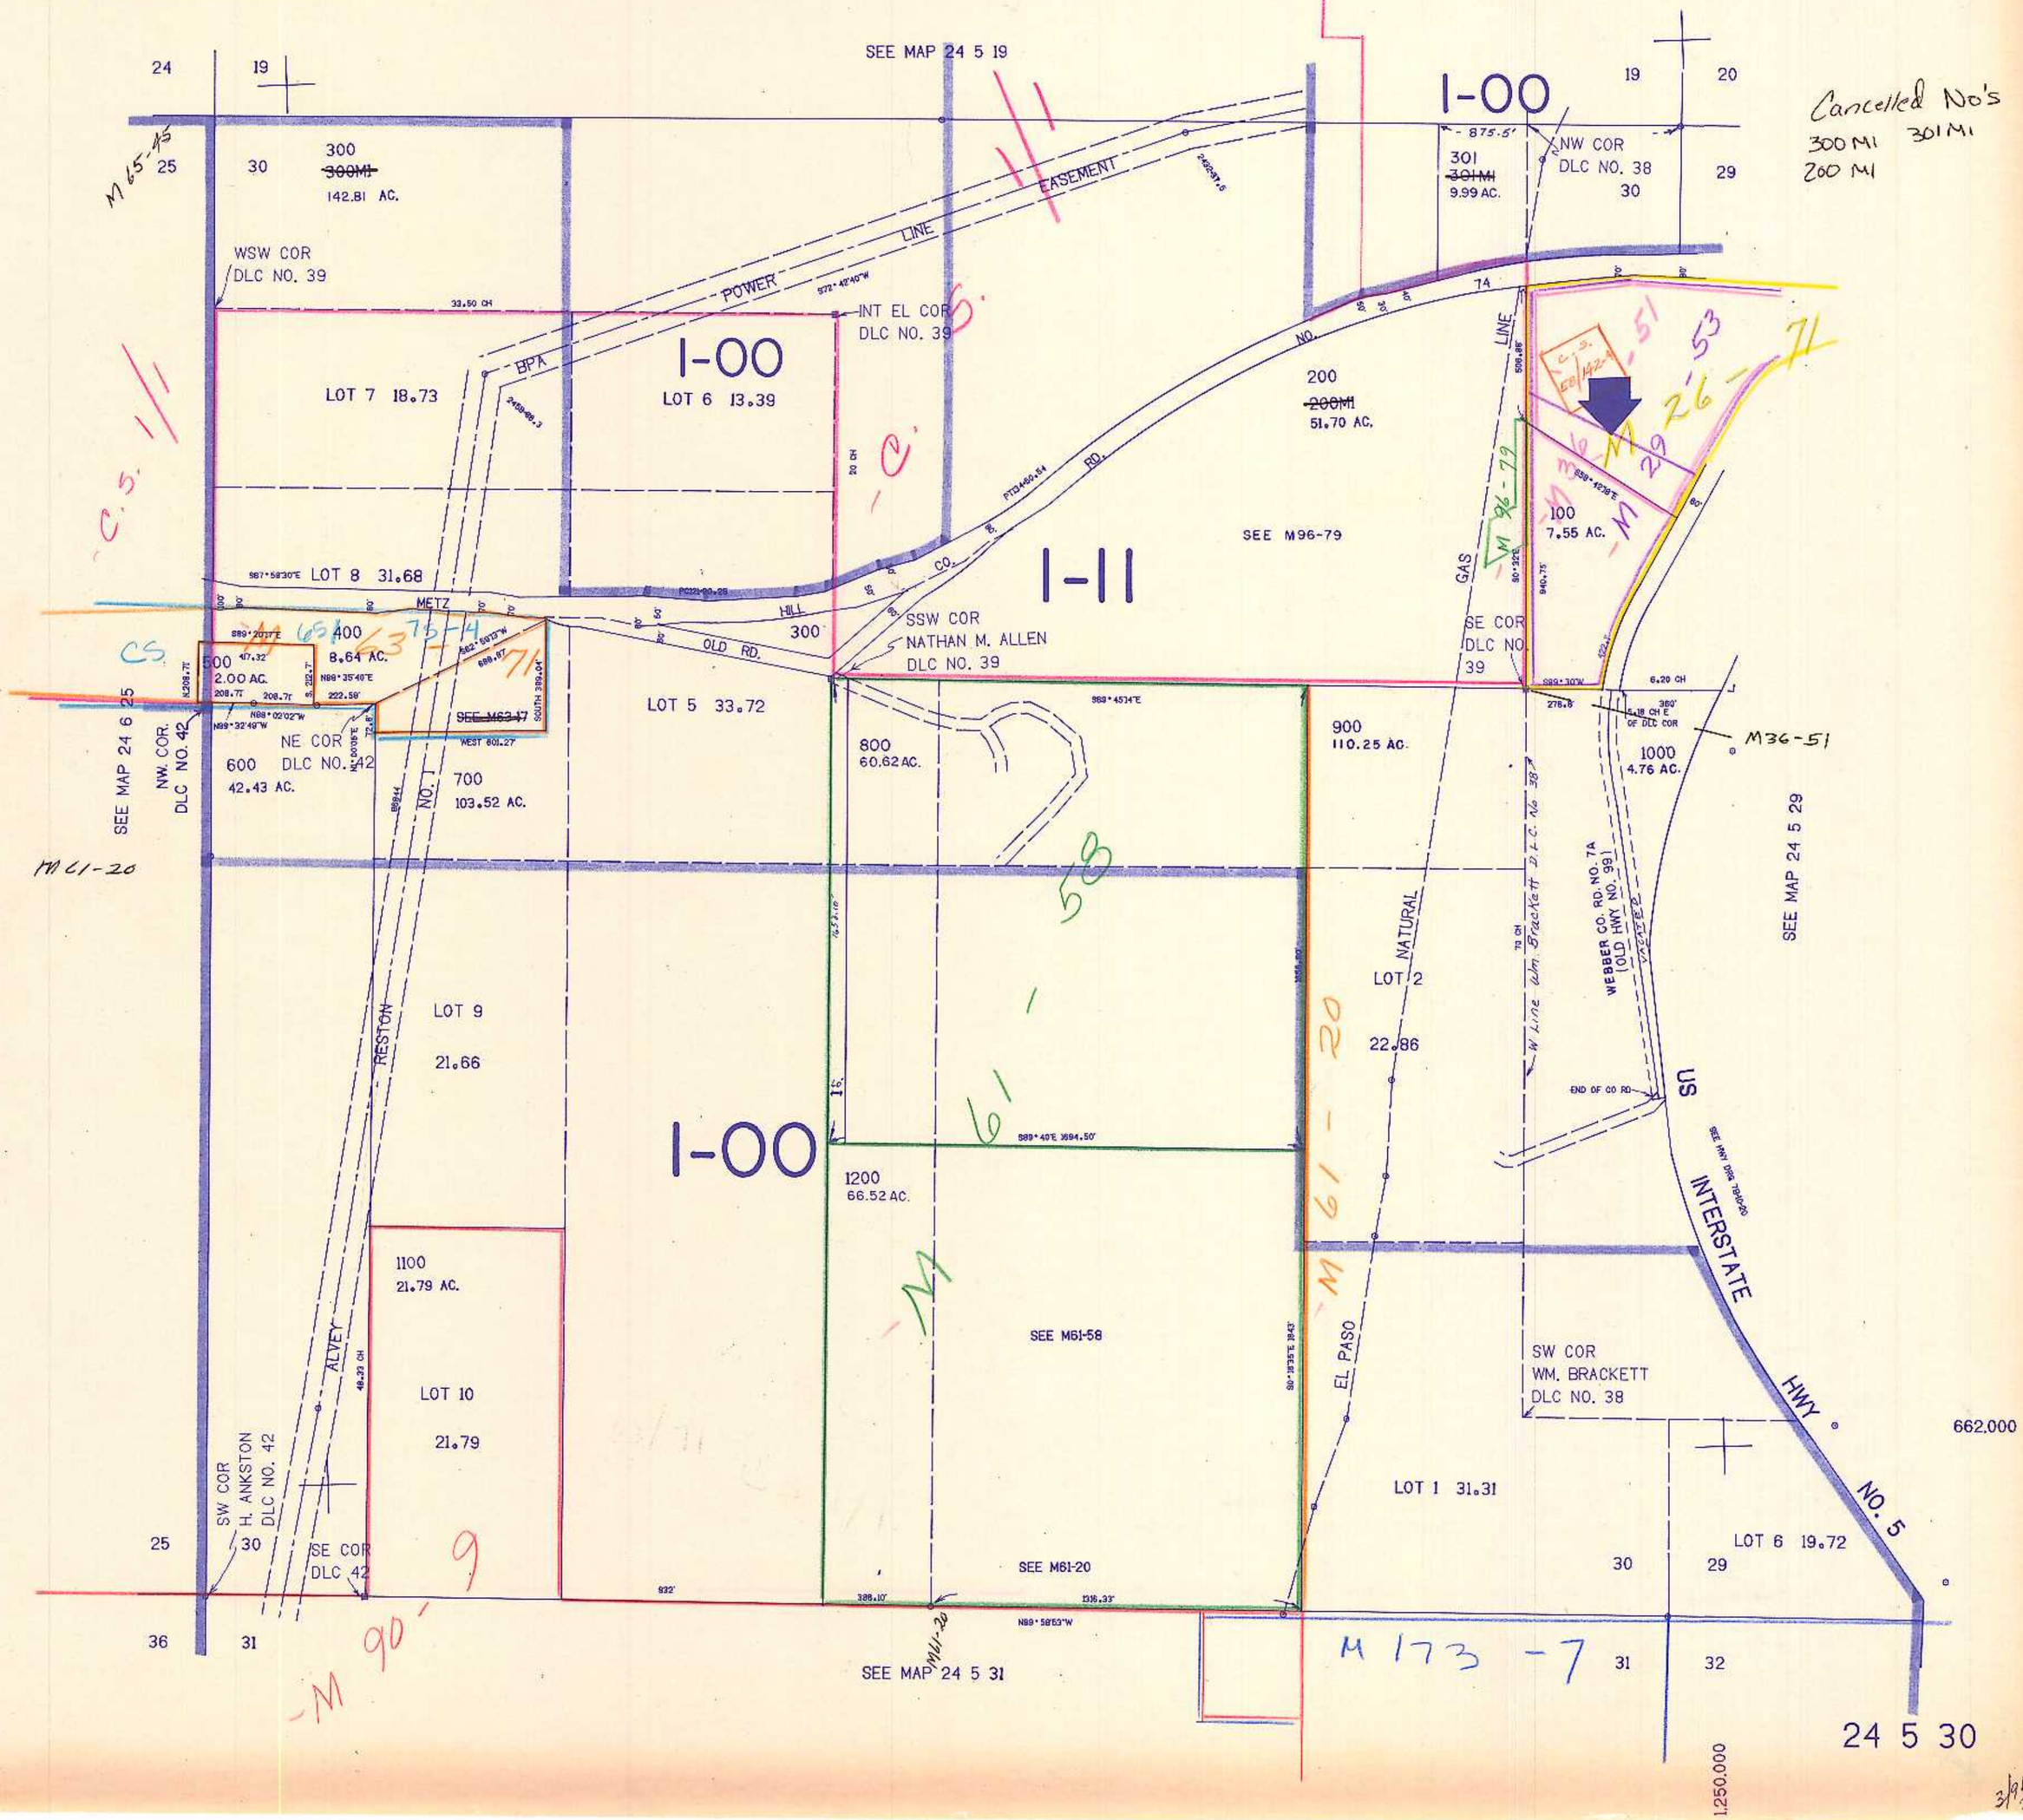
Cancelled No's
300 M1 301 M1
200 M1