


SECTION 25 T.24S. R.6W. W.M.
DOUGLAS COUNTY

24 6 25

THIS MAP WAS PREPARED FOR
ASSESSMENT PURPOSE ONLY.

1"=400'

SEE MAP 24 6 24

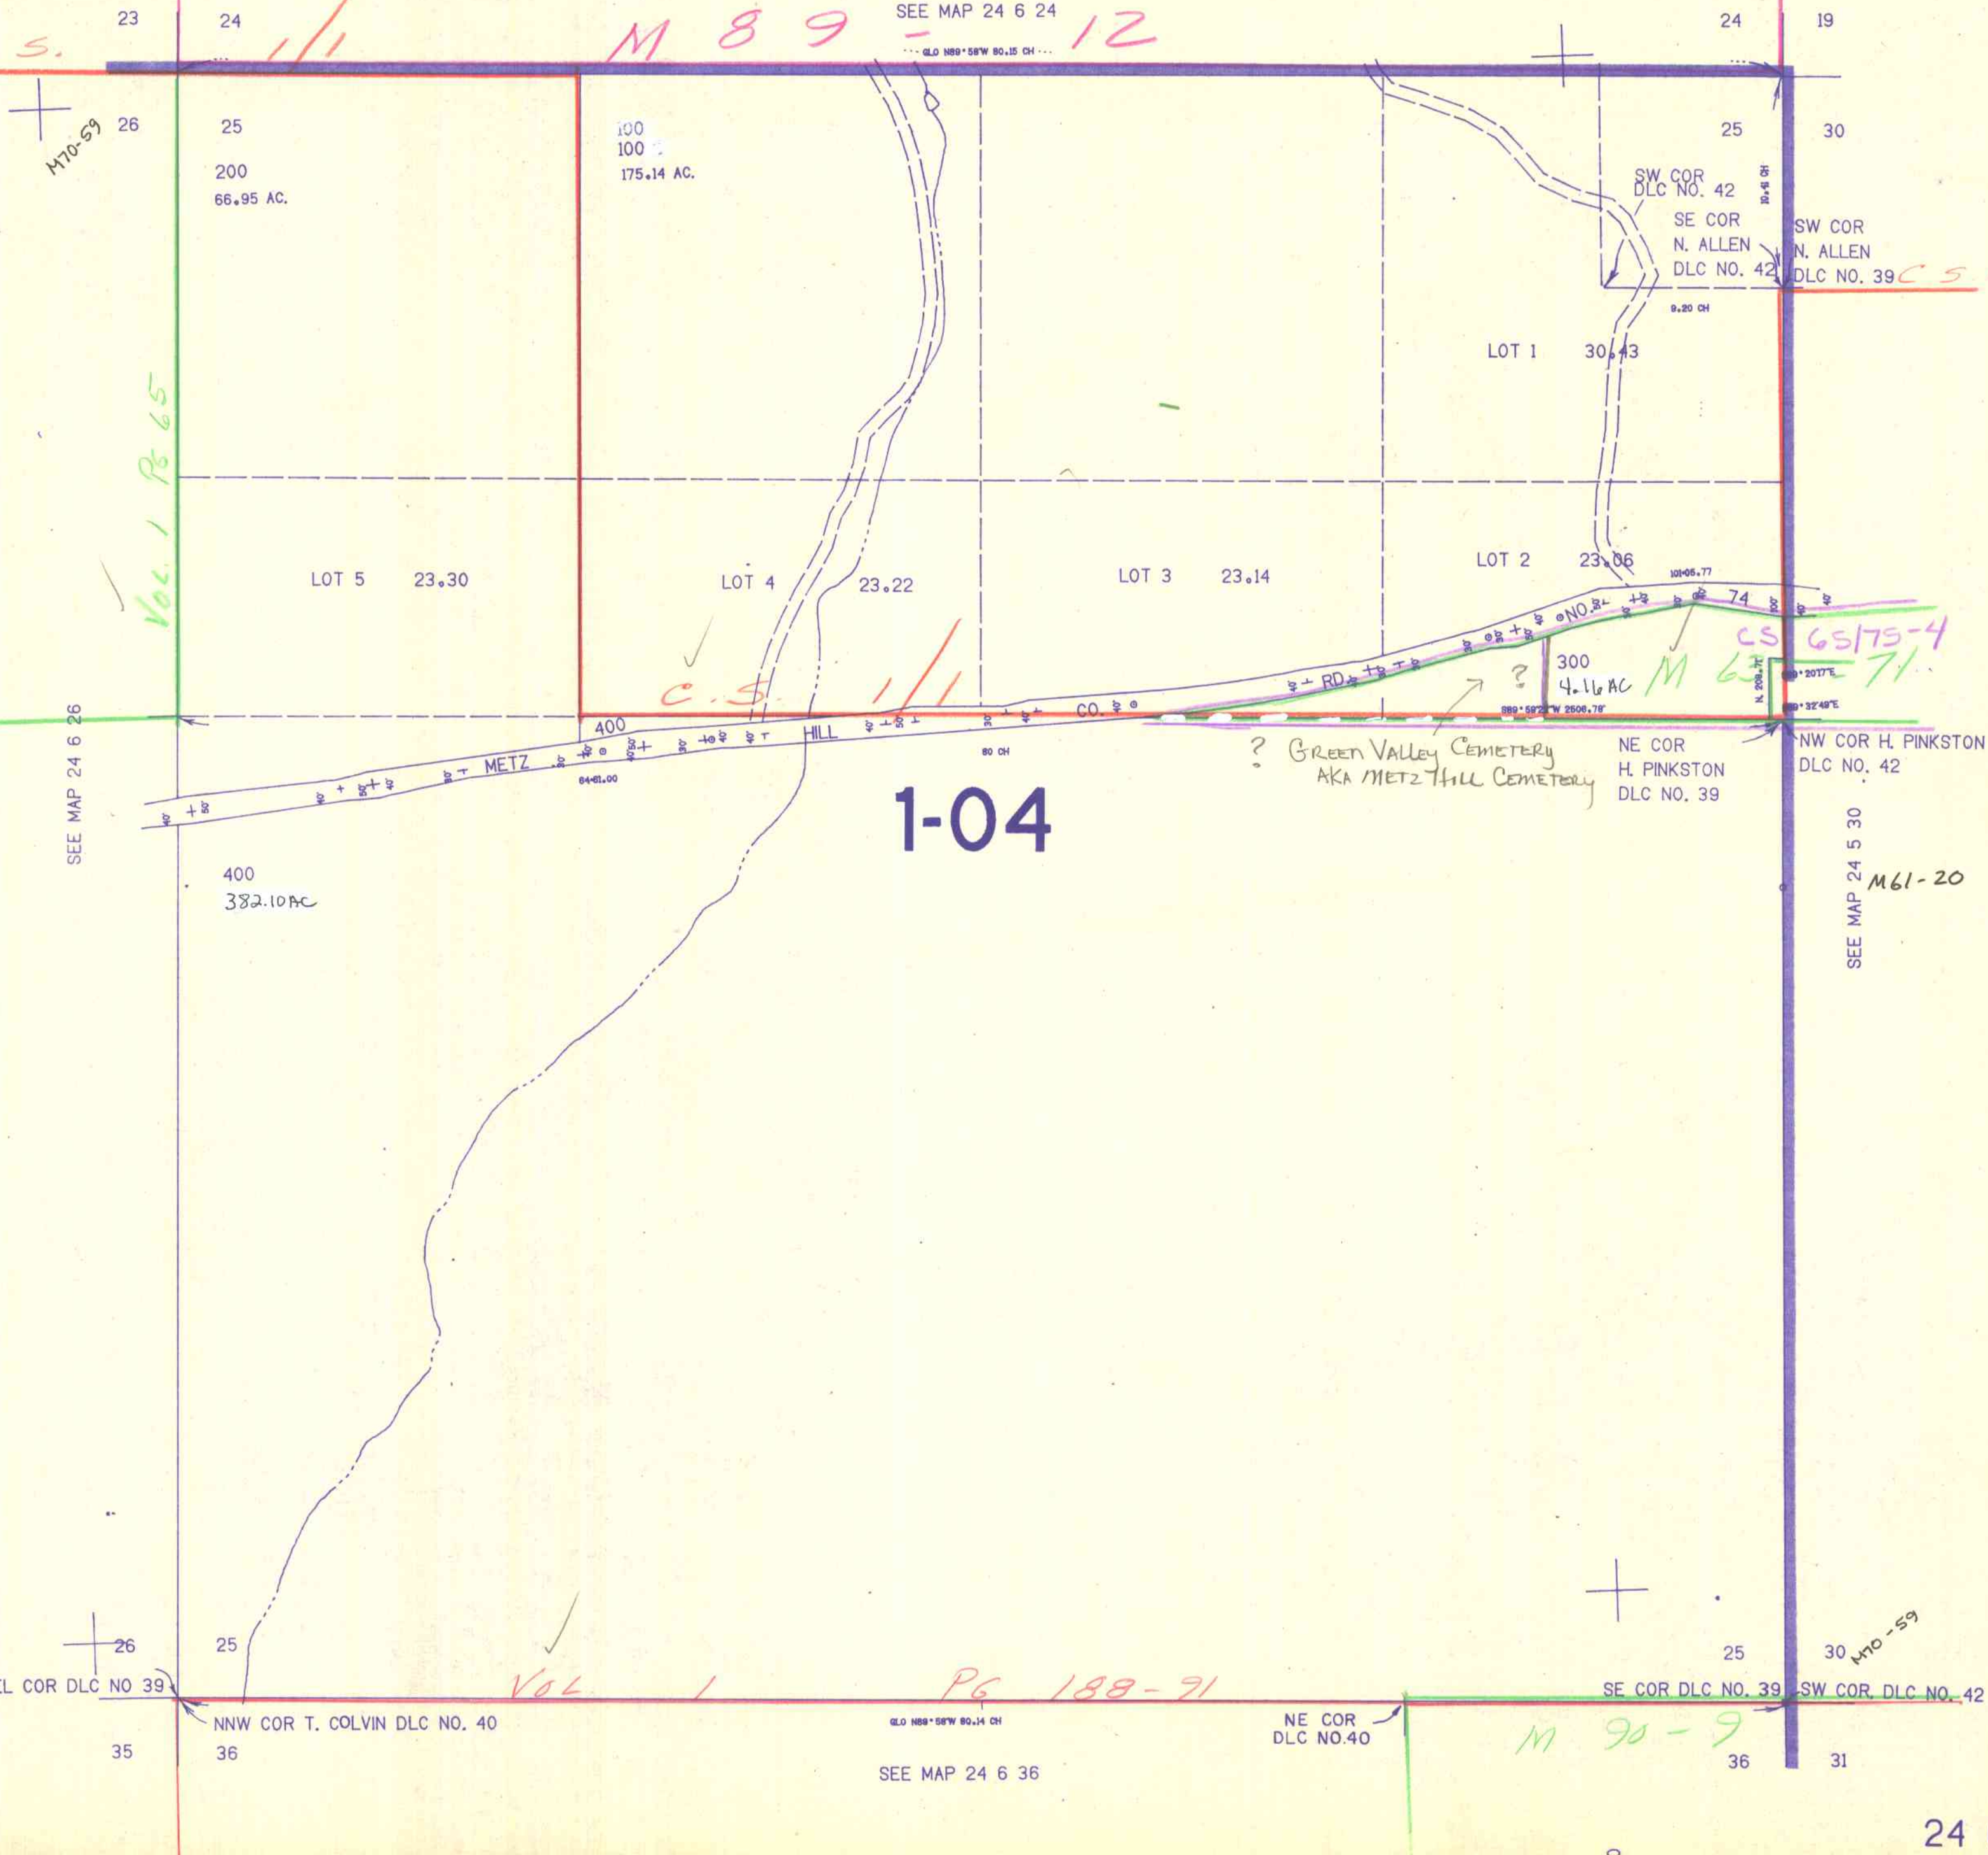

1-04

24 6 25

1244.000

662.000