SECTION 32 T.24S. R.6W. W.M.
DOUGLAS COUNTY

1"=400'
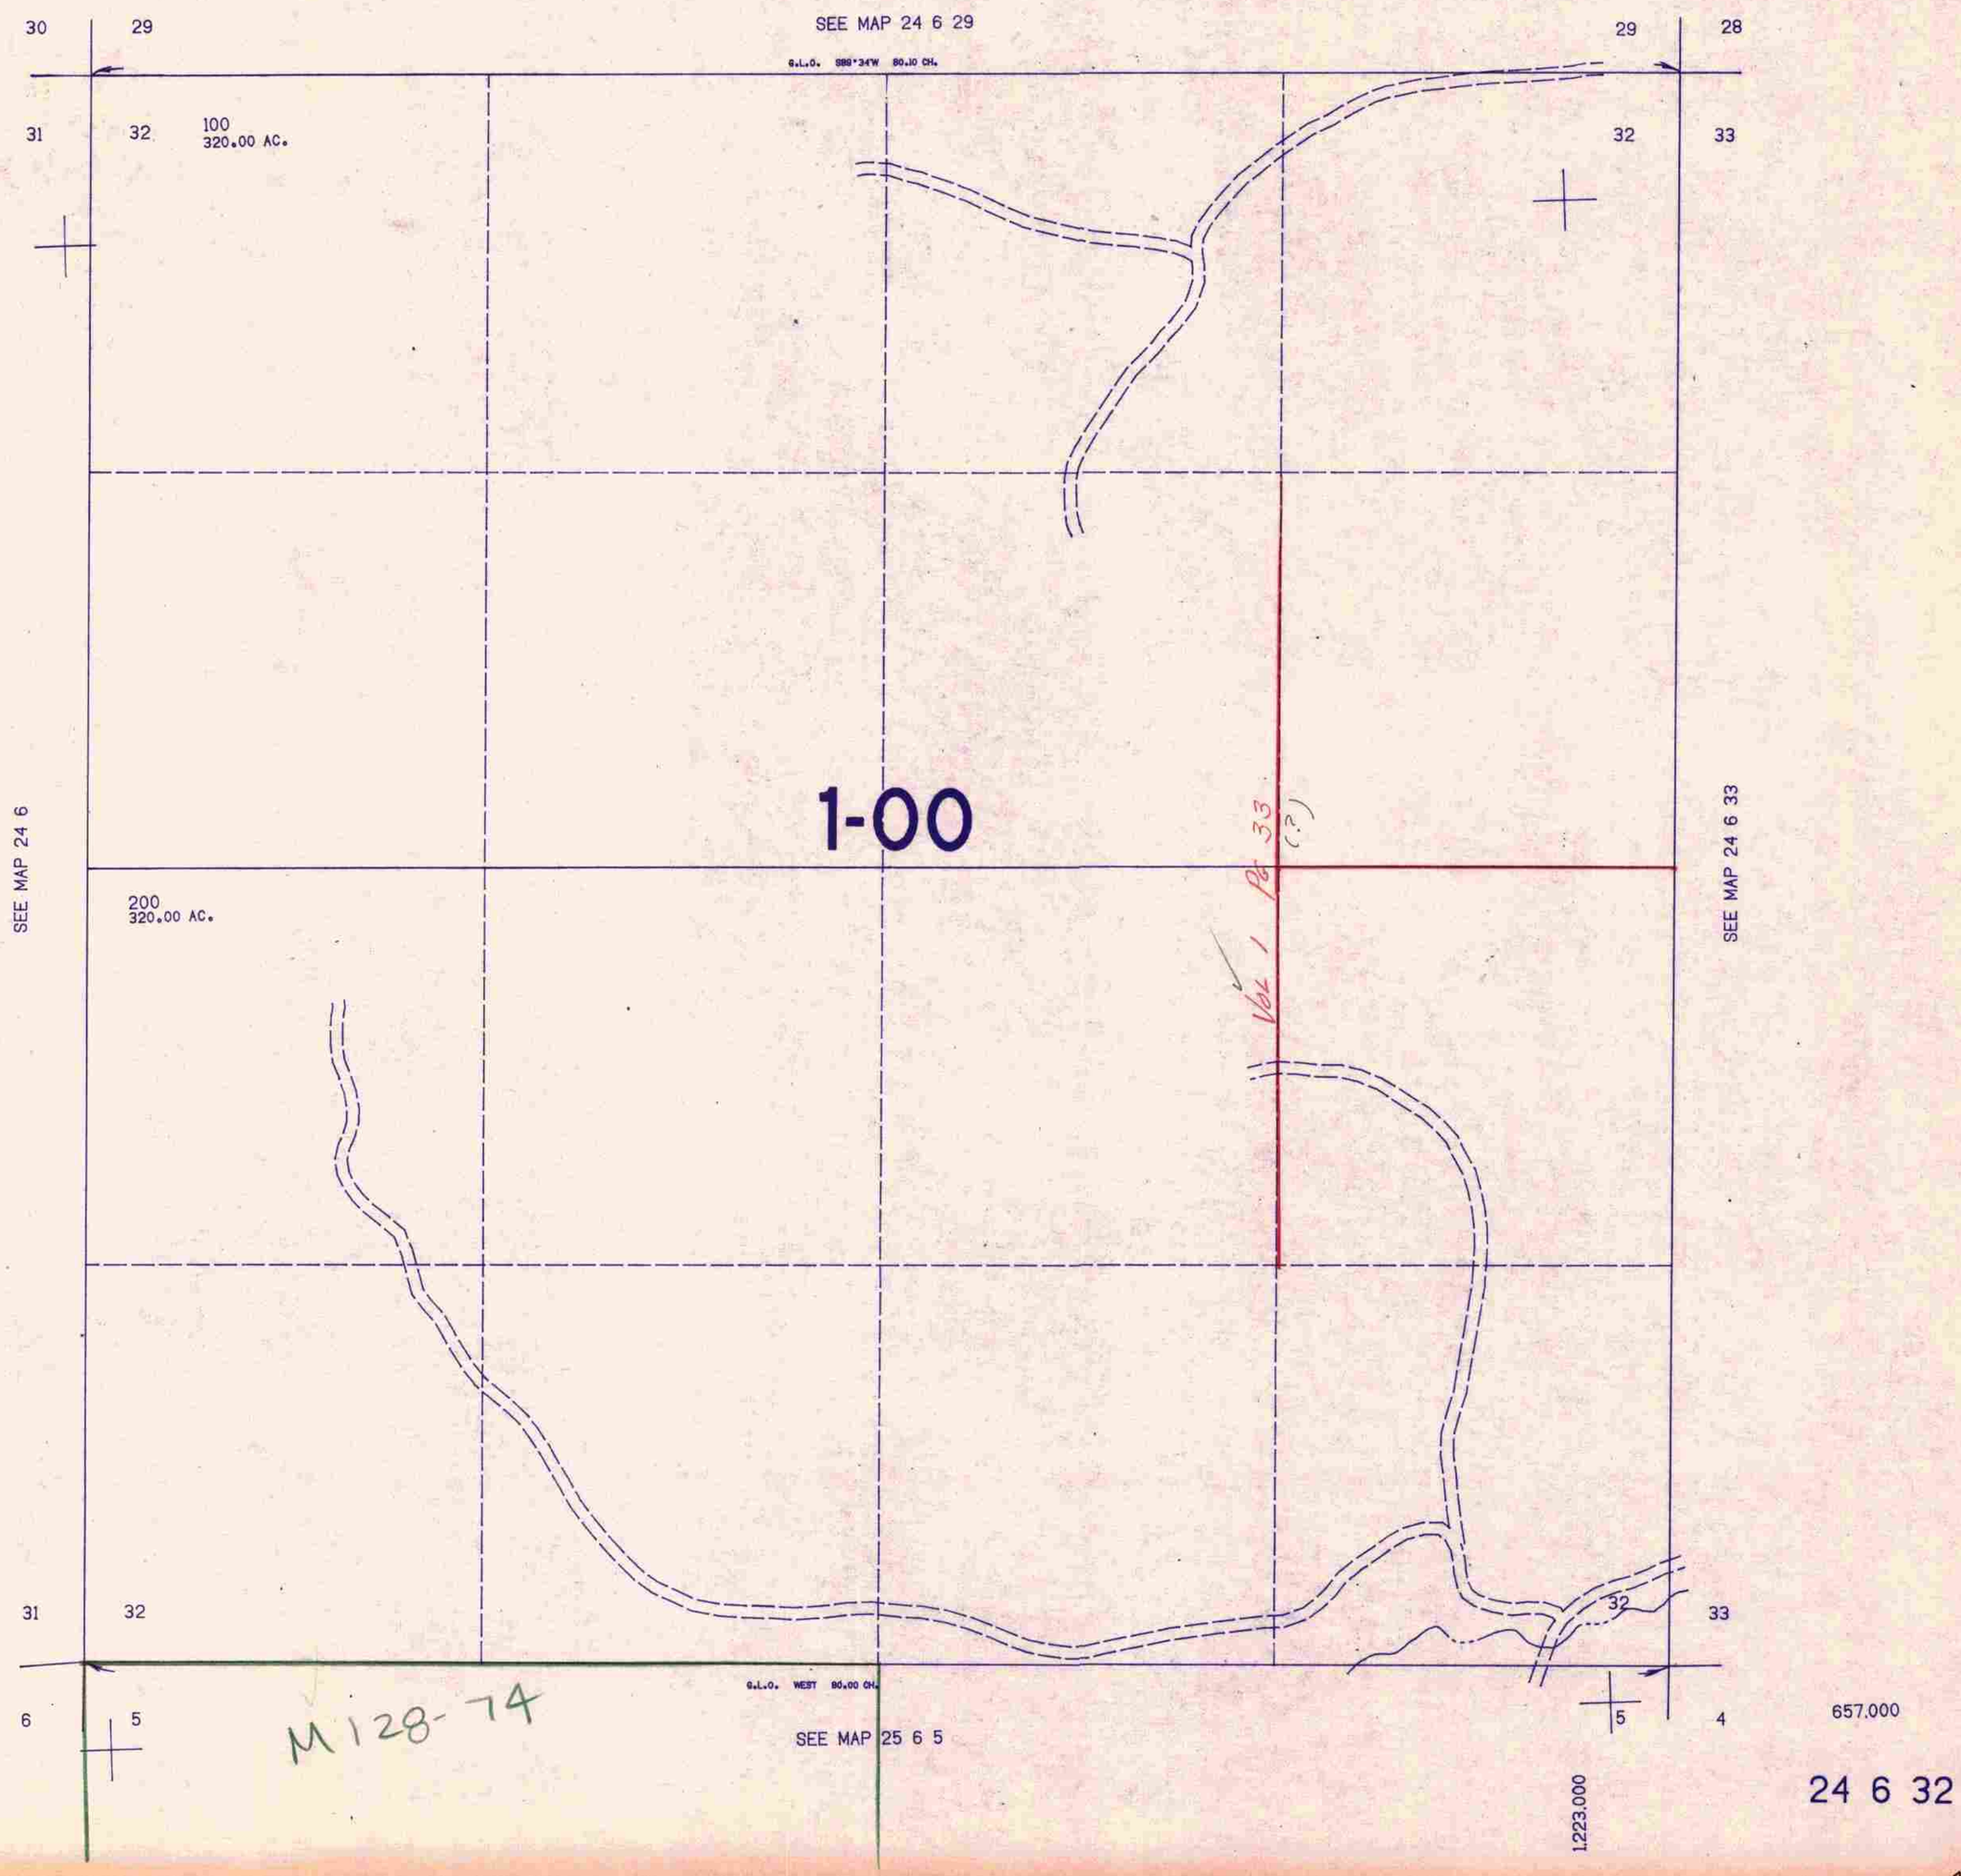
THIS MAP WAS PREPARED FOR ASSESSMENT PURPOSE ONLY.