THIS MAP WAS PREPARED FOR ASSESSMENT PURPOSE ONLY.

SECTION 8 T.27S. R.6W. W.M.
DOUGLAS COUNTY

1"=400'

REVISED ON 4-23-97
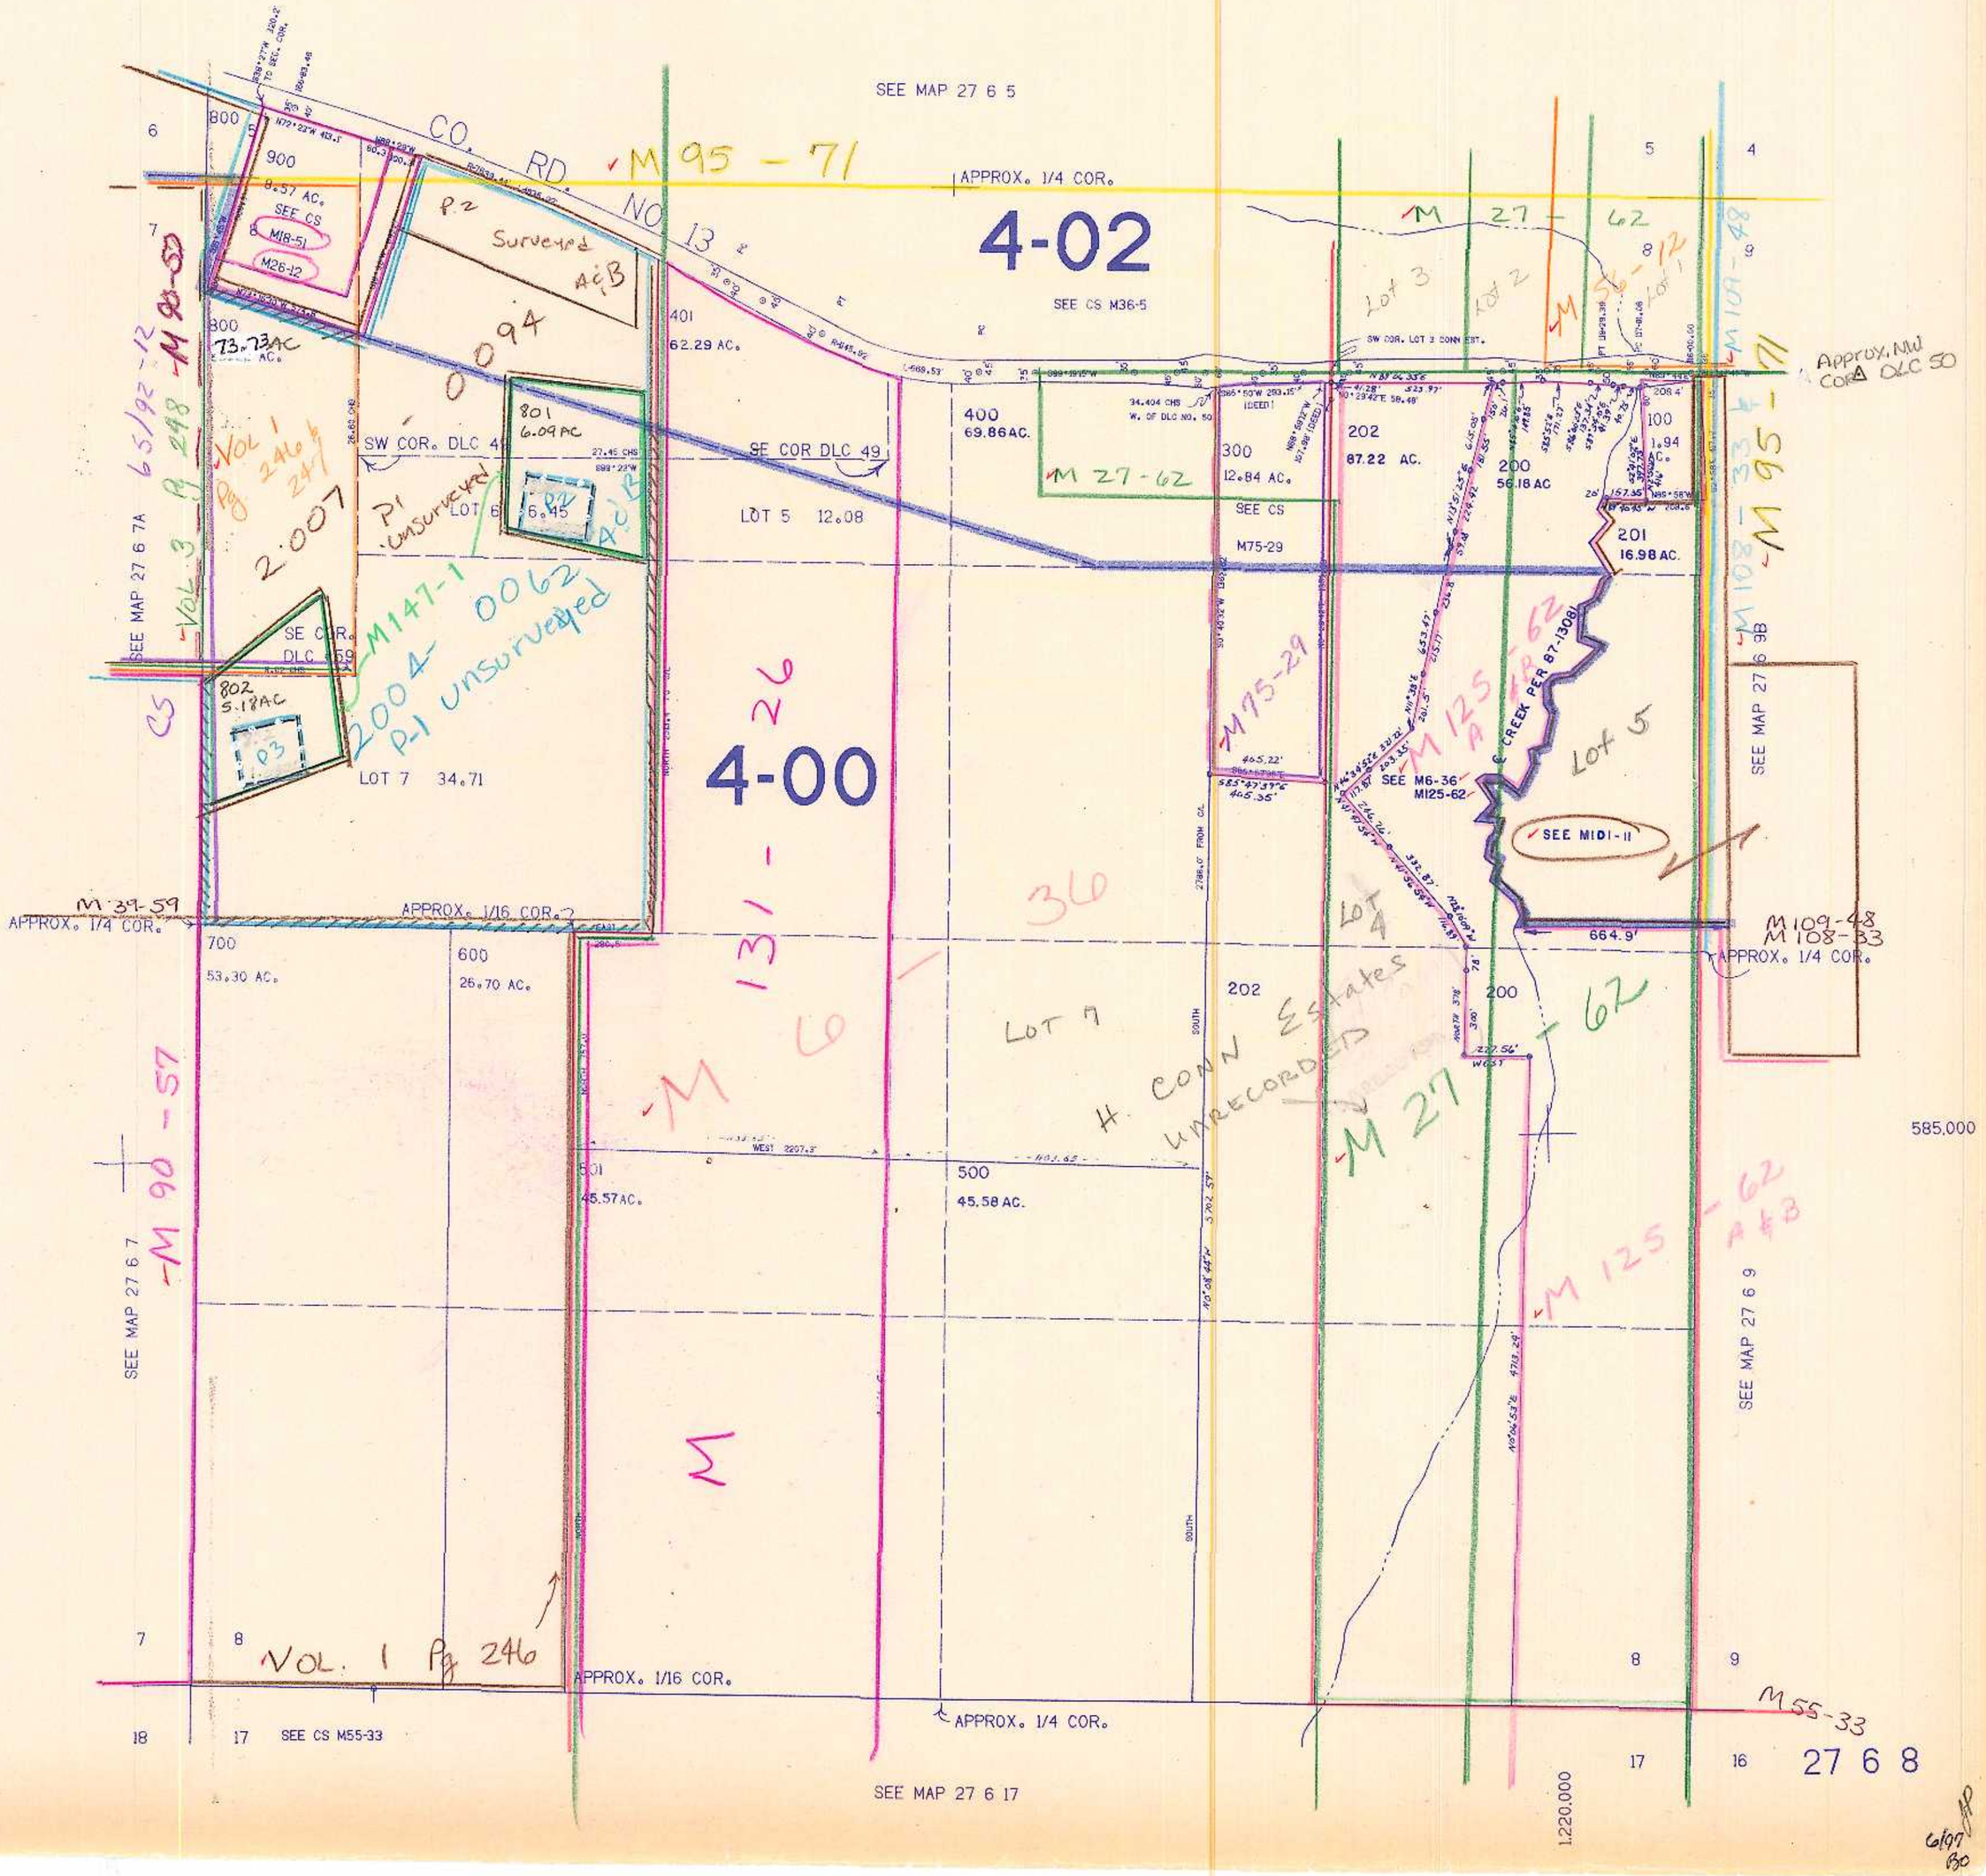
27 6 8