SW1/4 SEC. 2 T.24S. R.7W. W.M.
DOUGLAS COUNTY

1"=200'

THIS MAP WAS PREPARED FOR ASSESSMENT PURPOSE ONLY.

APPROX. CEN. SEC.
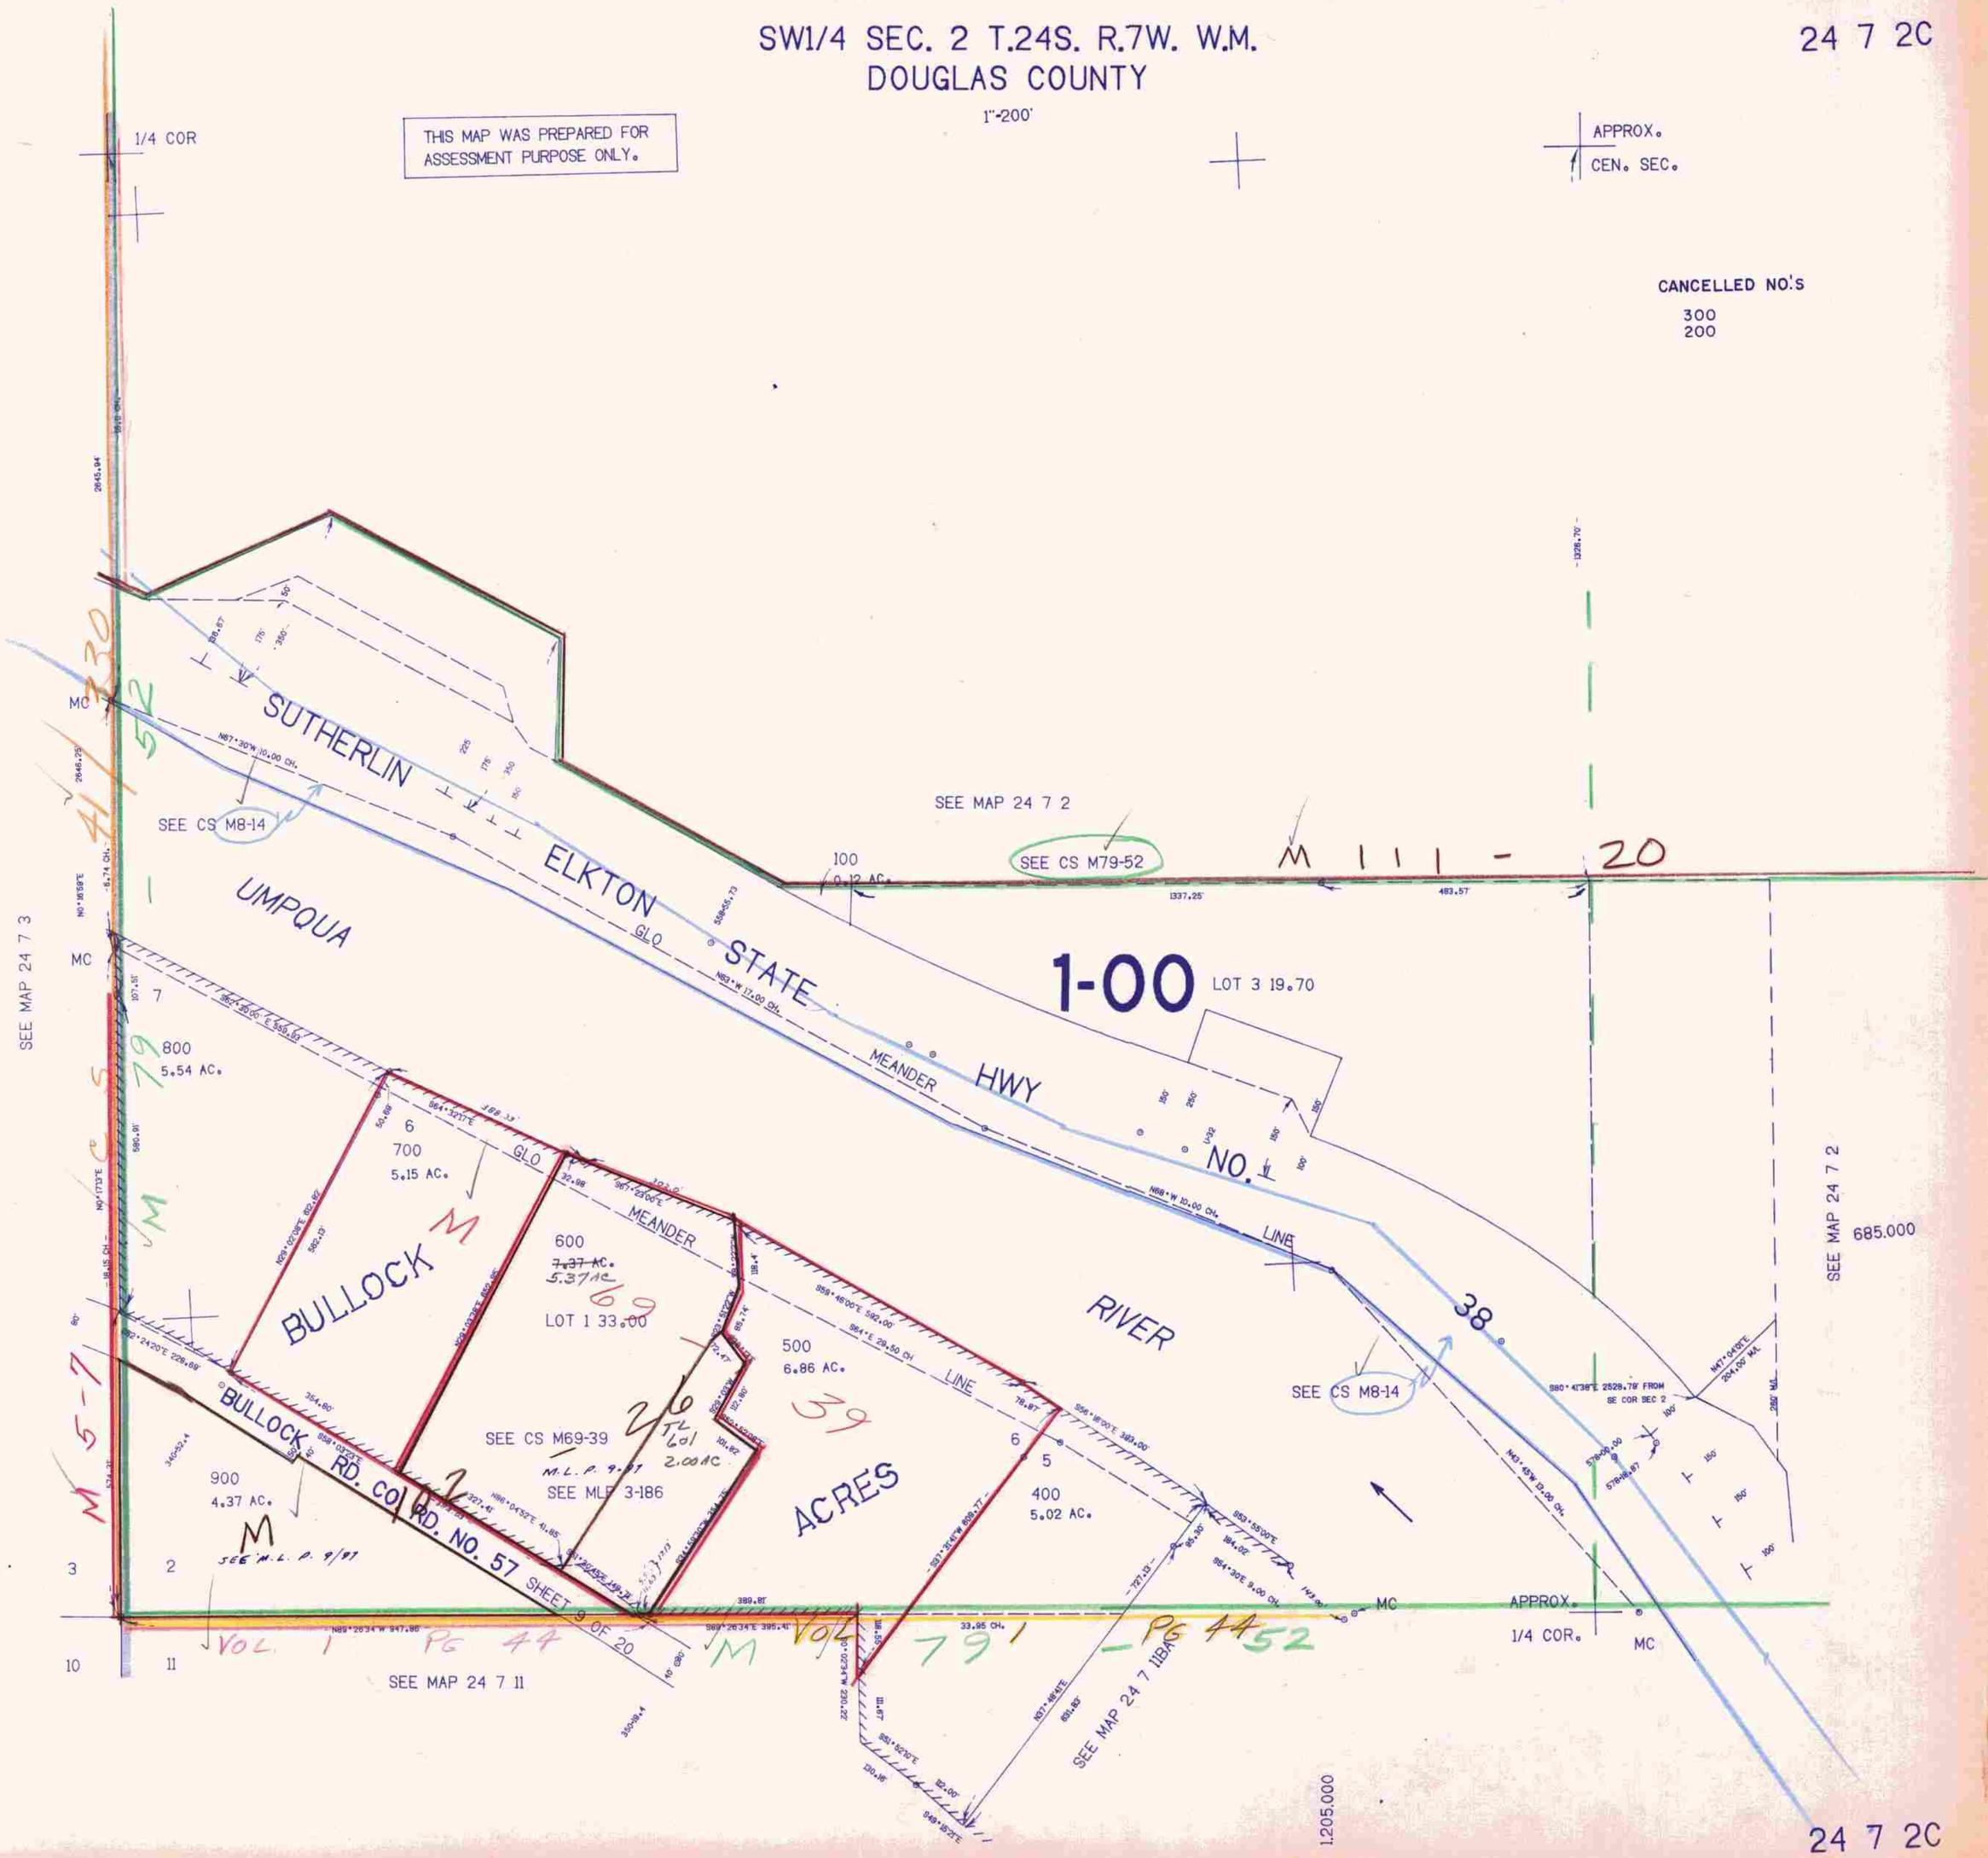
CANCELLED NO.'S
300
200