
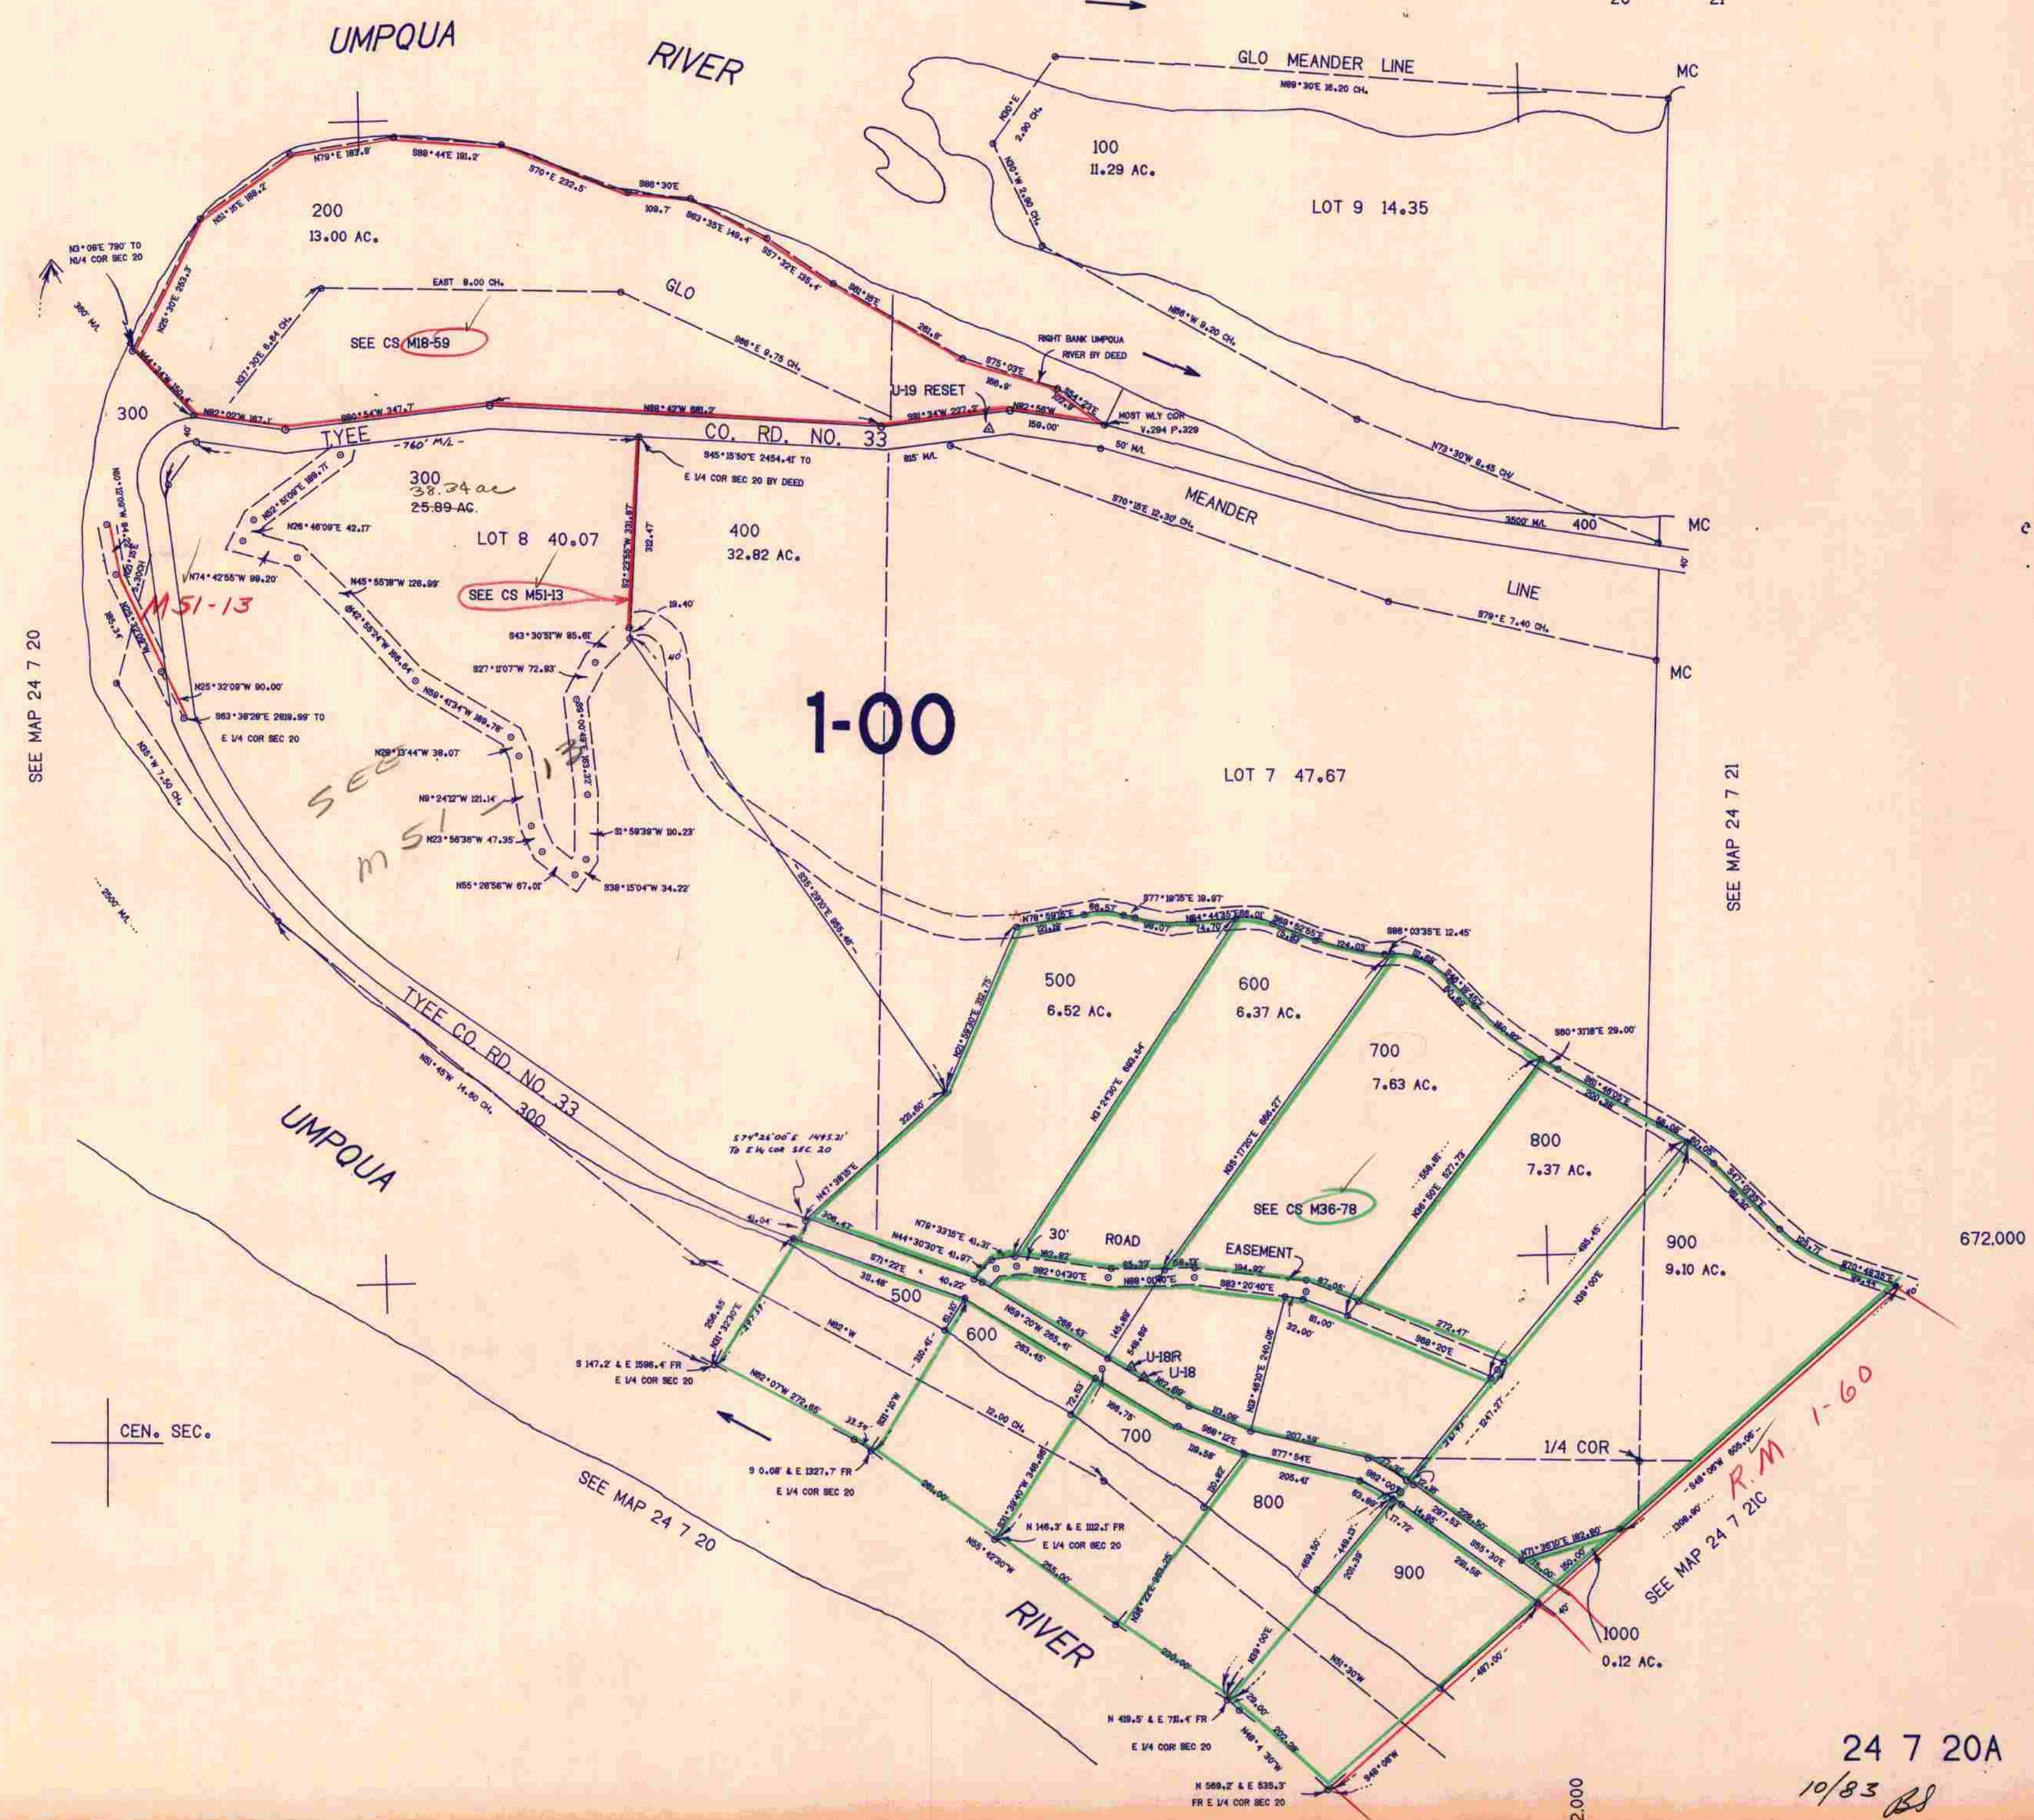


NE1/4 SEC.20 T.24S. R.7W. W.M.
DOUGLAS COUNTY

24 7 20A

THIS MAP WAS PREPARED FOR
ASSESSMENT PURPOSE ONLY.

1"=200' SEE MAP 24 7 17

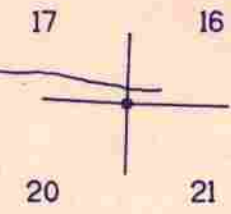

SEE MAP 24 7 20

SEE MAP 24 7 21

1-00

R.M. 1-60
SEE MAP 24 7 21C

24 7 20A

10/83 BS