THIS MAP WAS PREPARED FOR ASSESSMENT PURPOSE ONLY.

Upper Left:
123°35'25"W 43°27'49"N
4101061E 670058N ft

SEC.30 T.24S. R.07W. W.M.
DOUGLAS COUNTY
1" = 400'

Date Exported 2025-07-22

240730

CANCELLE
100M1 1
24
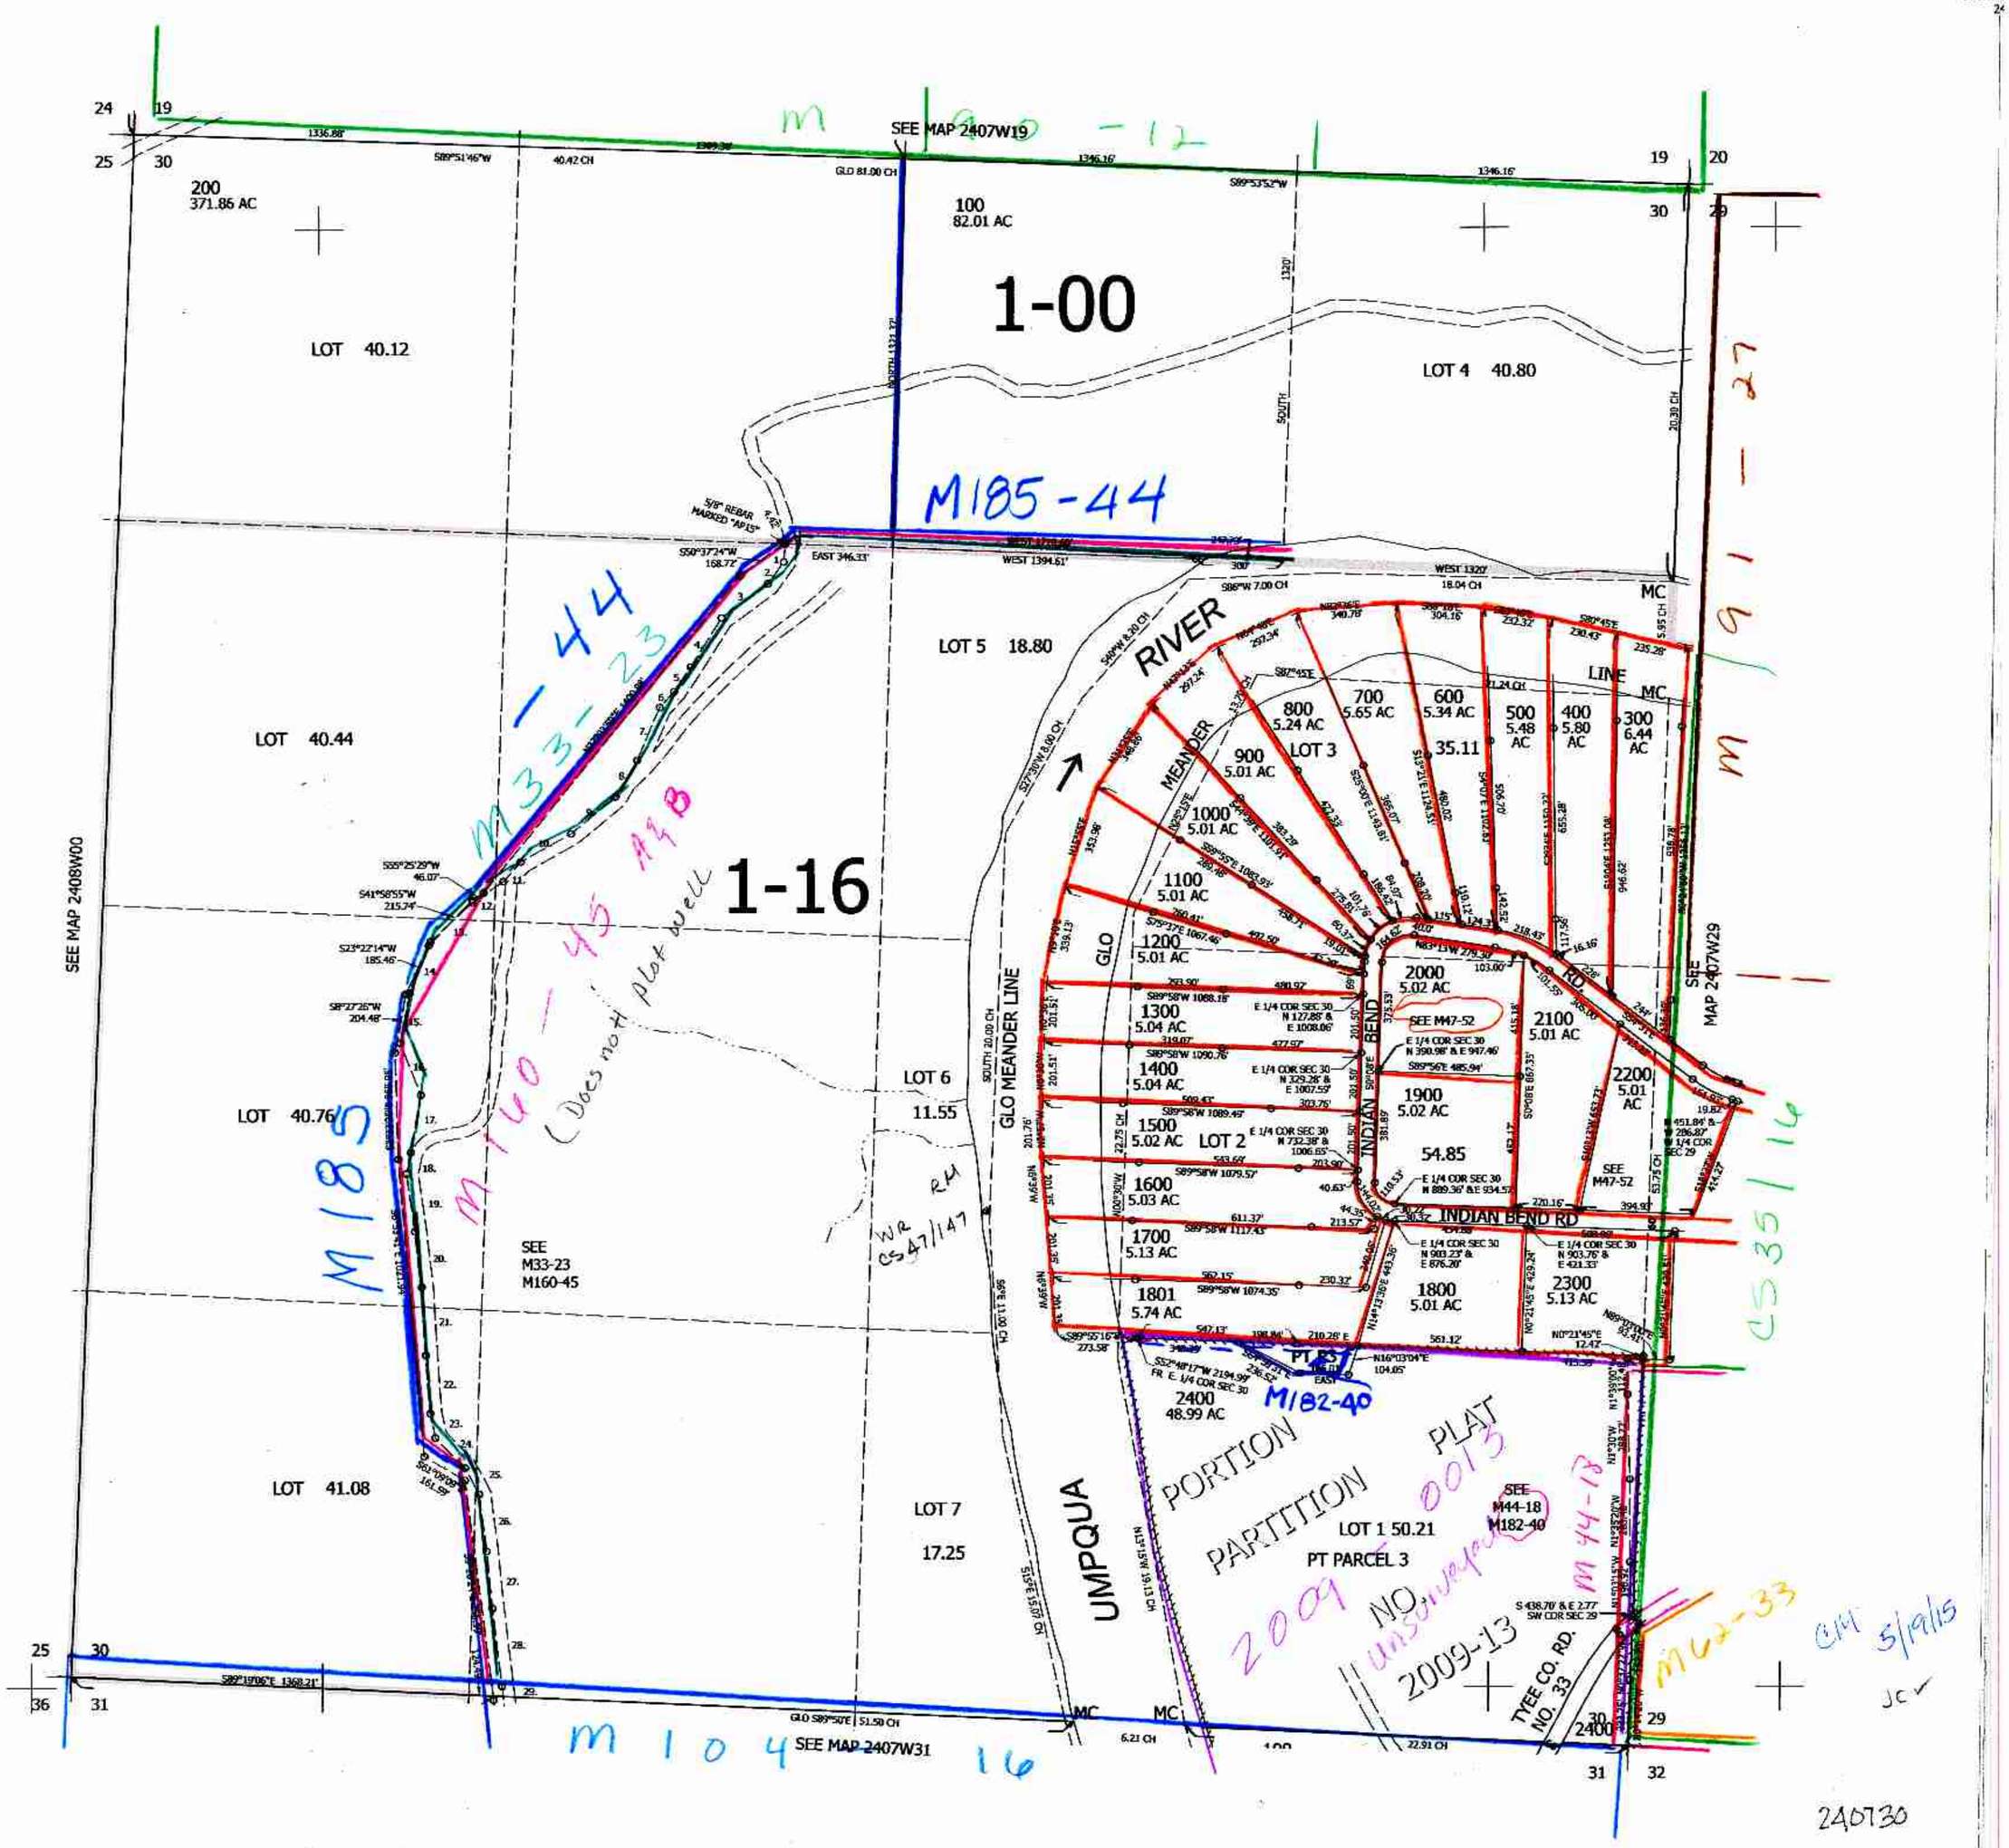
PARCEL 200
1. S3°09'38"W 62.58'
2. S33°36'55"W 91.35'
3. S51°27'07"W 198.72'
4. S29°52'45"W 198.7'
5. S32°29'47"W 102.36'
6. S39°51'07"W 73.17'
7. S21°02'W 198.07'
8. S28°24'37"W 144.86'
9. S48°14'57"W 198.87'
10. S58°22'07"W 197.87'
11. S40°01'10"W 89.46'
12. S53°55'W 127.8'
13. S44°59'37"W 197.47'
14. S19°51'42"W 191.04'
15. S8°43'30"W 174.11'
16. S23°31'30"E 192.25'
17. S7°45'37"W 200.16'
18. S8°35'07"W 75.01'
19. S10°03'08"E 200.04'
20. S9°12'46"E 191.47'
21. S5°35'26"E 233.86'
22. S6°19'36"E 200.51'
23. S14°27'06"E 85.98'
24. S46°54'36"E 143.94'
25. S30°09'36"E 102.45'
26. S9°34'31"E 197.54'
27. S7°50'56"E 197.04'
28. S9°16'26"E 265.03'
29. S9°34'26"E 199.76'