


THIS MAP WAS PREPARED FOR ASSESSMENT PURPOSE ONLY.

SE1/4 NW1/4 SEC.31 T.25S. R.2W. W.M.  
DOUGLAS COUNTY  
1" = 100'

REVISED ON  
11-9-20

25 2 31BD

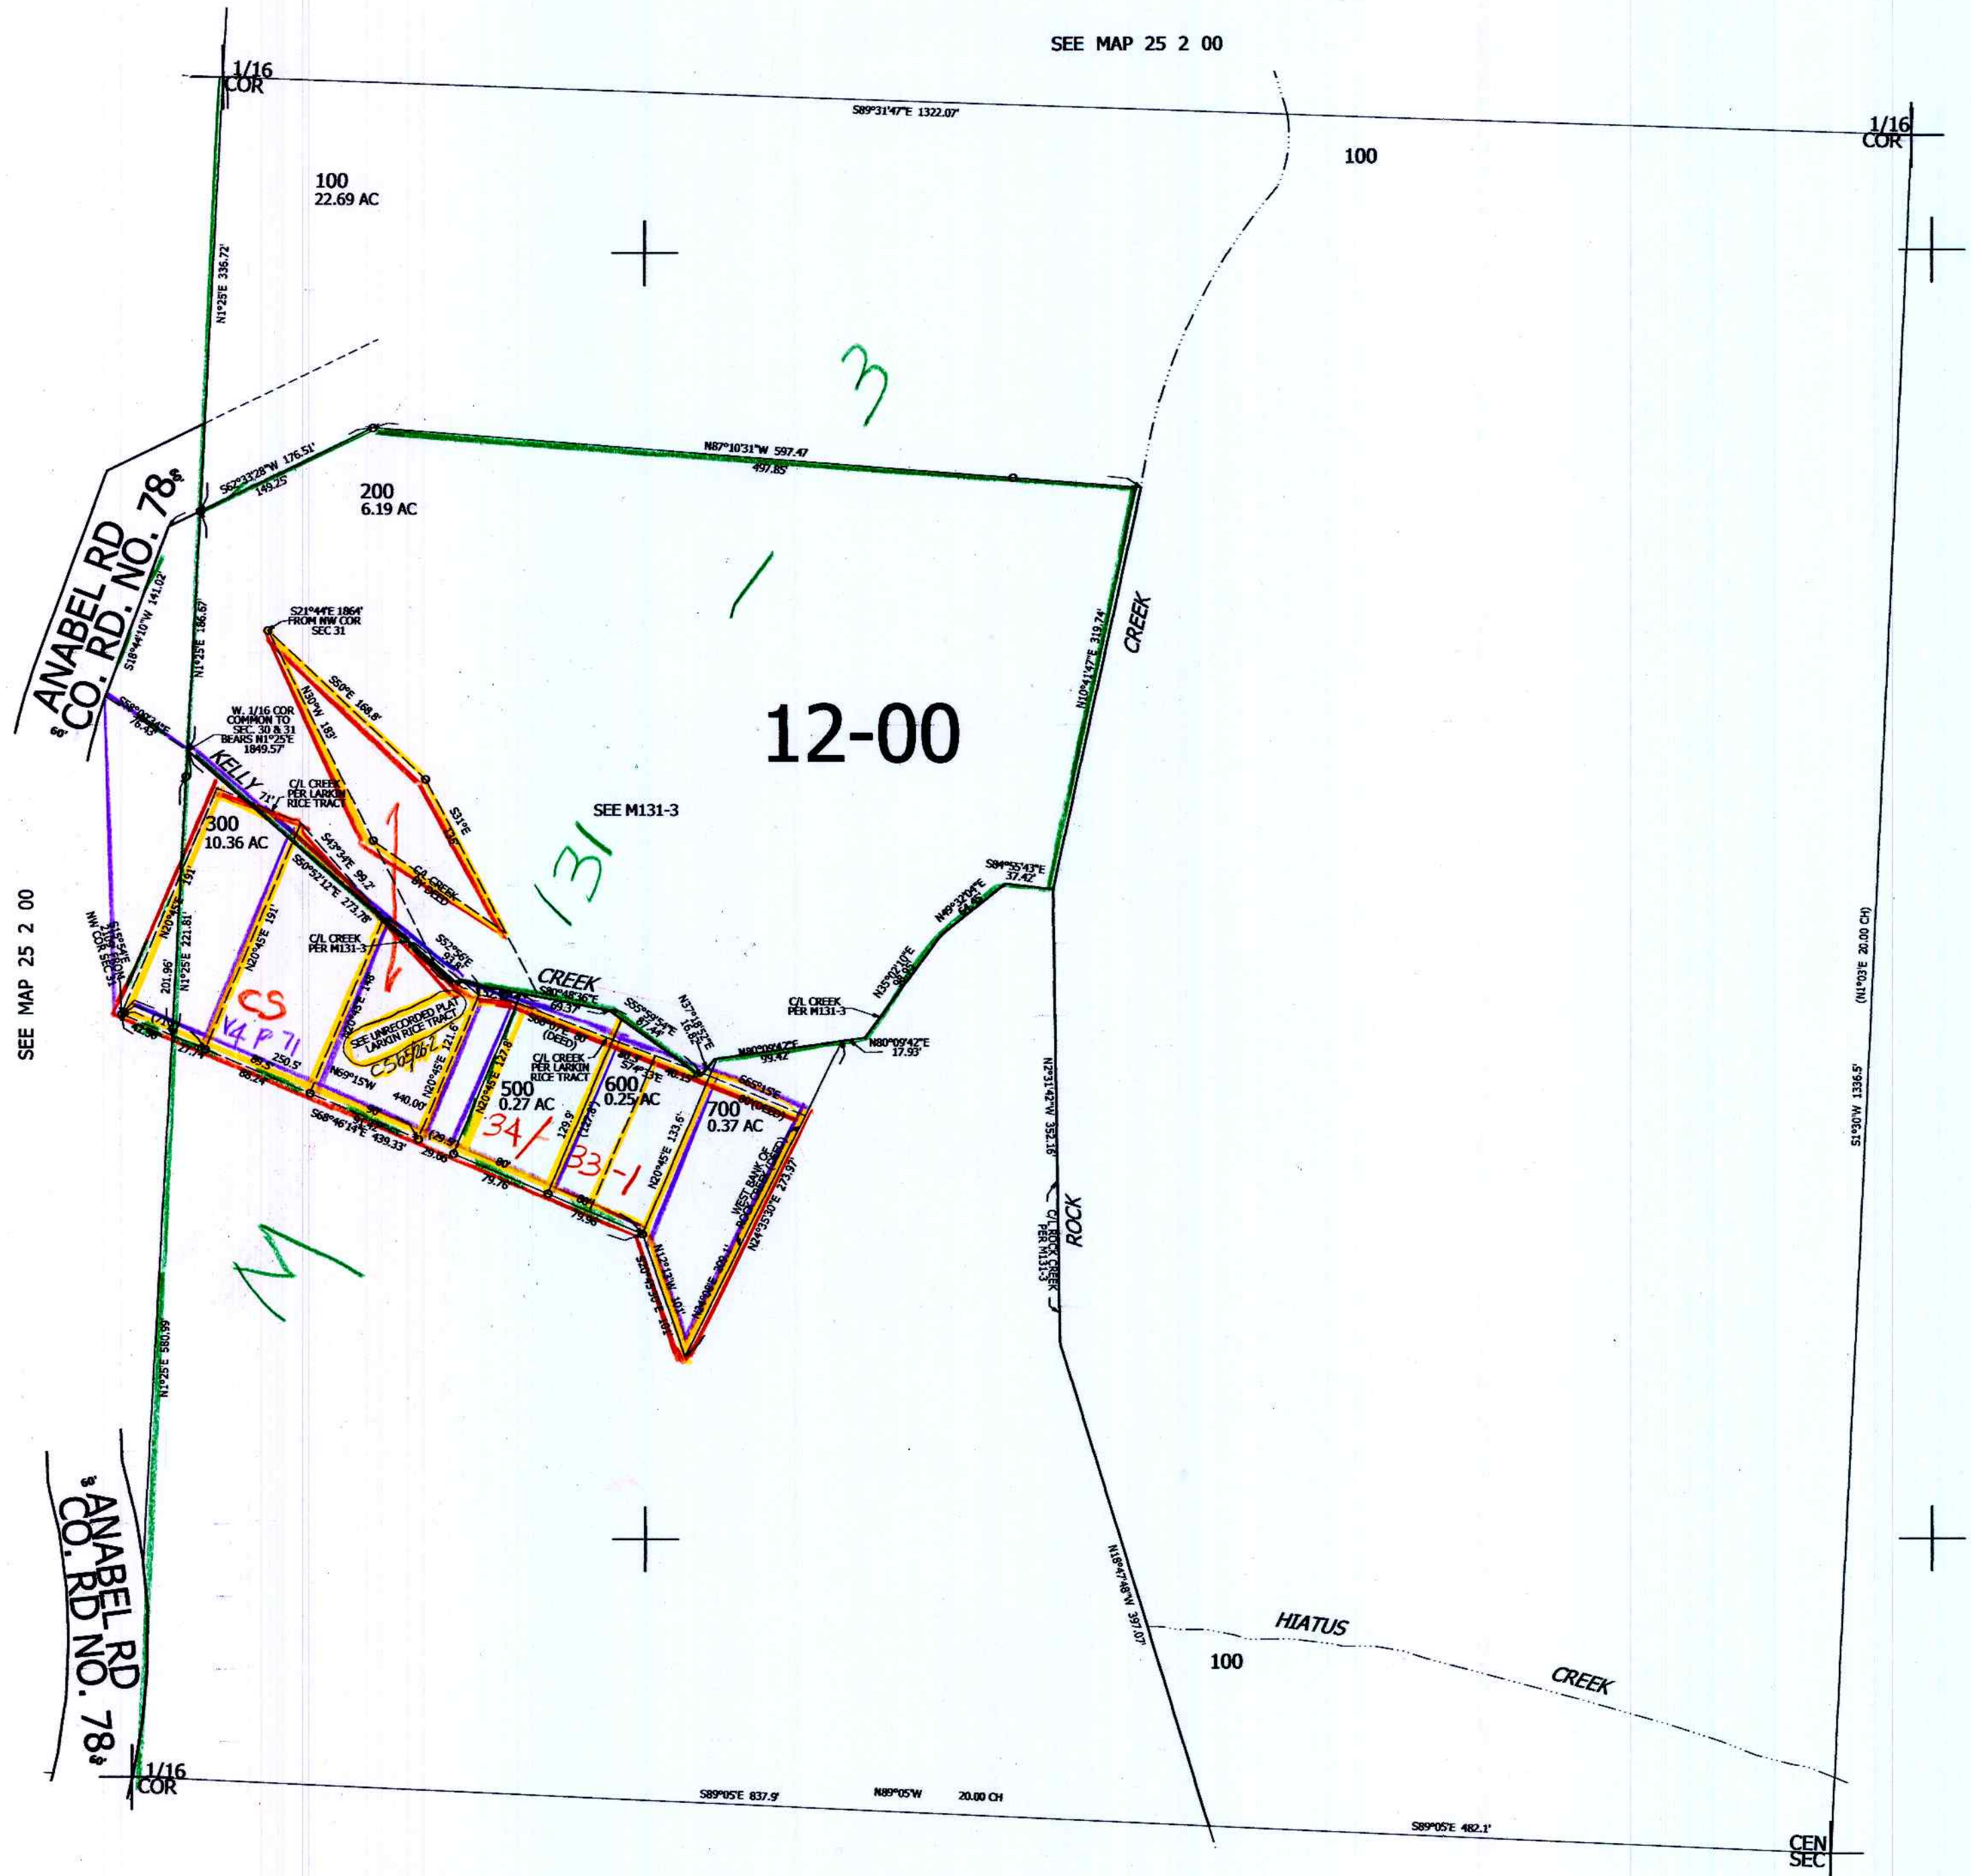

CANCELLED NOS  
400 102 101

SEE MAP 25 2 00

SEE MAP 25 2 00

624,000

SEE MAP 25 2 00

4,261,000

11/20/20 DJ  
JCW

25 2 31BD