THIS MAP WAS PREPARED FOR ASSESSMENT PURPOSE ONLY.

SEC.2 T.25S. R.4W. W.M.
DOUGLAS COUNTY

1" = 400'

25 4 2

REVISED ON 12-2-08

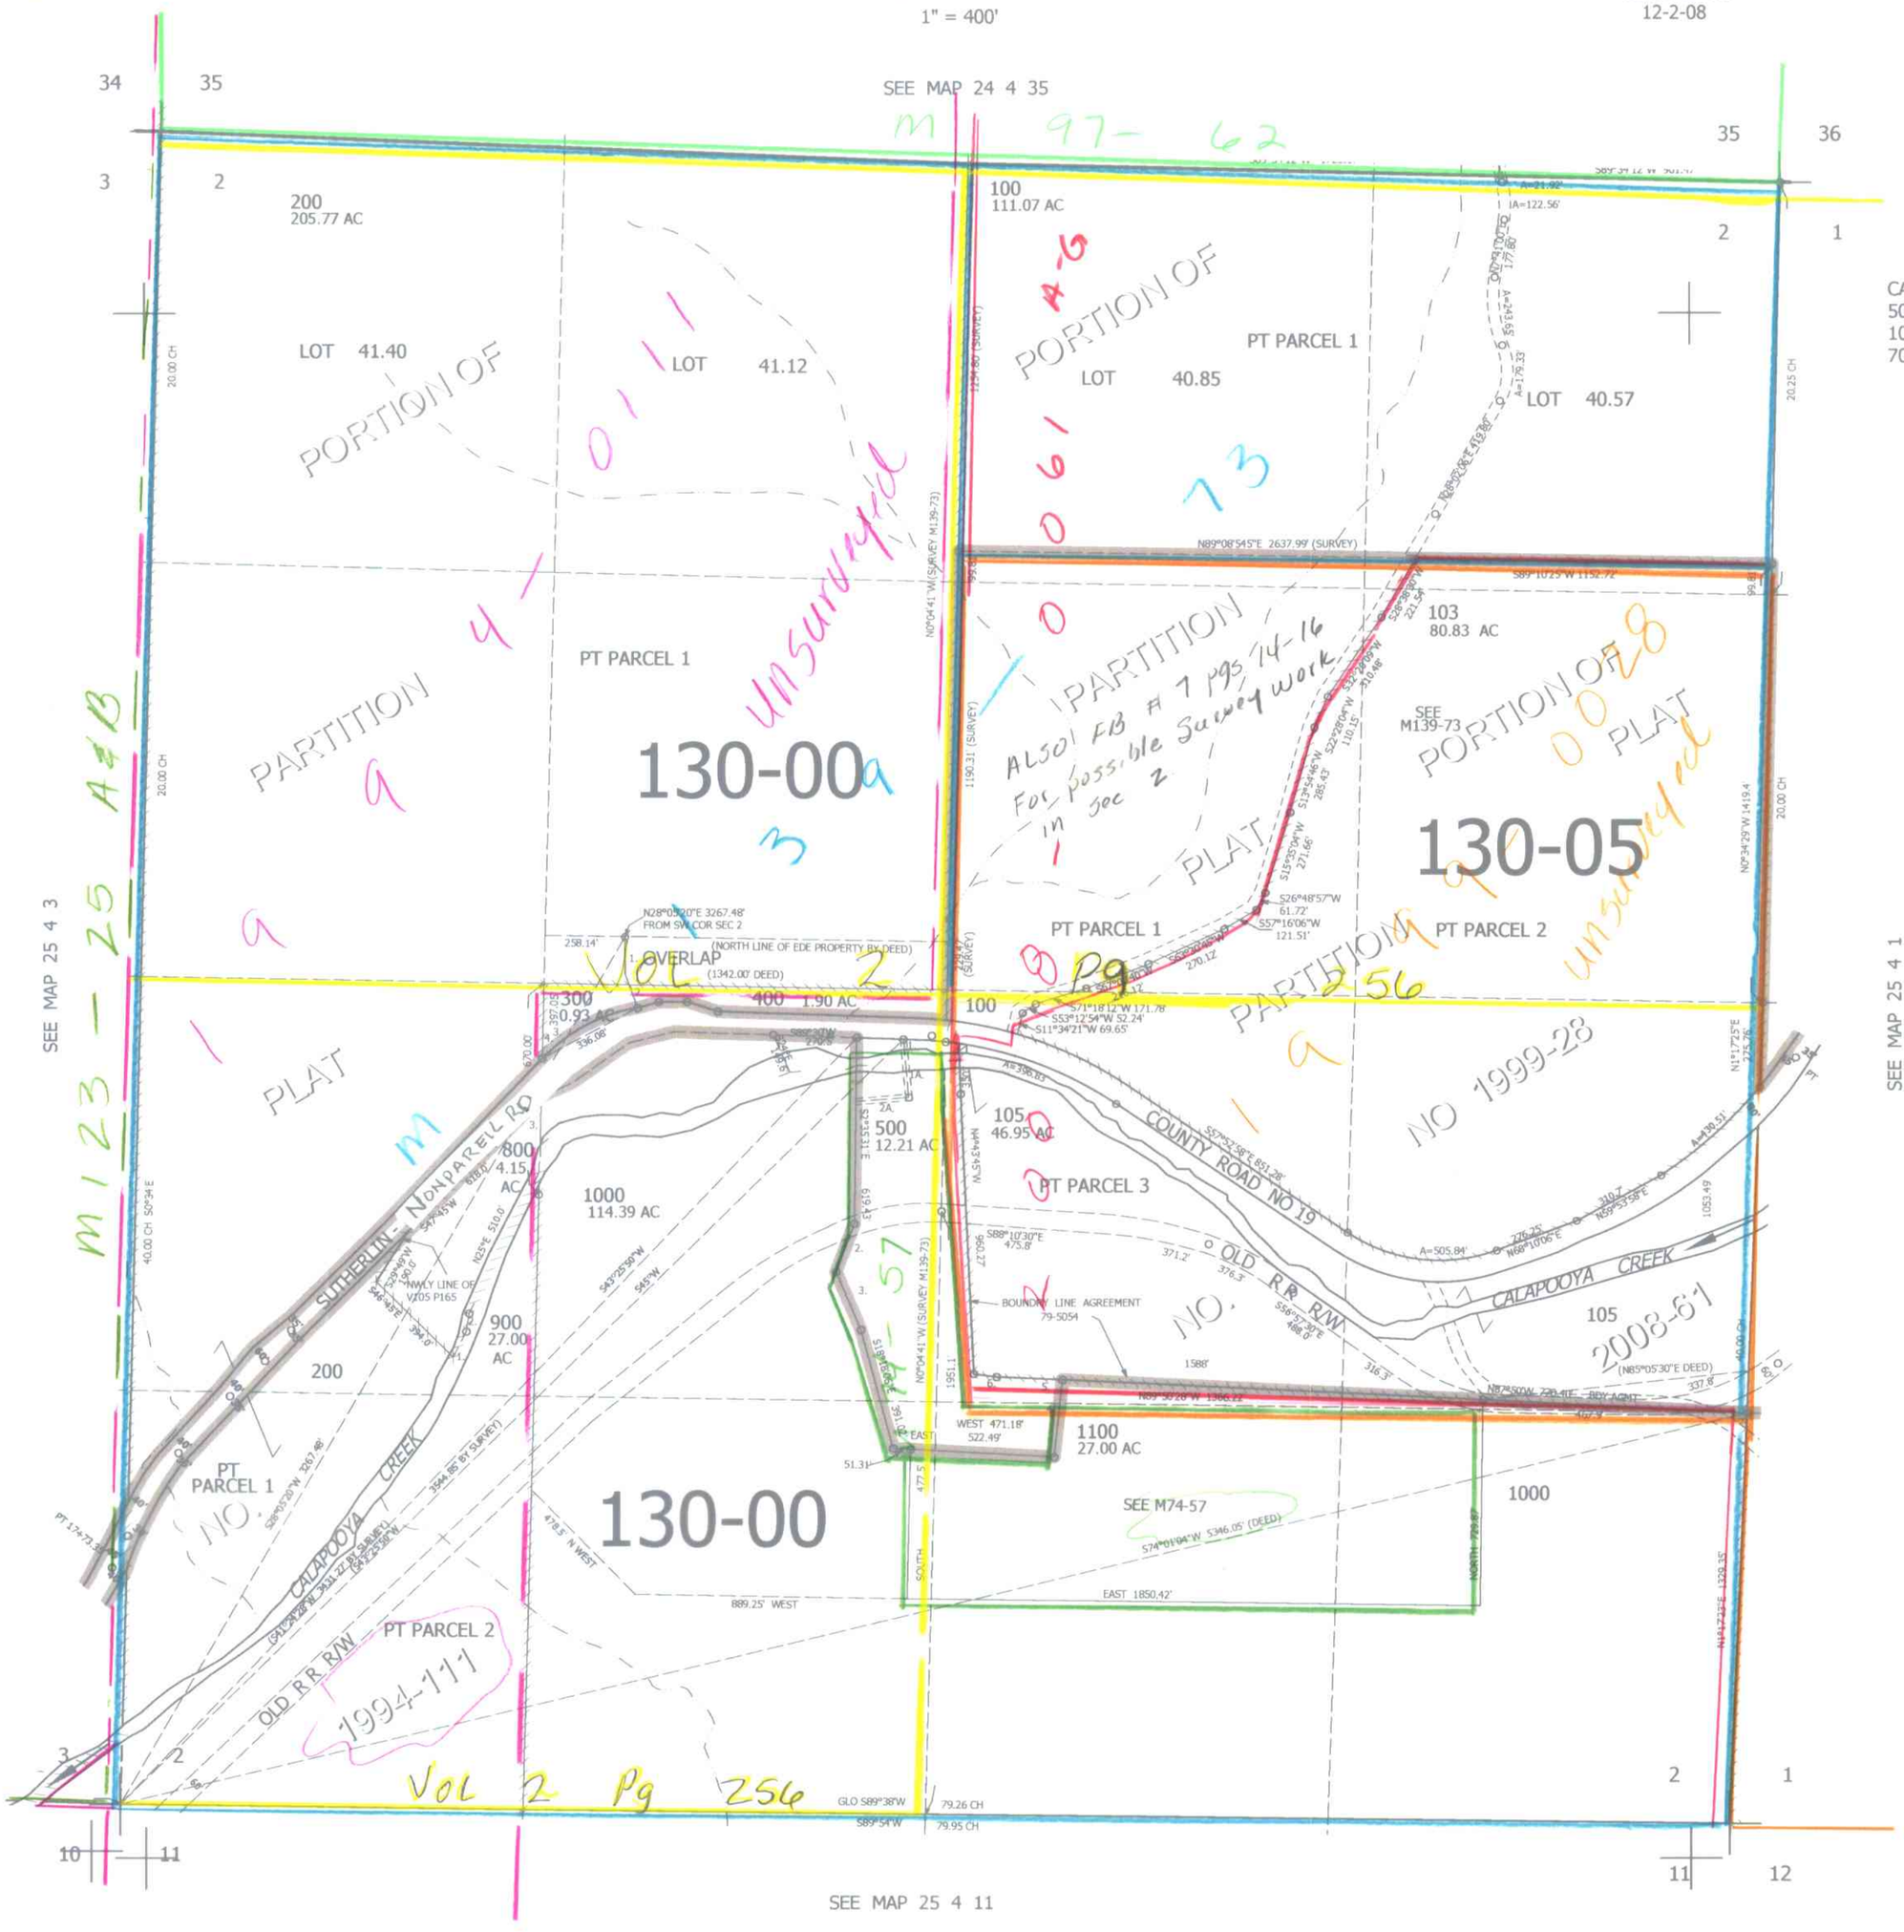

CANCELLED NOS
500M1 600 1100M1
101 102 300M1
700 104

PARCEL 300
1. S3°06'20"E 122.90'
2. S23°01'26"E 115.25'
3. LONG CHORD 336.08'
4. S41°54'10"W 17.17'

PARCEL 500
1. S89°44'04"W 354.21'
2. S16°46'49"W 167.78'
3. S28°17'11"E 202.85'
4. N3°00'00"E 248.93'
5. S89°50'28"W 202.07'
6. N84°53'02"W 73.75'
7. N3°28'19"W 124.11'

20' EASEMENT
1A. S8°19'36"E 181.78'
2A. S85°34'39"W 180.62'

PARCEL 800
1. N25°30'00"E 94.00'
2. N7°30'00"E 59.00'

25 4 2