


THIS MAP WAS PREPARED FOR ASSESSMENT PURPOSE ONLY.

SECTION 5 T.25S. R.4 W.W.M. DOUGLAS COUNTY

25 4 5

1" = 400'

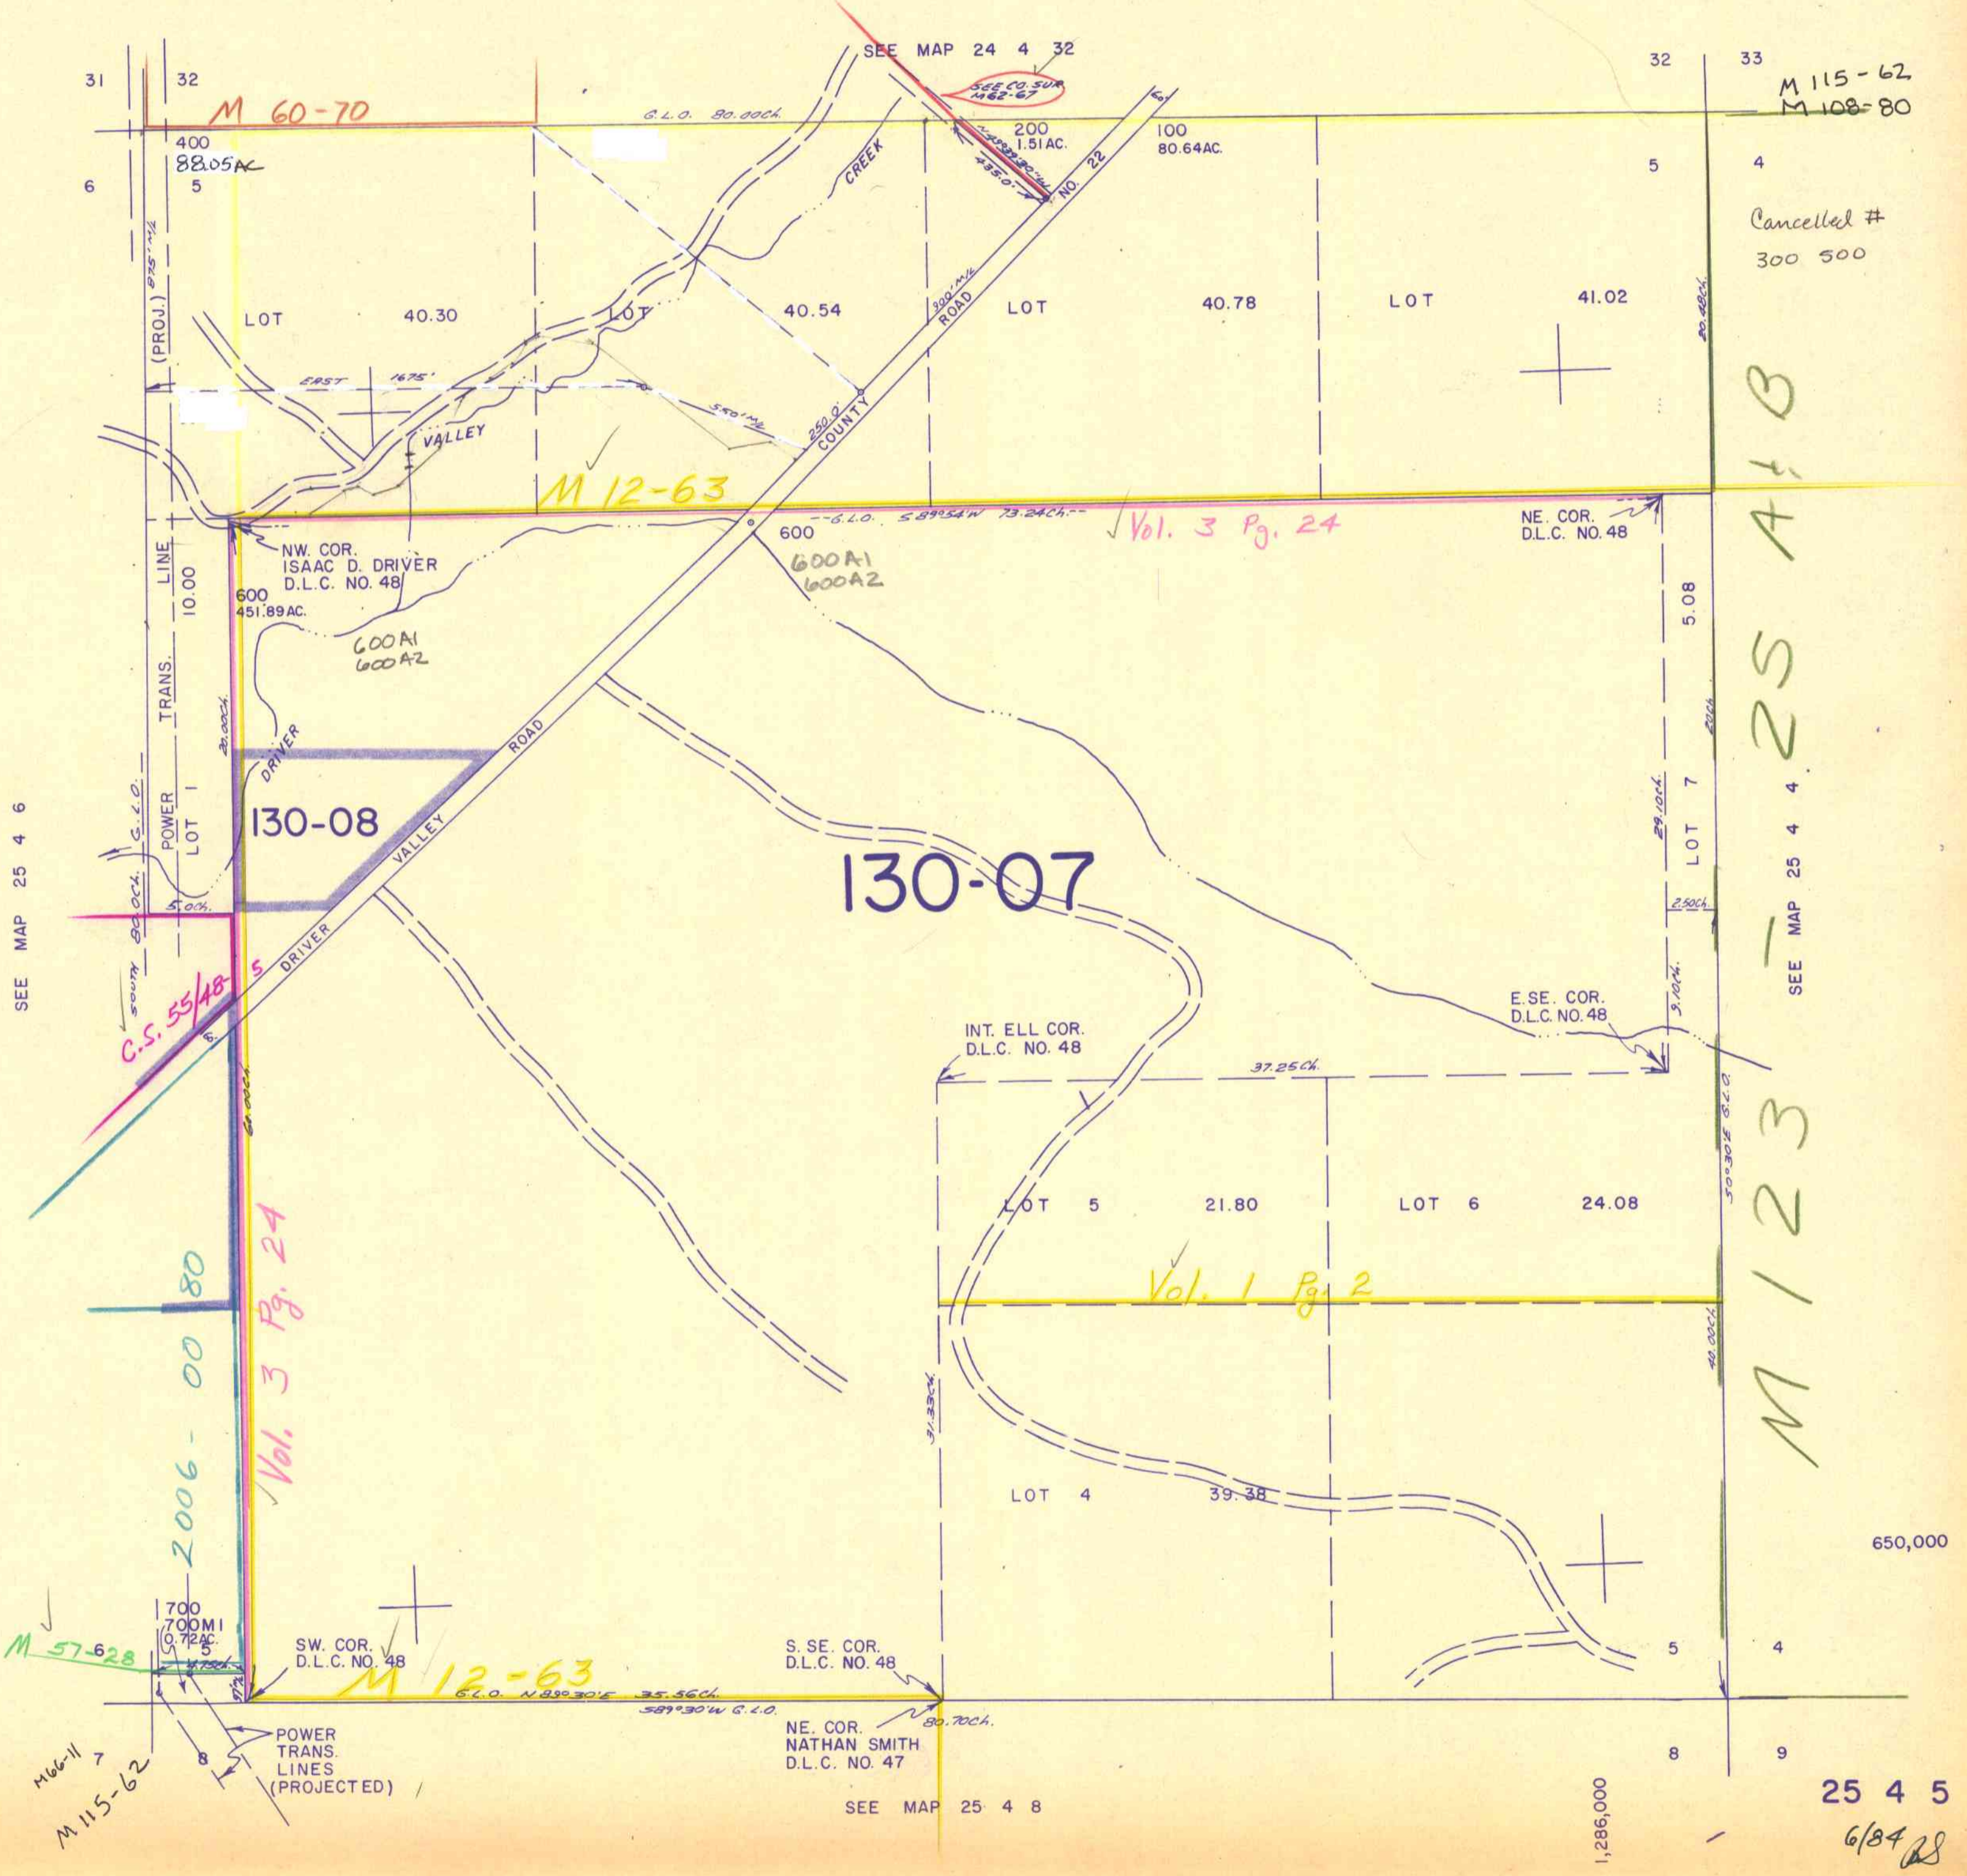

SEE MAP 25 4 6

SEE MAP 25 4 8

SEE MAP 25 4 4

25 4 5

6/84 BS

1,286,000