


THIS MAP WAS PREPARED FOR
ASSESSMENT PURPOSE ONLY.

NW1/4 SW1/4 SEC. 8 T.25S. R.4 W.W.M.
DOUGLAS COUNTY

25 4 8CB

1"=100'

SEE MAP 25 4 8

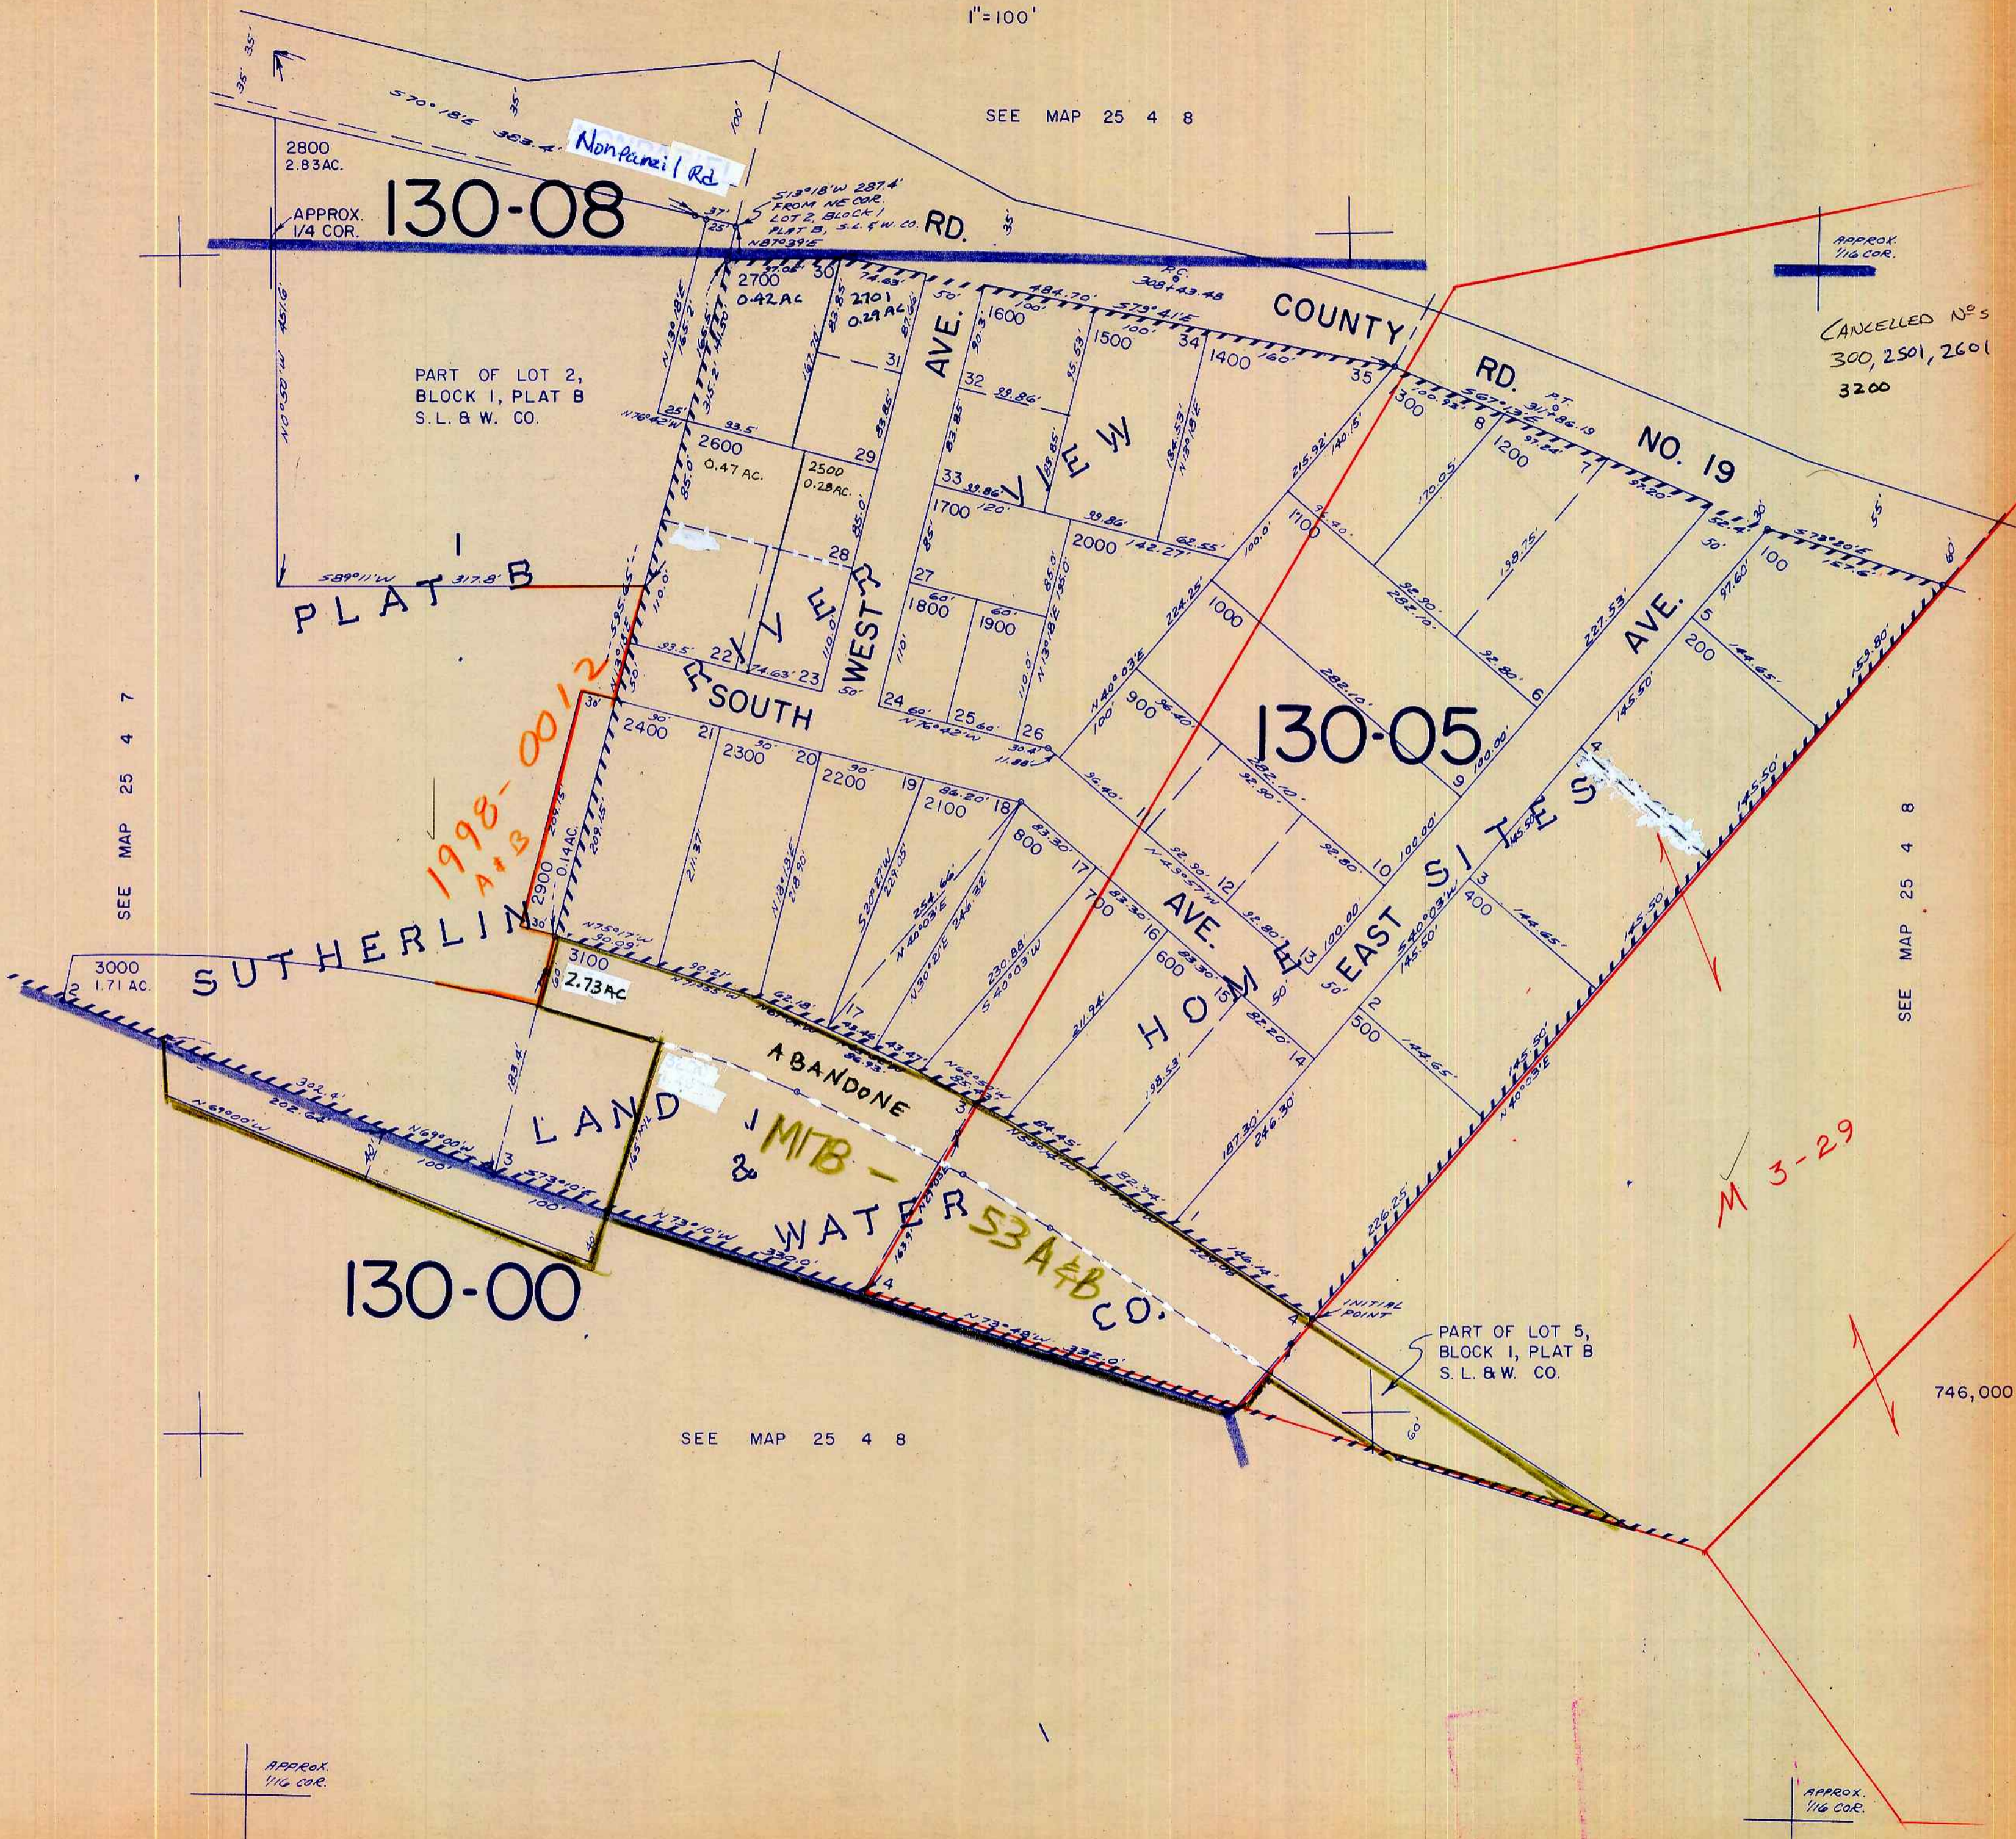

SEE MAP 25 4 7

SEE MAP 25 4 8

SEE MAP 25 4 8

25 4 8CB
7/04 BS

1,282,000

746,000

TRACED DATE 10-02