


THIS MAP WAS PREPARED FOR ASSESSMENT PURPOSE ONLY.

SECTION 16 T.25S. R.4 W.W.M. DOUGLAS COUNTY

25 4 16 UPDATE

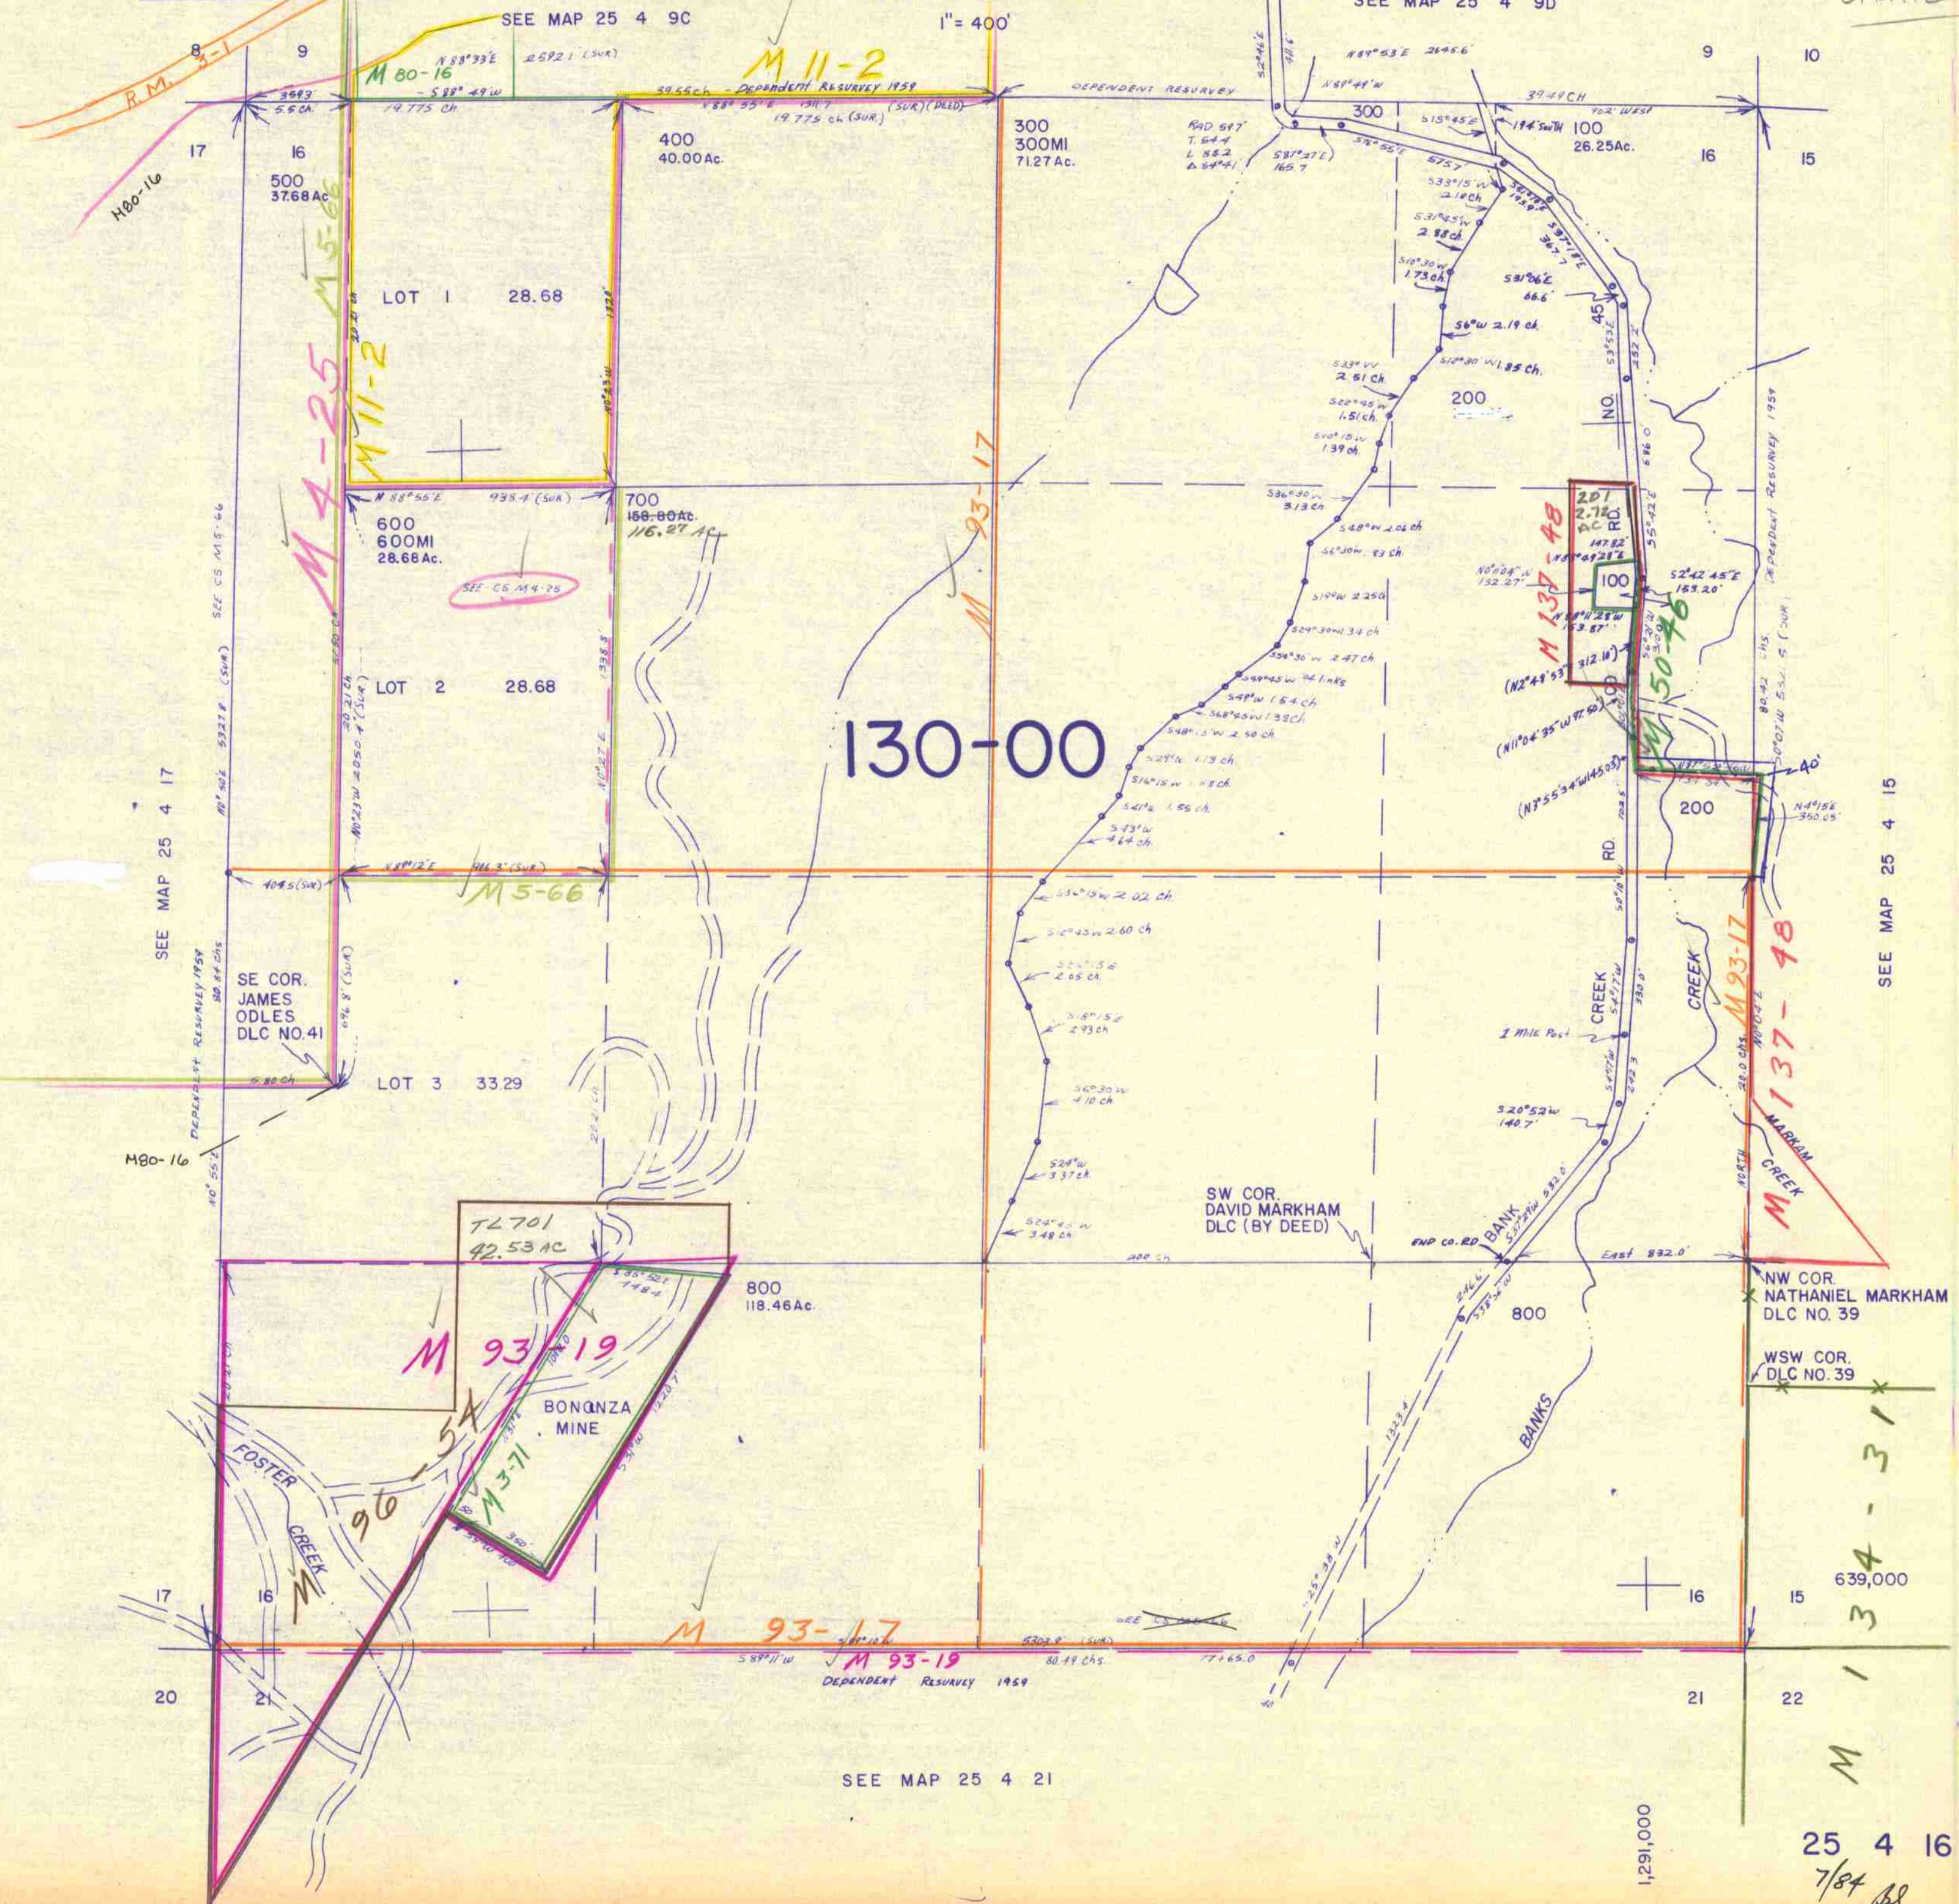

SEE MAP 25 4 21

25 4 16
7/84
68

1,291,000

M 134-31