


SECTION 25 T.25S. R. 4 W. W.M.  
DOUGLAS COUNTY

25 4 25

THIS MAP WAS PREPARED FOR  
ASSESSMENT PURPOSE ONLY.

1" = 400'

SEE MAP 25 4

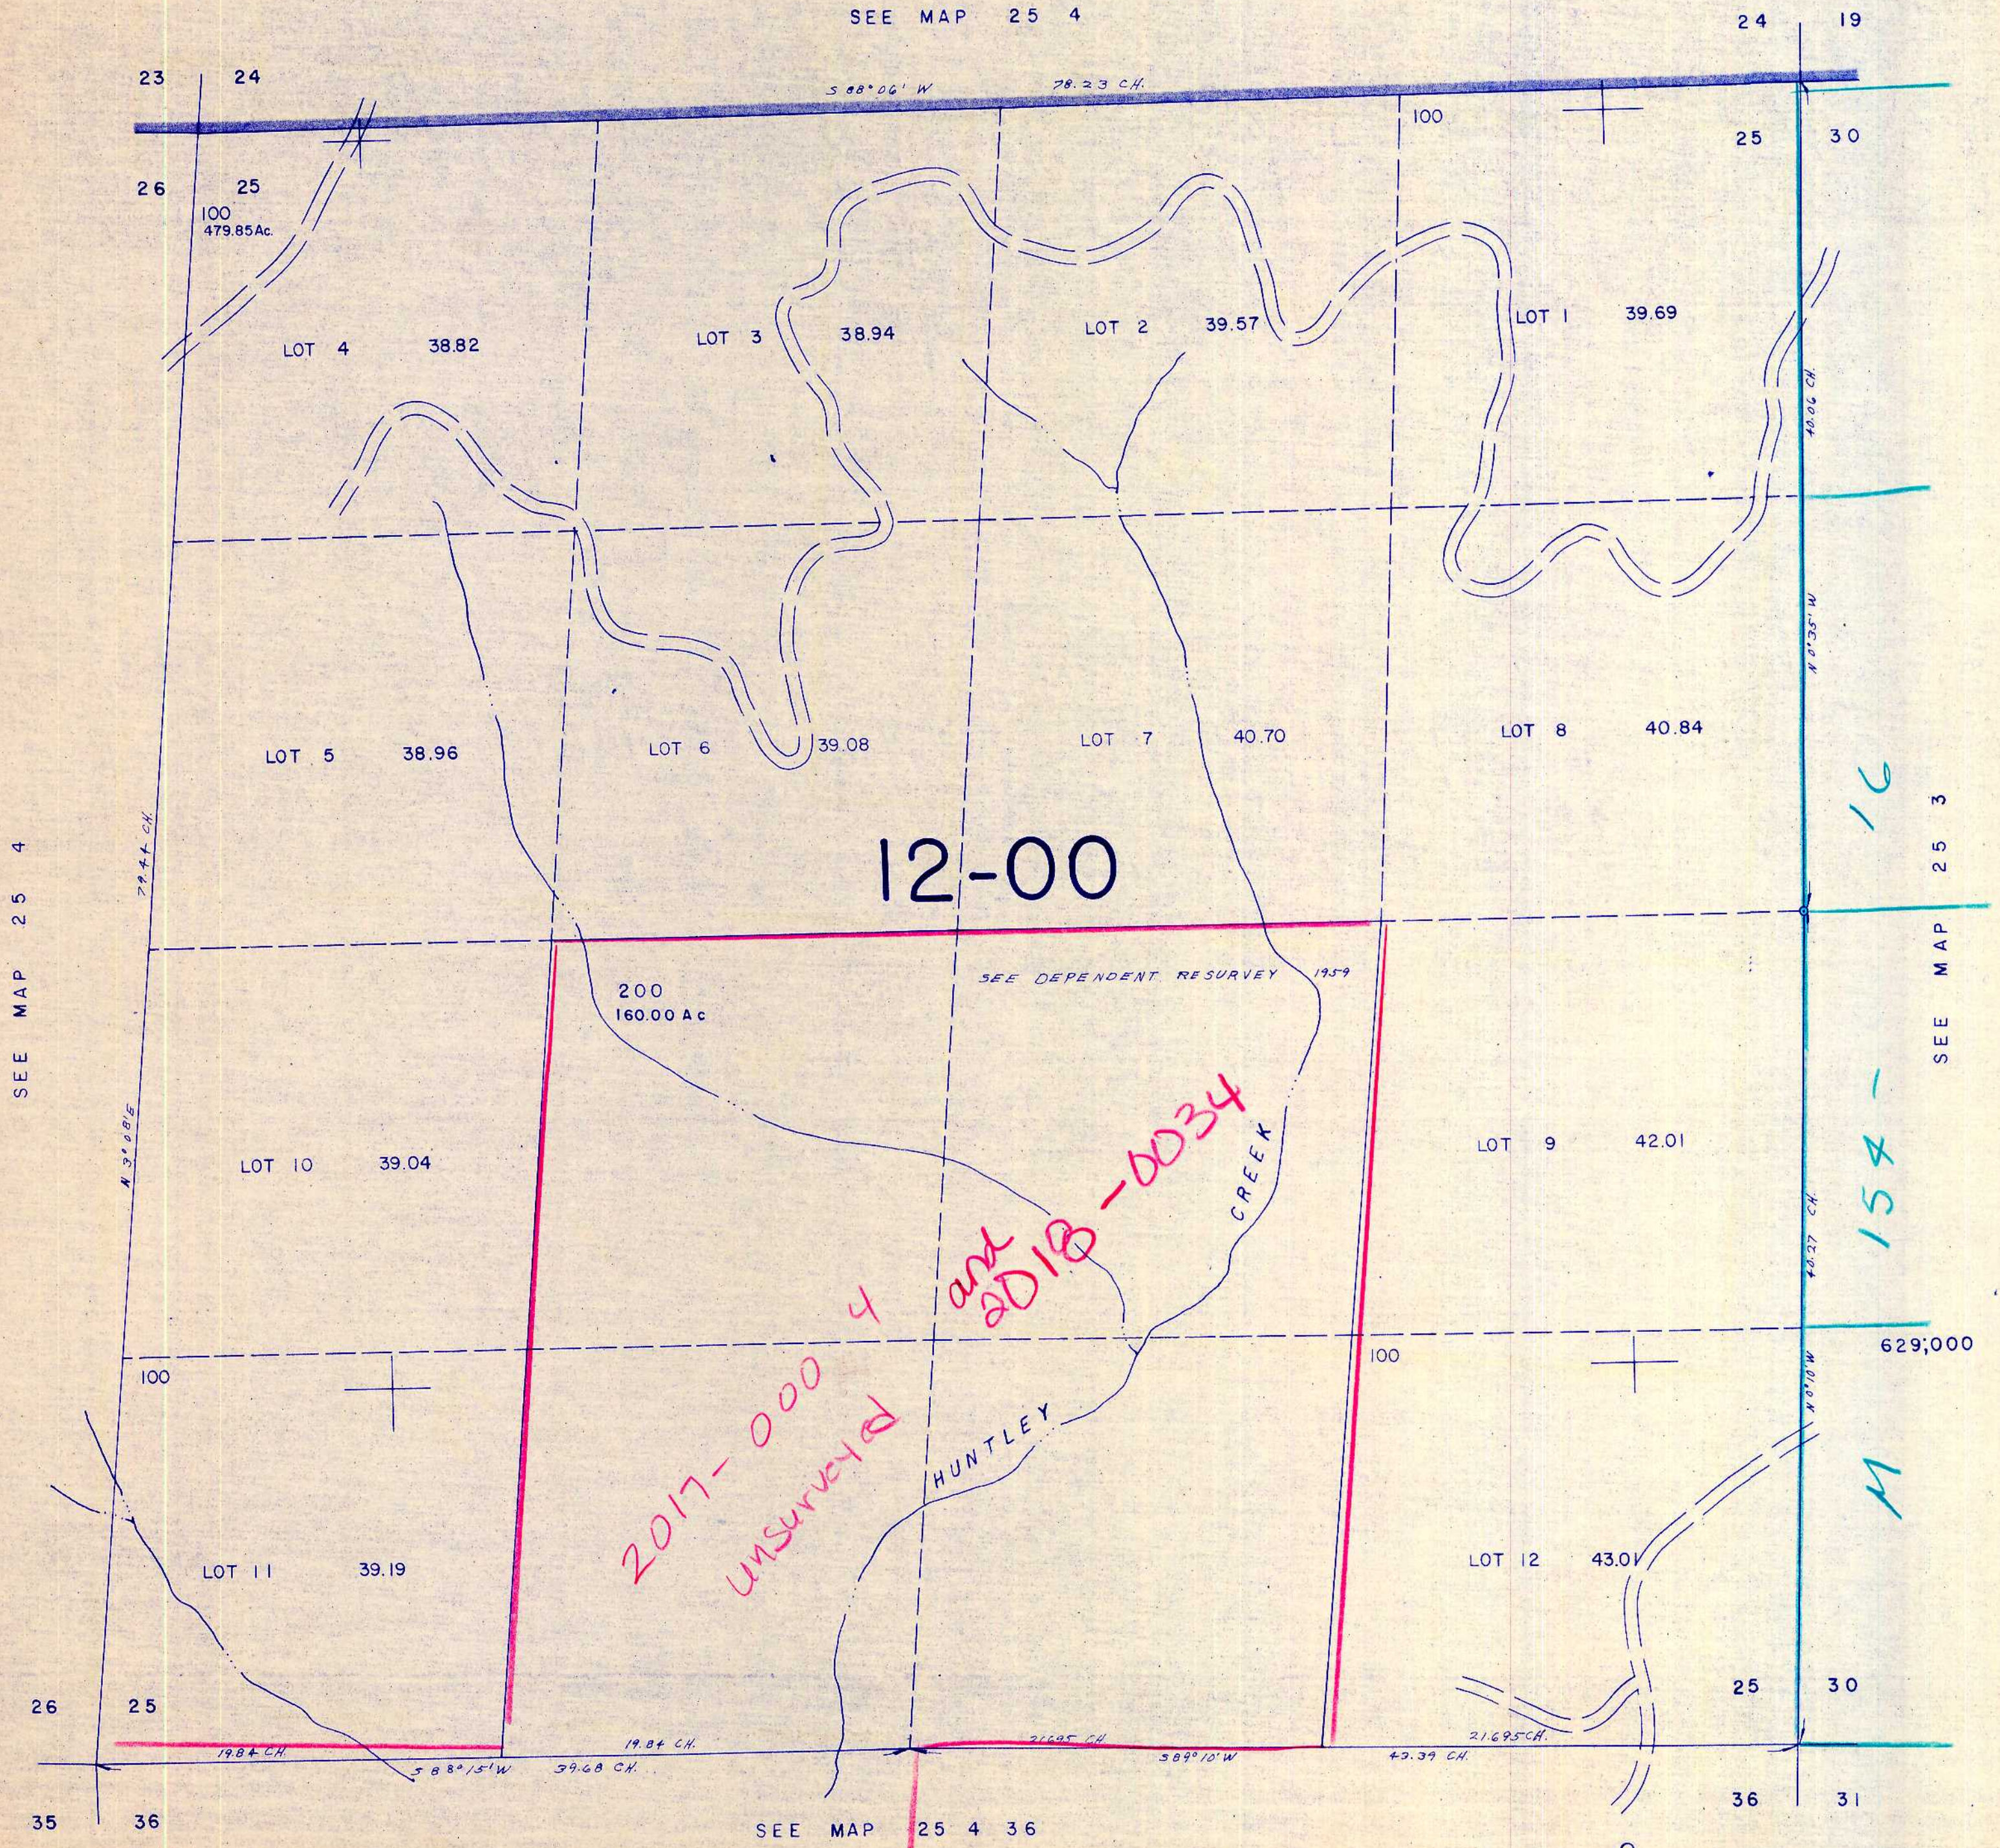

12-00

2017-000 4 and 2018-0034  
Pakansun unsurveyed

16

154-

M

25 4 25

7/04 B8