SECTION 29 T.25S. R.4 W.W.M.
DOUGLAS COUNTY

1" = 400'
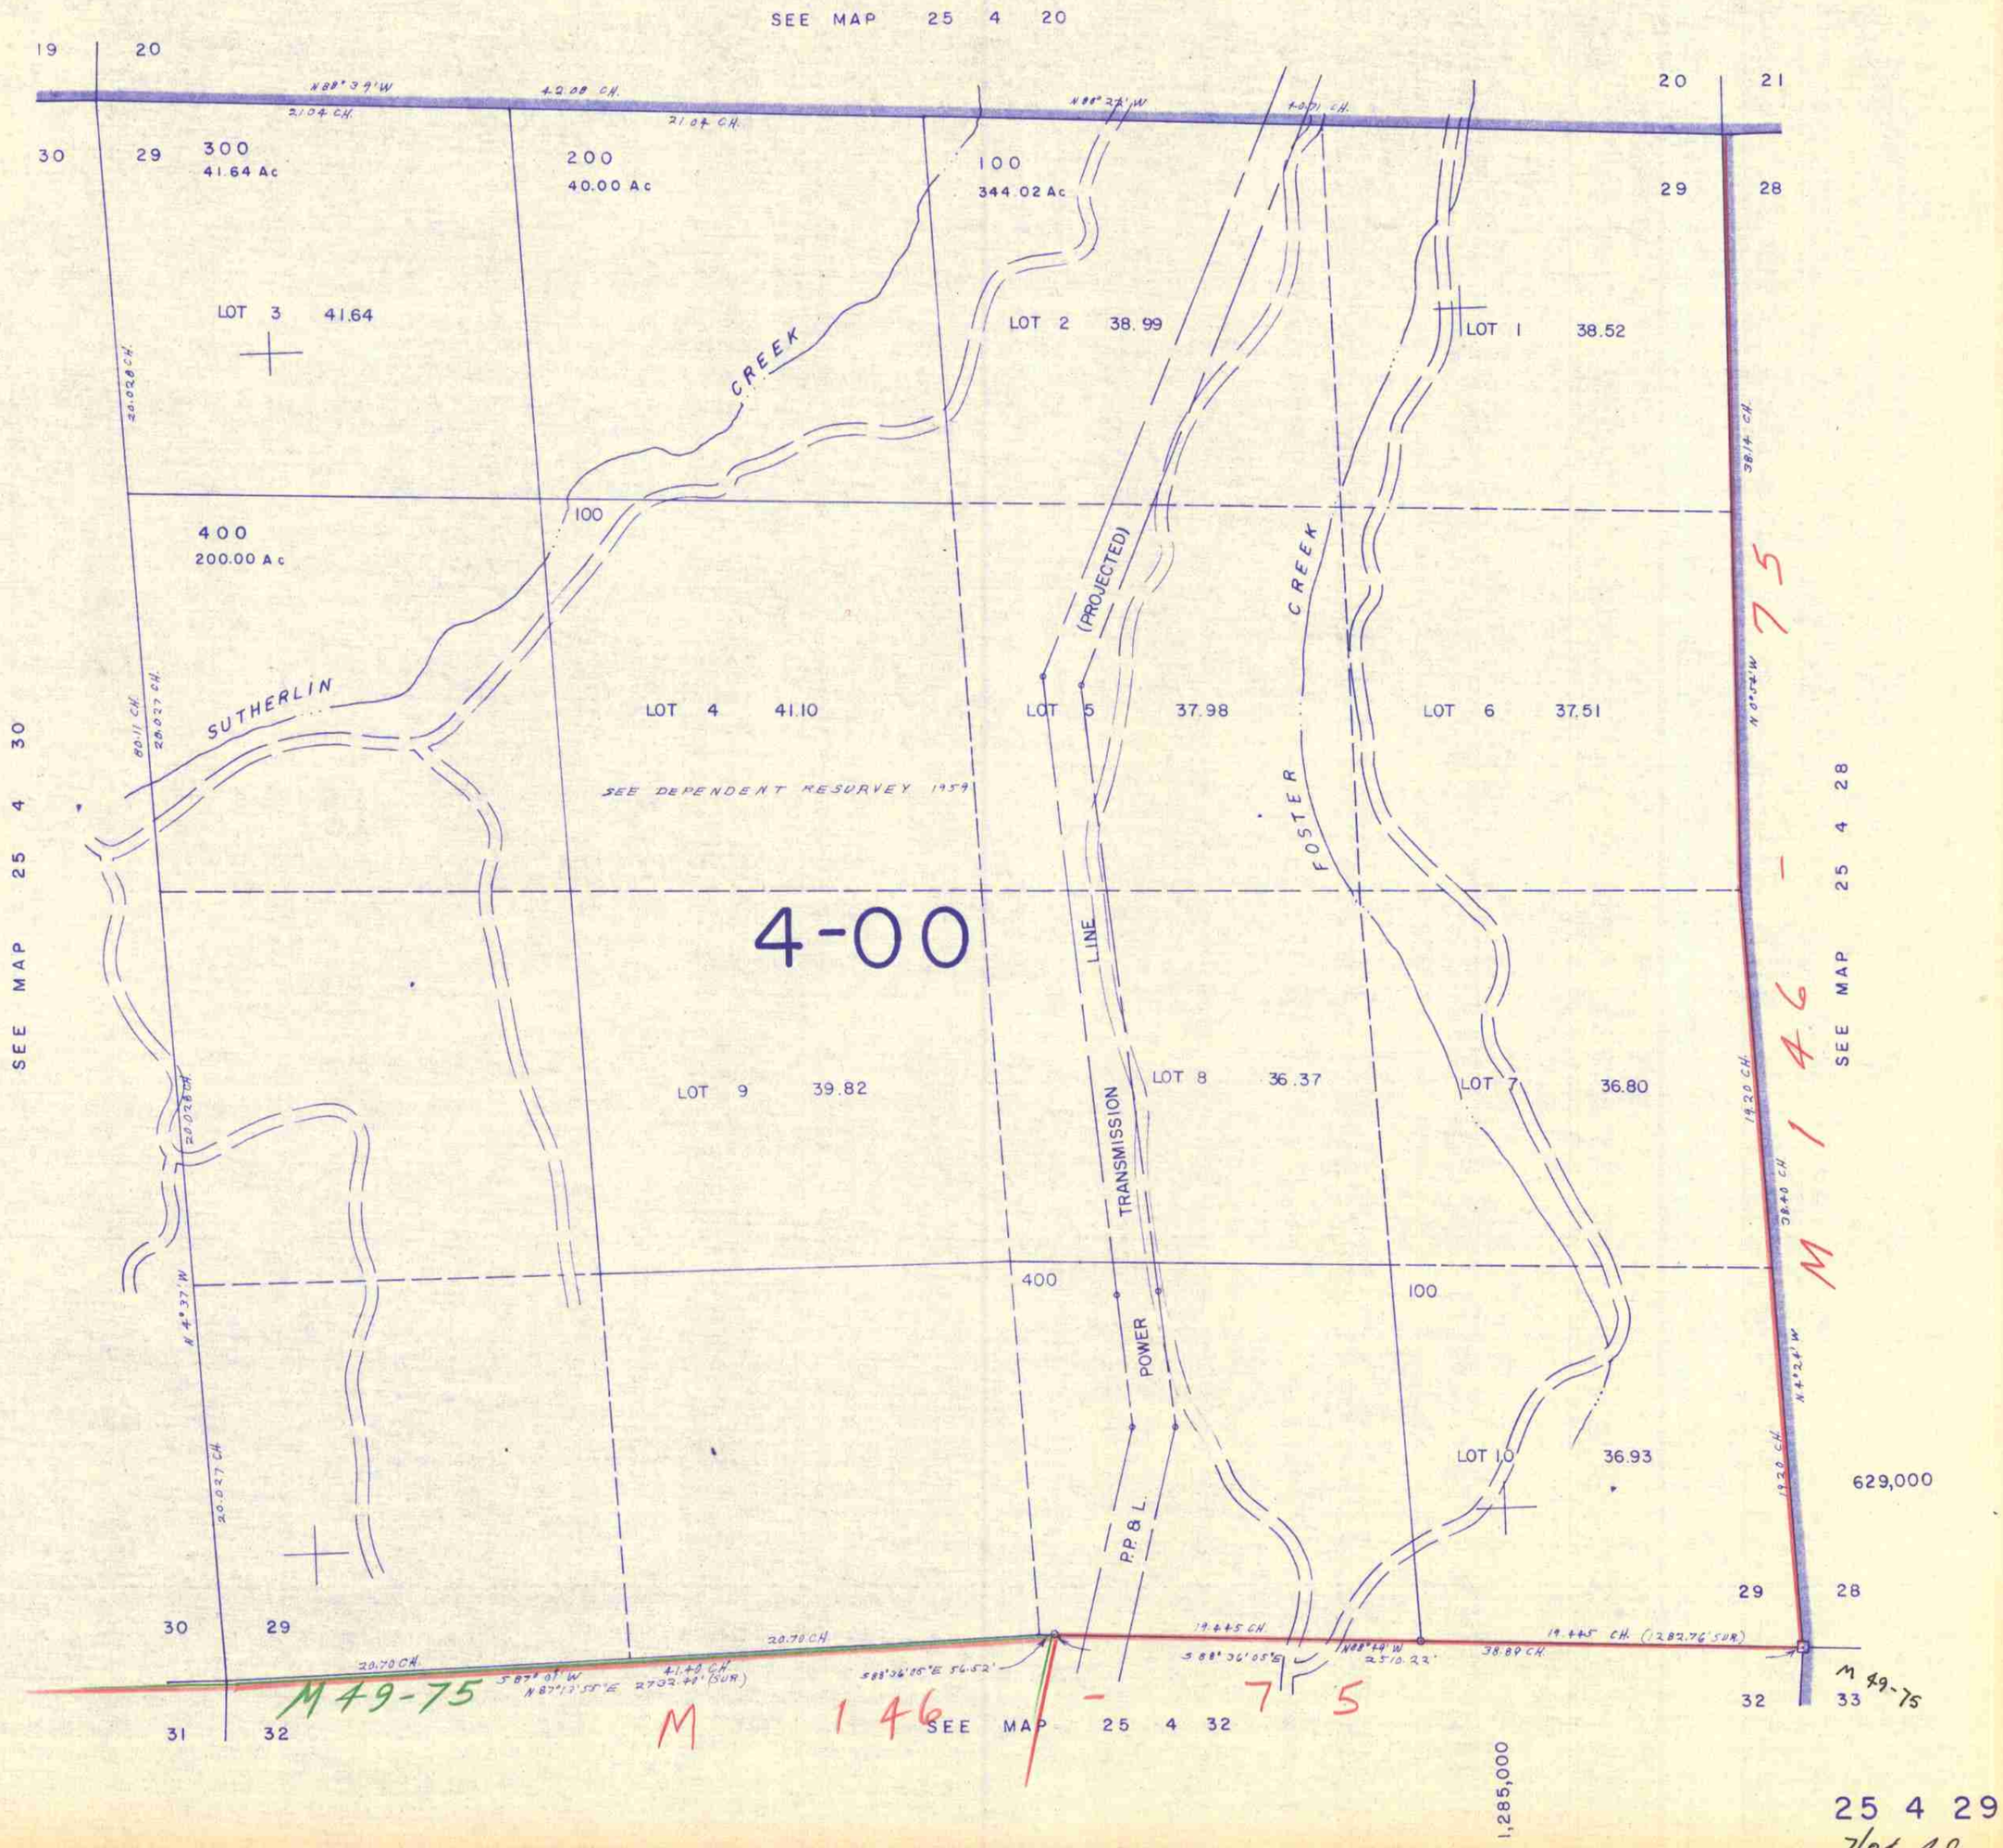
THIS MAP WAS PREPARED FOR ASSESSMENT PURPOSE ONLY.