SECTION 33 T.25S. R. 4 W. W.M.
DOUGLAS COUNTY

1" = 400'

THIS MAP WAS PREPARED FOR ASSESSMENT PURPOSE ONLY.

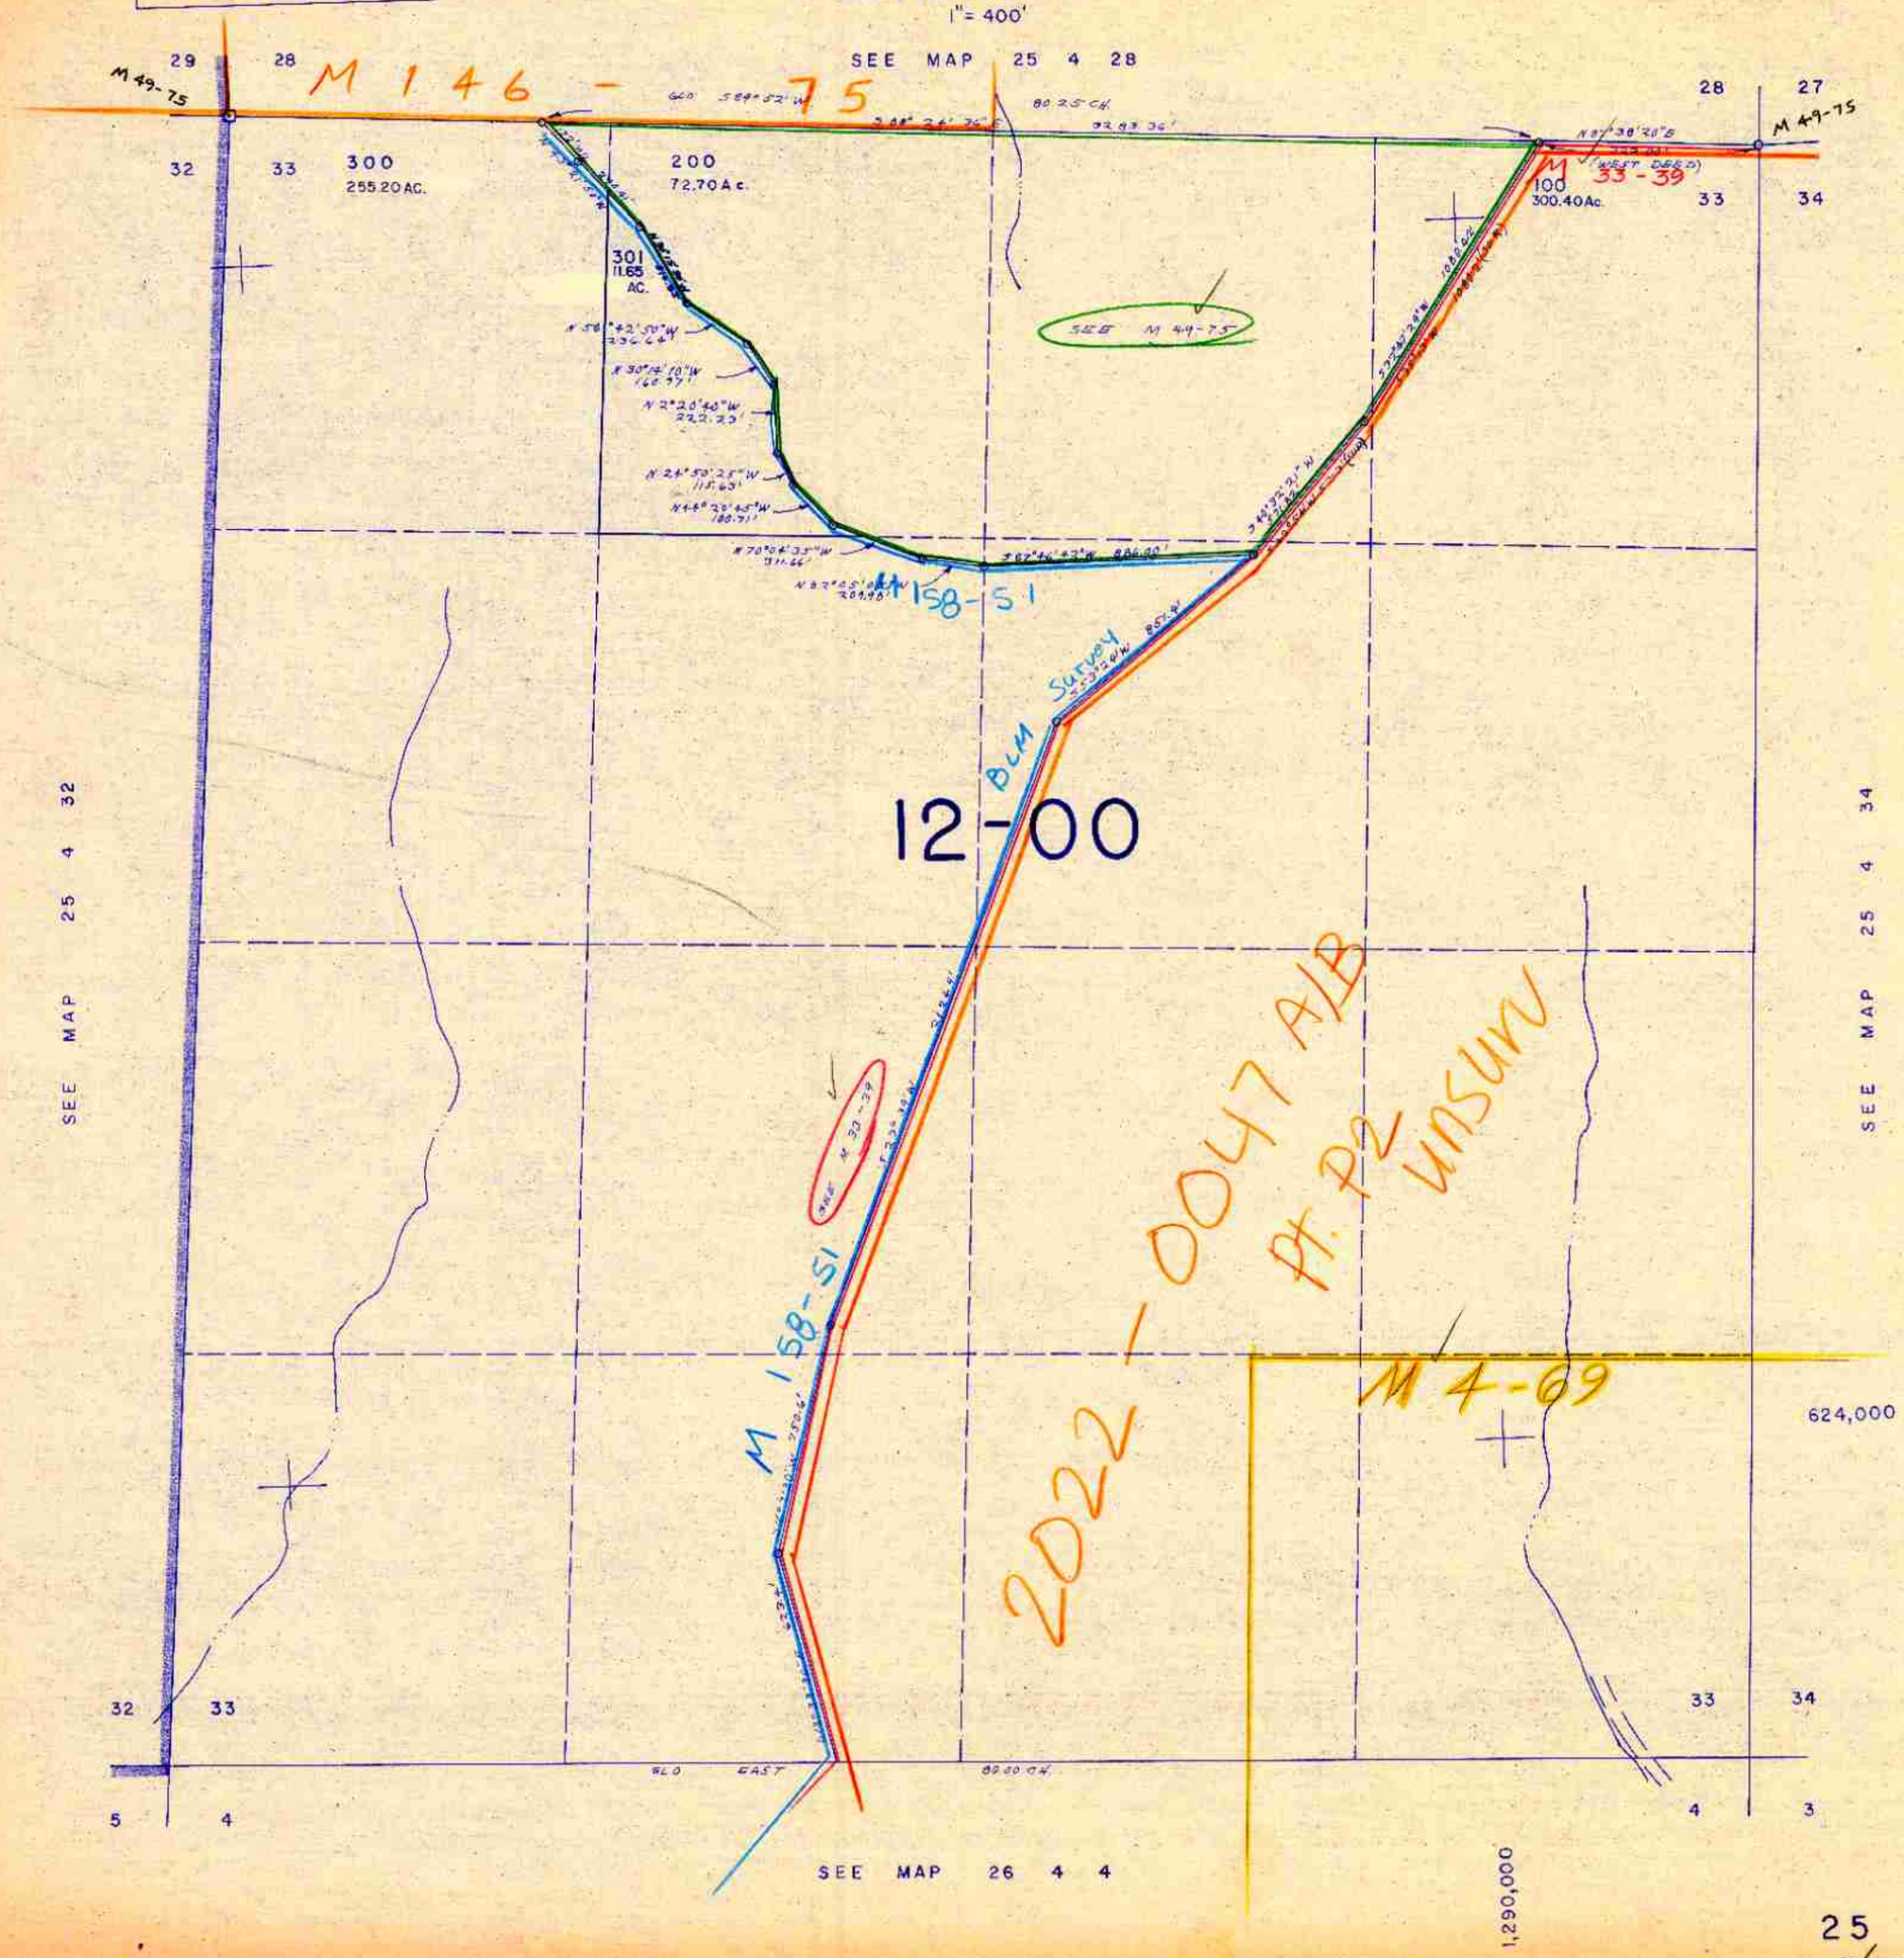

7/84 BS