THIS MAP WAS PREPARED FOR ASSESSMENT PURPOSE ONLY.

# SEC.1 T.25S. R.5W. W.M.
## DOUGLAS COUNTY
1" = 400'

REVISED ON 12-21-20



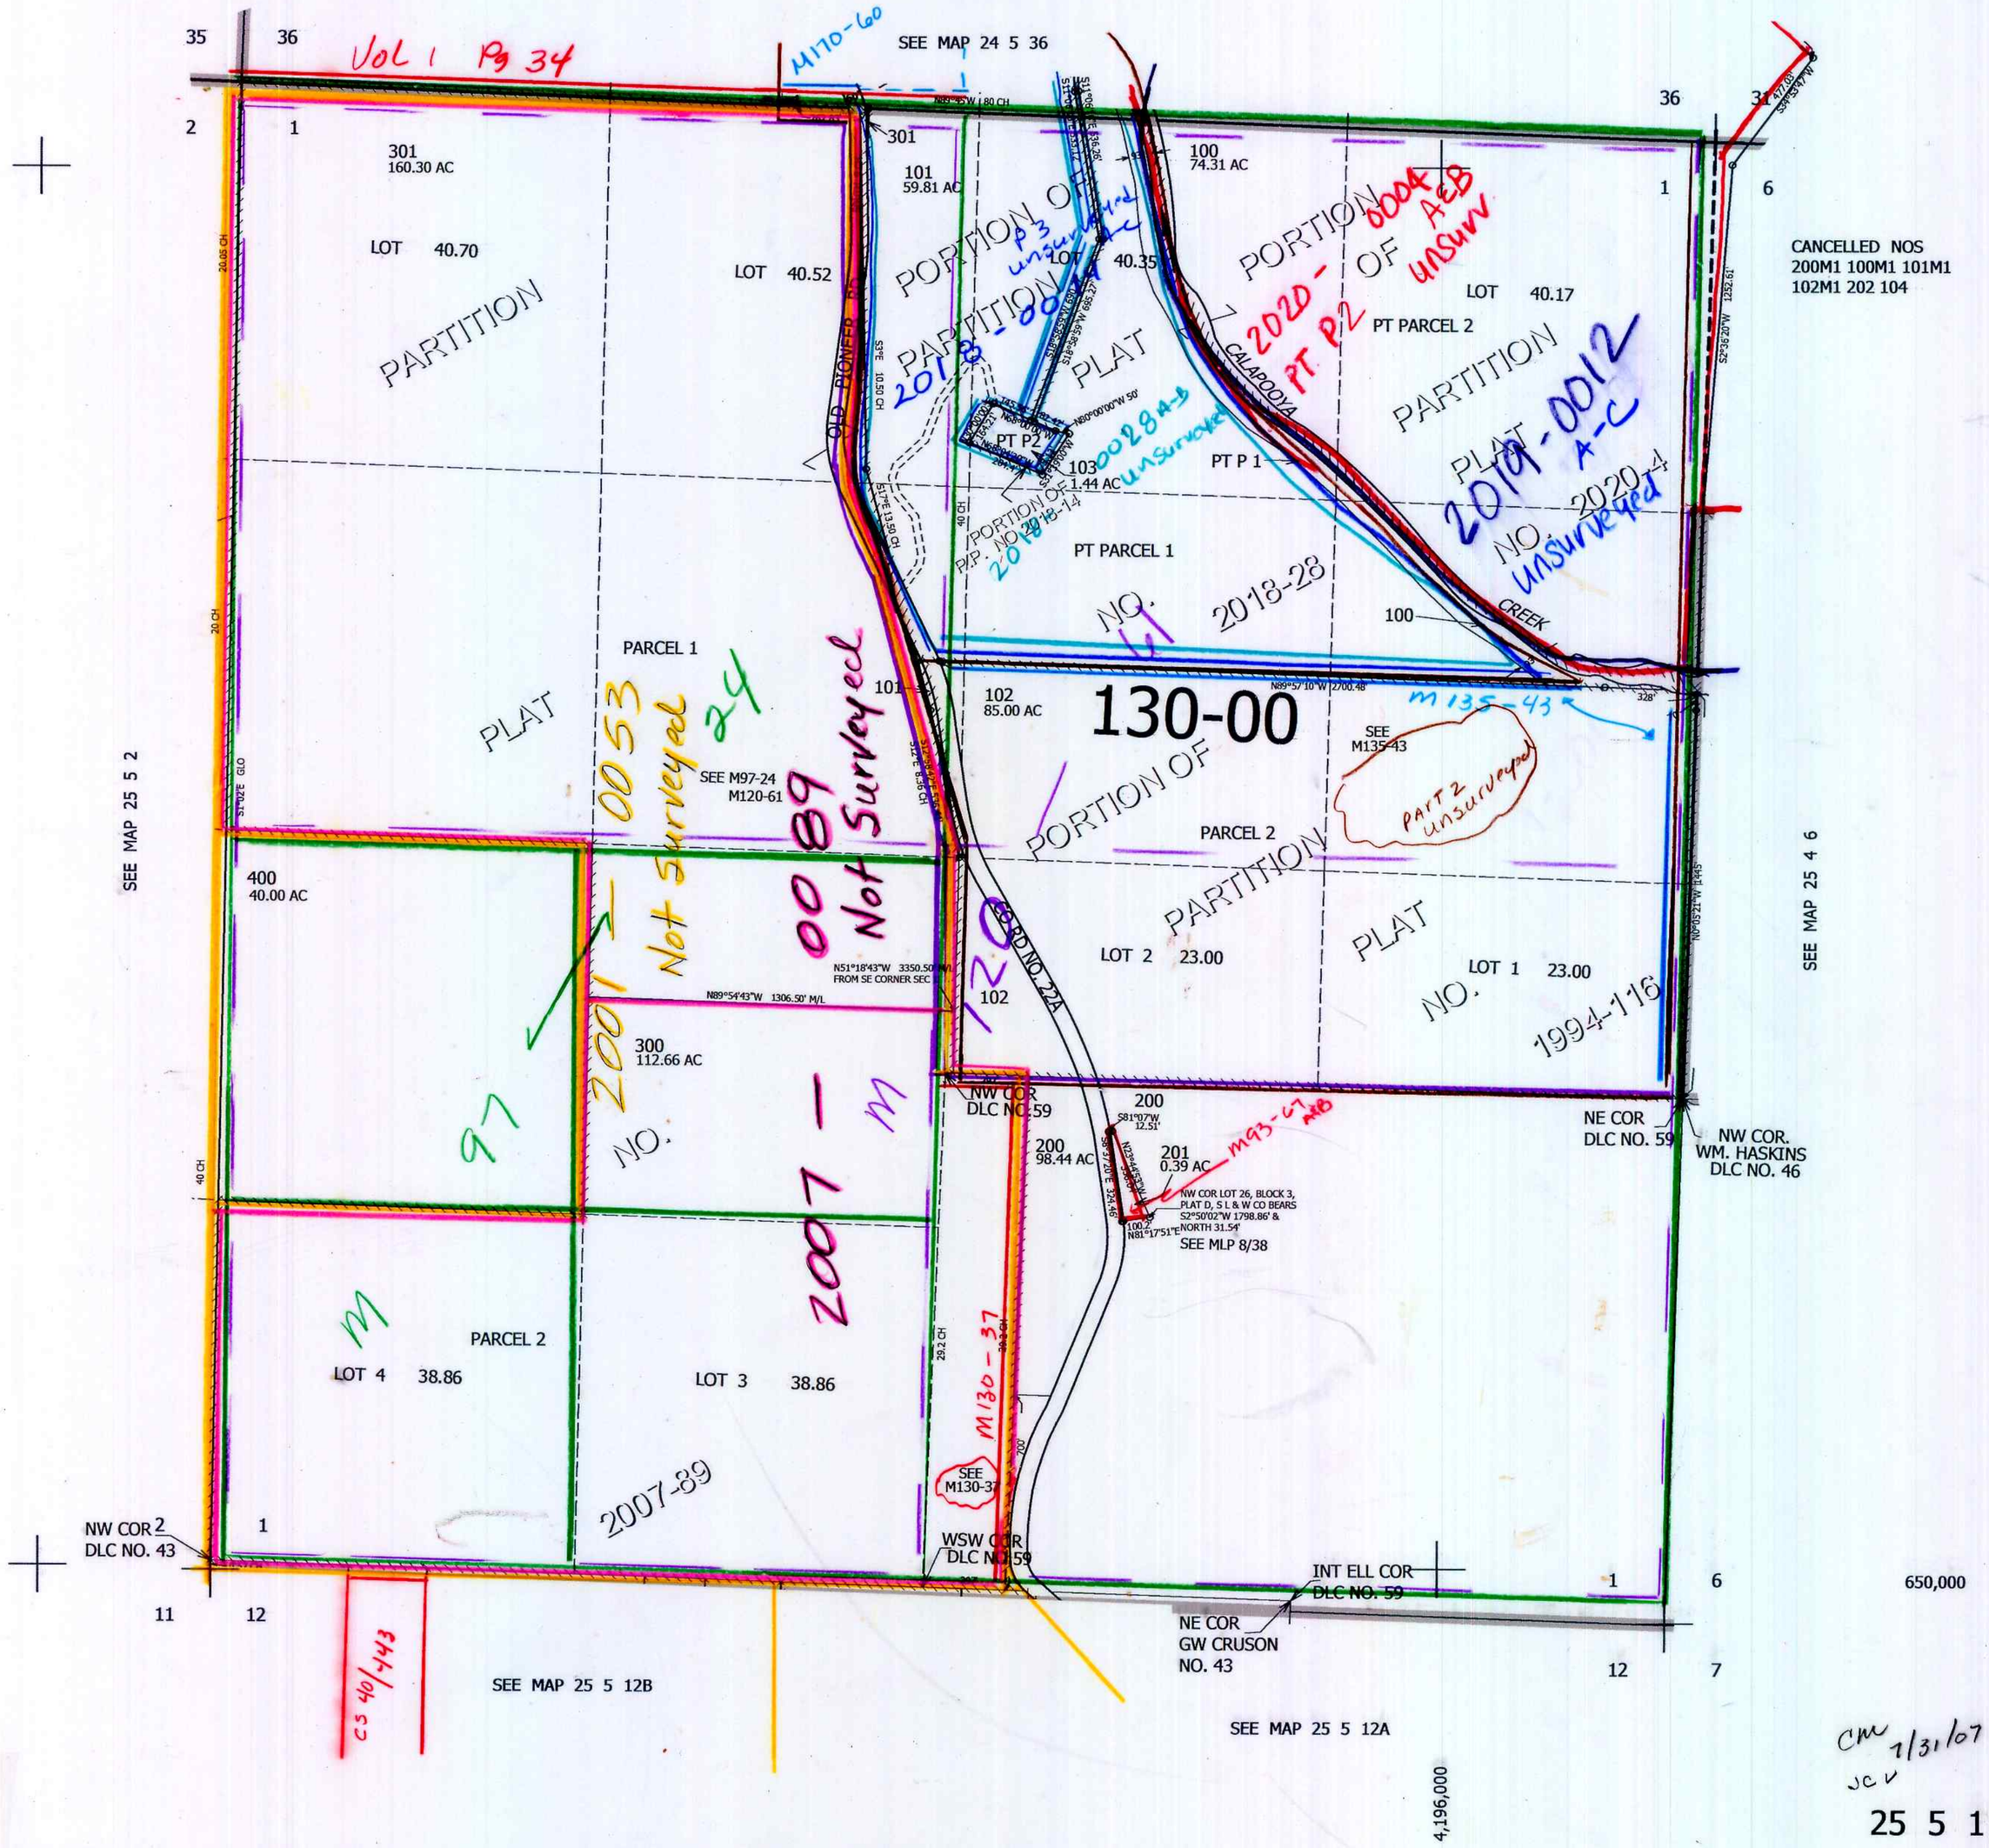


CM 1/31/07
JCV