NW1/4 NW1/4 SEC.3 T.25S. R.5W. W.M.
DOUGLAS COUNTY

1"=100'

THIS MAP WAS PREPARED FOR ASSESSMENT PURPOSE ONLY.

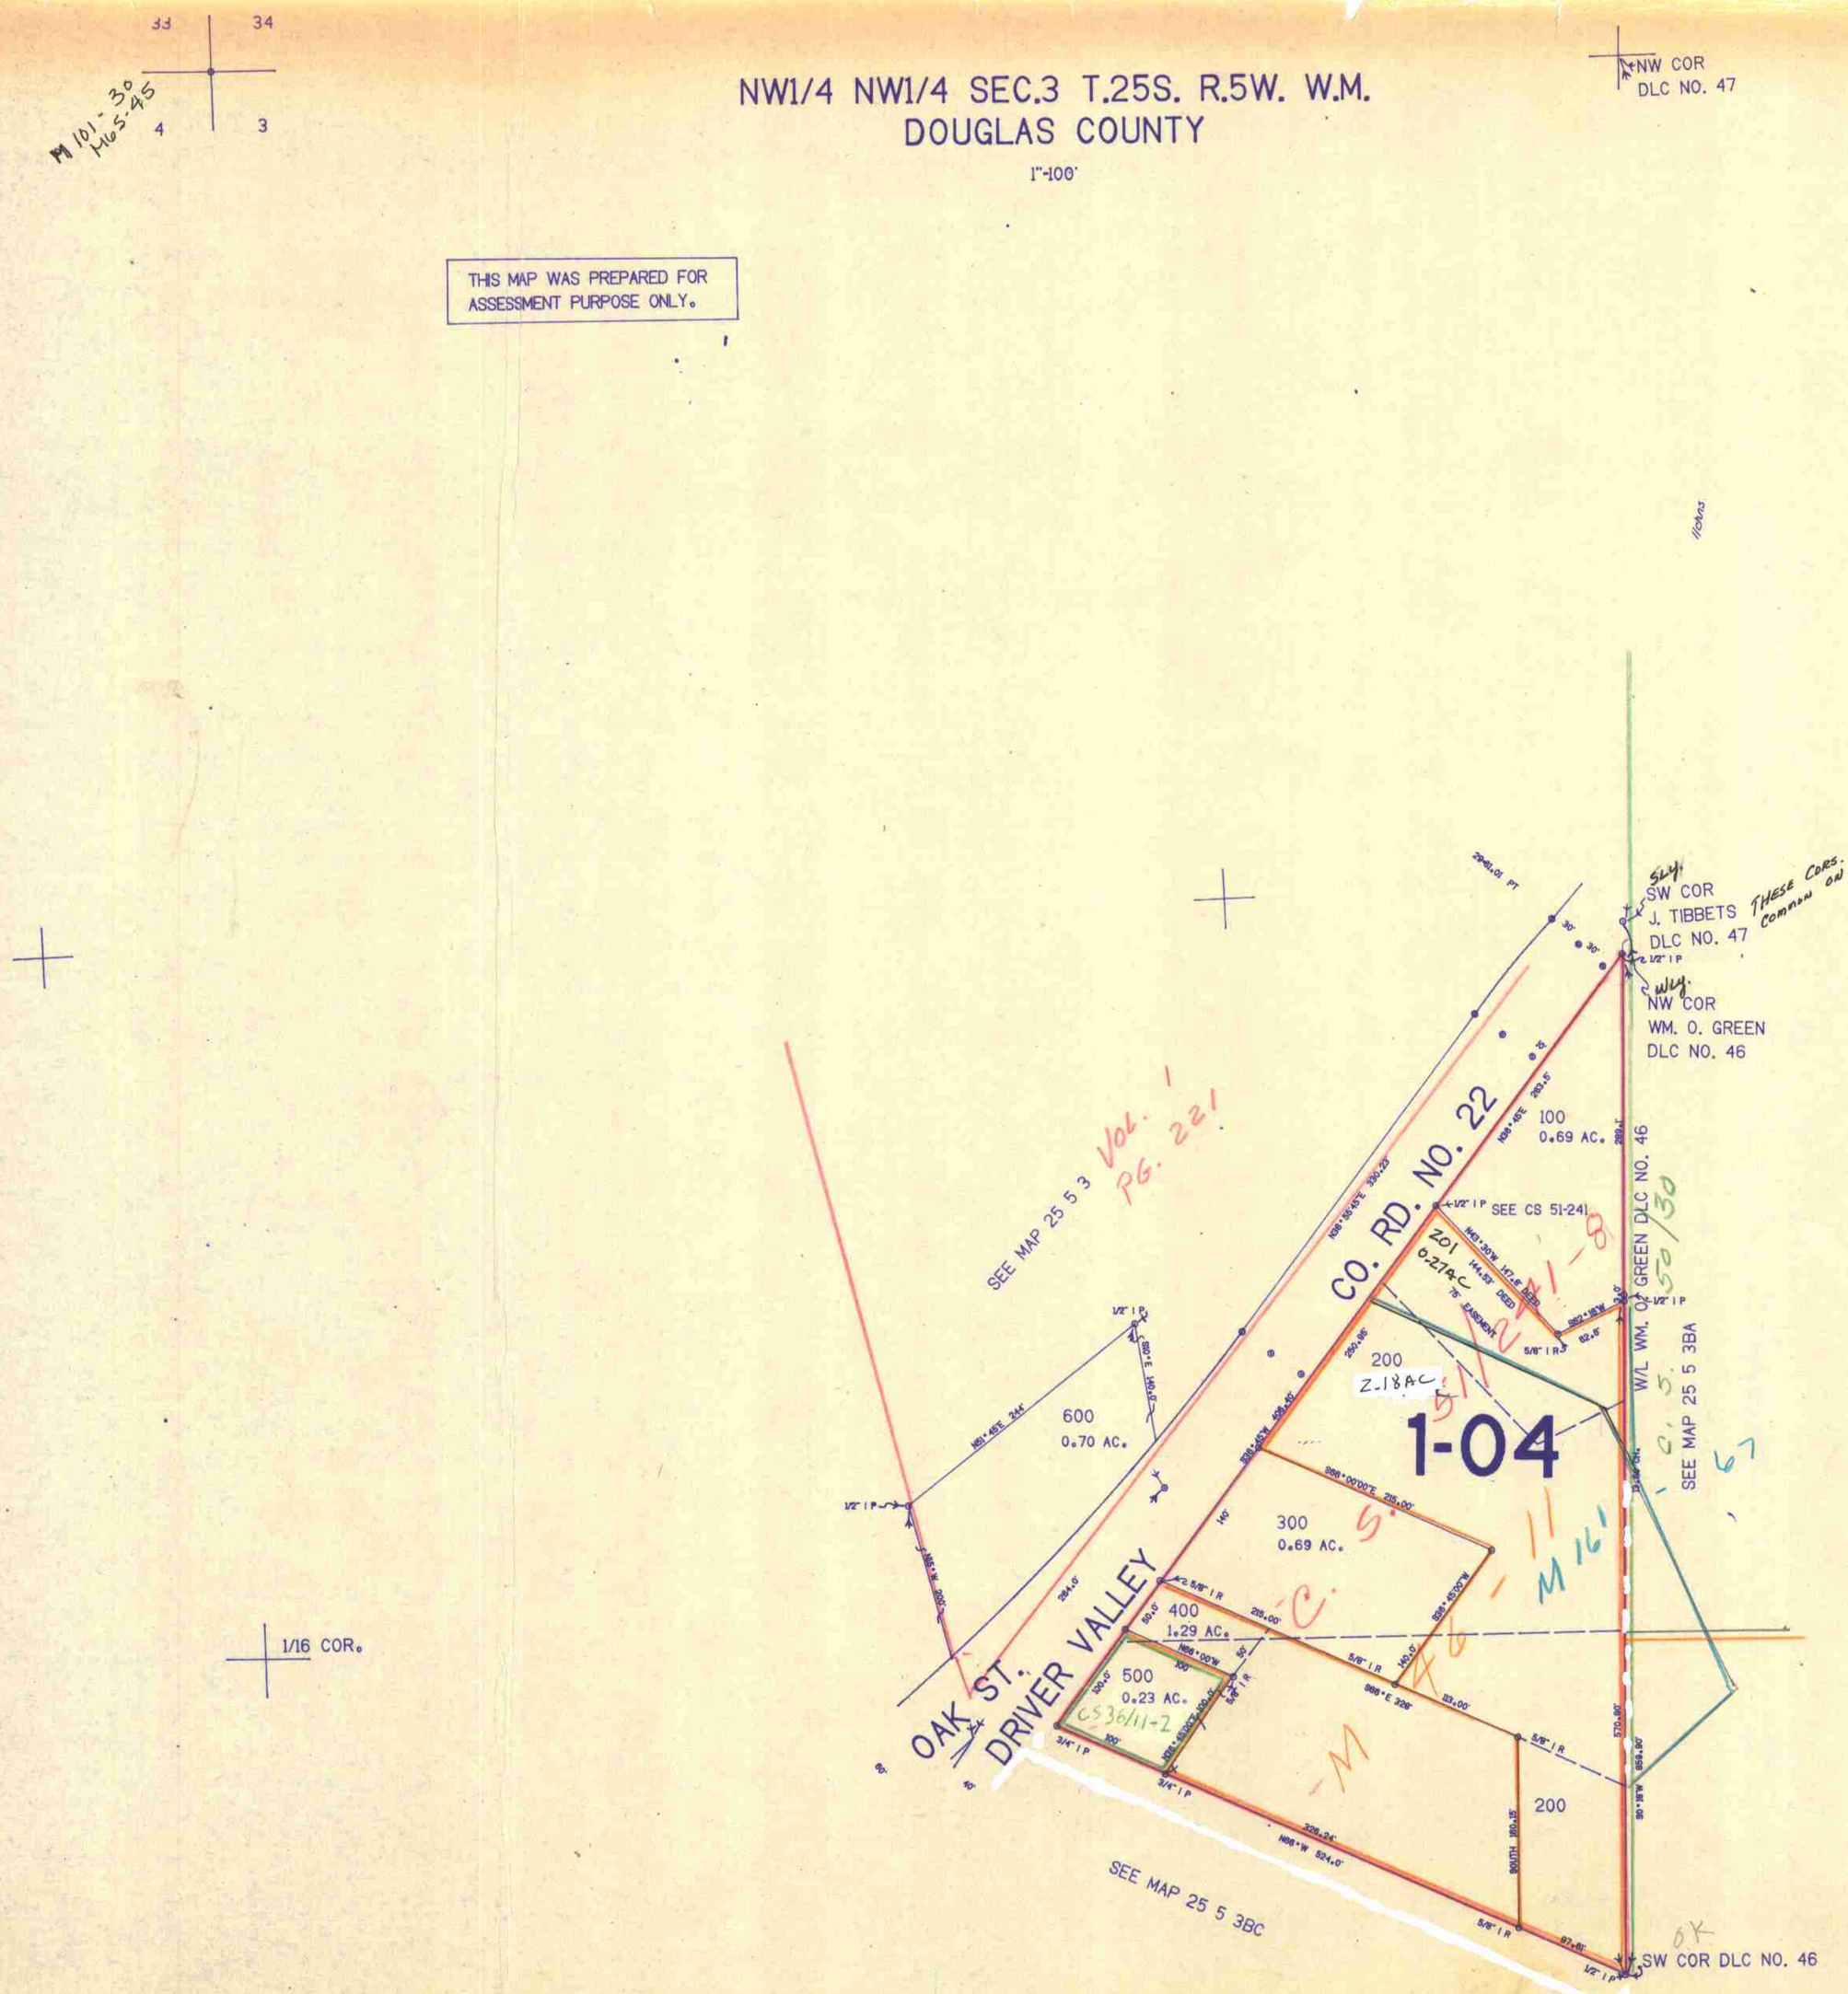

CONTROL III 8-79 LAYOUT BC 9 TRACED ST 2-80 CHECKED TS 12-79