


THIS MAP WAS PREPARED FOR  
ASSESSMENT PURPOSE ONLY

SW1/4 NW1/4 SEC. 3 T.25S. R. 5W W.M.  
DOUGLAS COUNTY

REVISED ON  
6-26-01

25 5 3BC

1"=100'

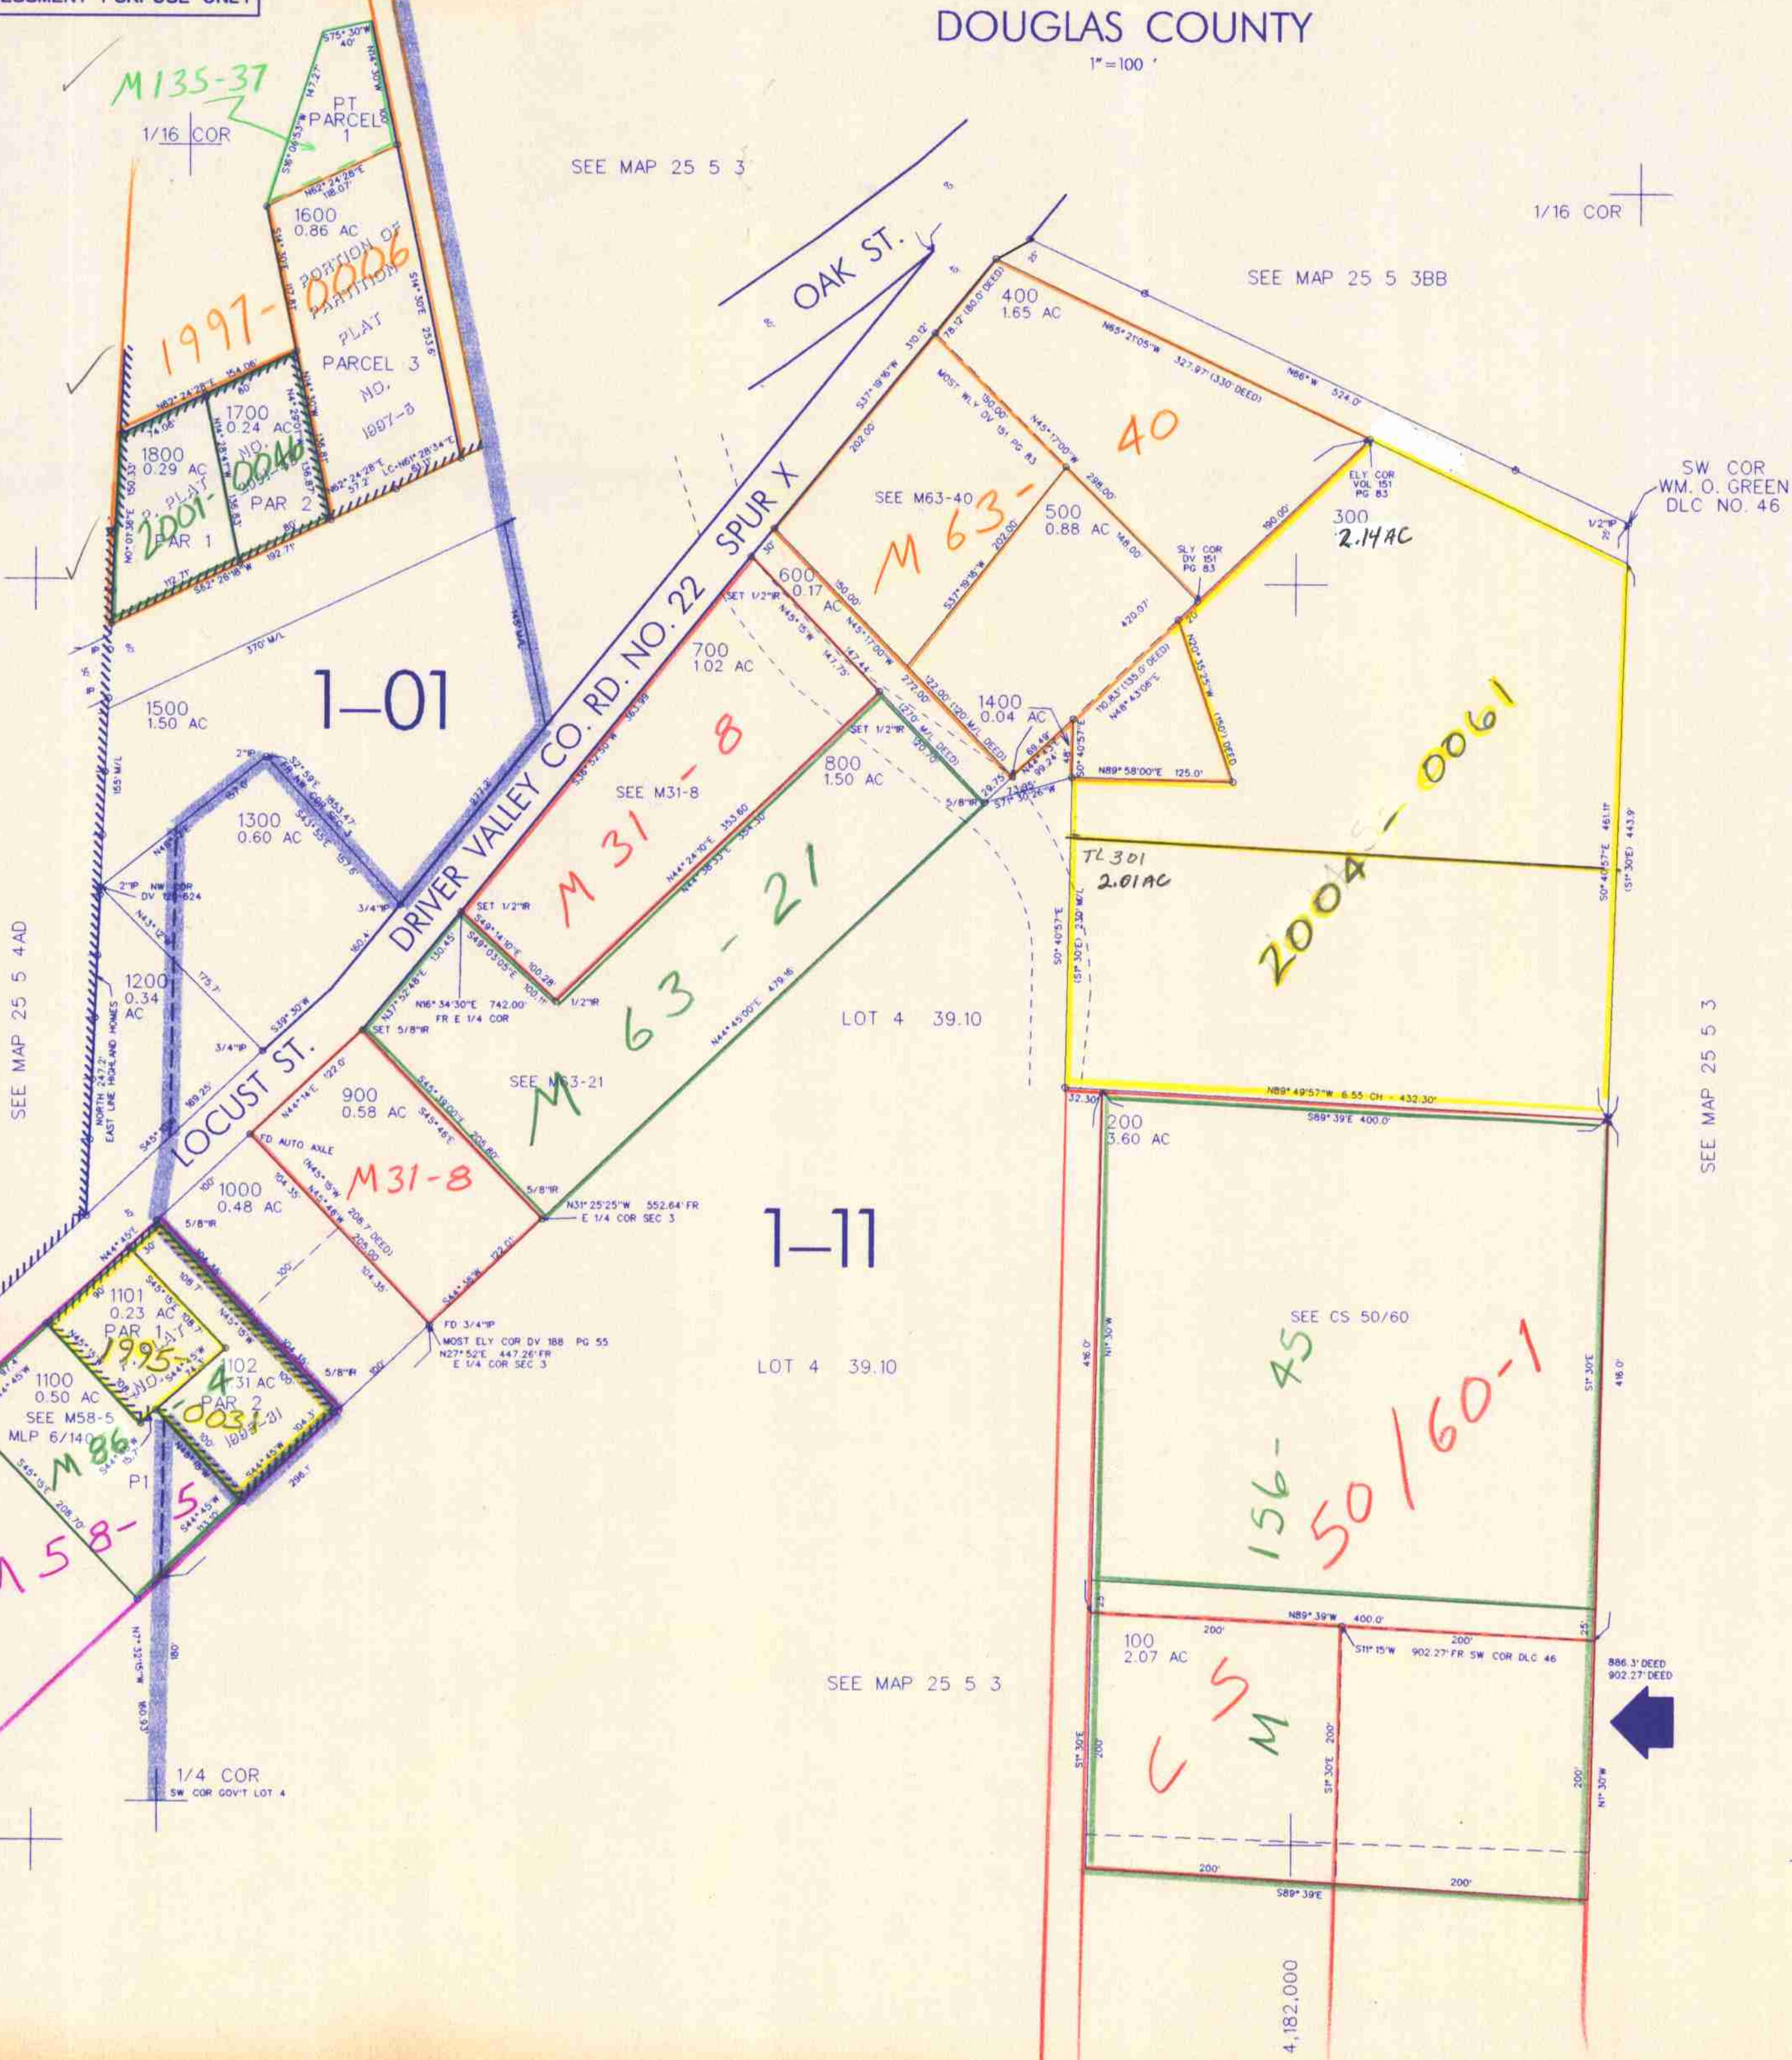

SEE MAP 25 5 3

SEE MAP 25 5 3BB

1/16 COR

SW COR  
WM. O. GREEN  
DLC NO. 46

CANCELLED NO'S

SEE MAP 25 5 4AD

SEE MAP 25 5 3

1-11

LOT 4 39.10

SEE MAP 25 5 3

653,000

25 5 3BC

1/01 SP  
VNW