


SECTION 11 T.25S. R.5W. W.M.  
DOUGLAS COUNTY

25 5 11  
& INDEX

THIS MAP WAS PREPARED FOR  
ASSESSMENT PURPOSE ONLY.

1"=400'

SEE MAP 25 5 2

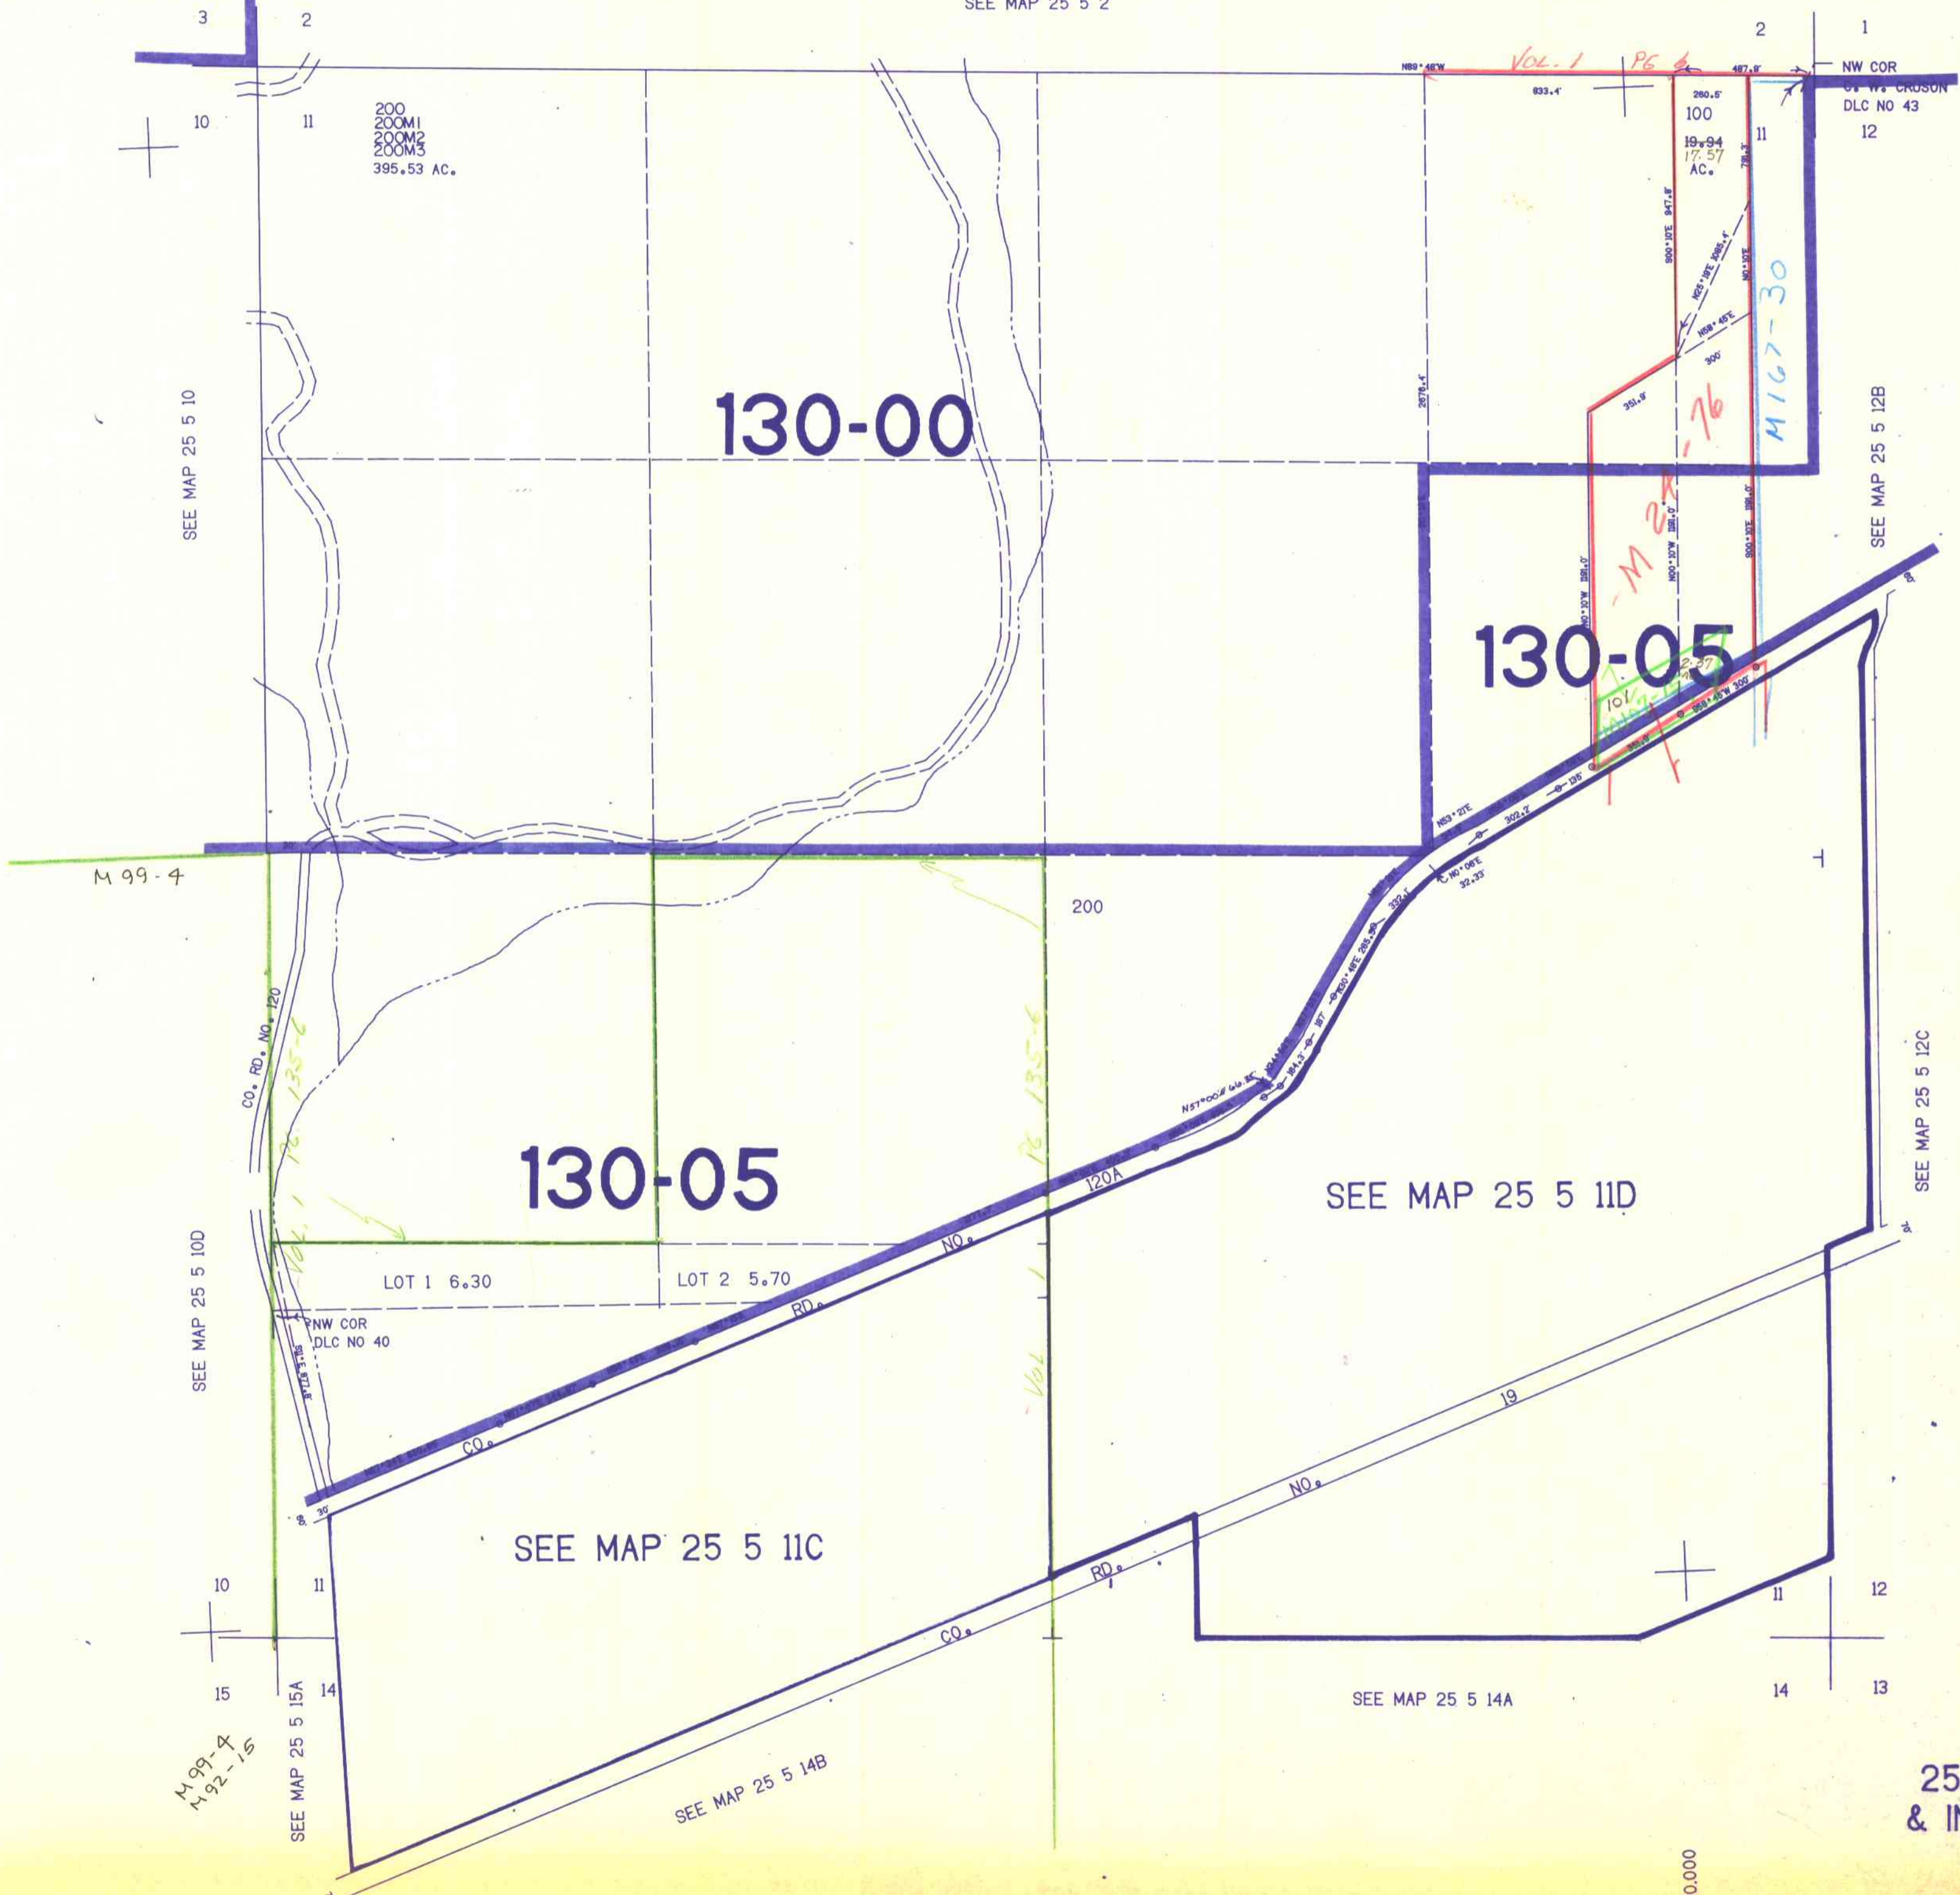

M 99-4  
M 92-15

25 5 11  
& INDEX

645.000

270.000

8/20/18