THIS MAP WAS PREPARED FOR ASSESSMENT PURPOSE ONLY

SW1/4 NE1/4 SEC. 16 T.25S. R. 5W W.M.
DOUGLAS COUNTY
1"=100'

25 5 16AC
SUTHERLIN

REVISED ON 12-13-00

CANCELLED NO'S

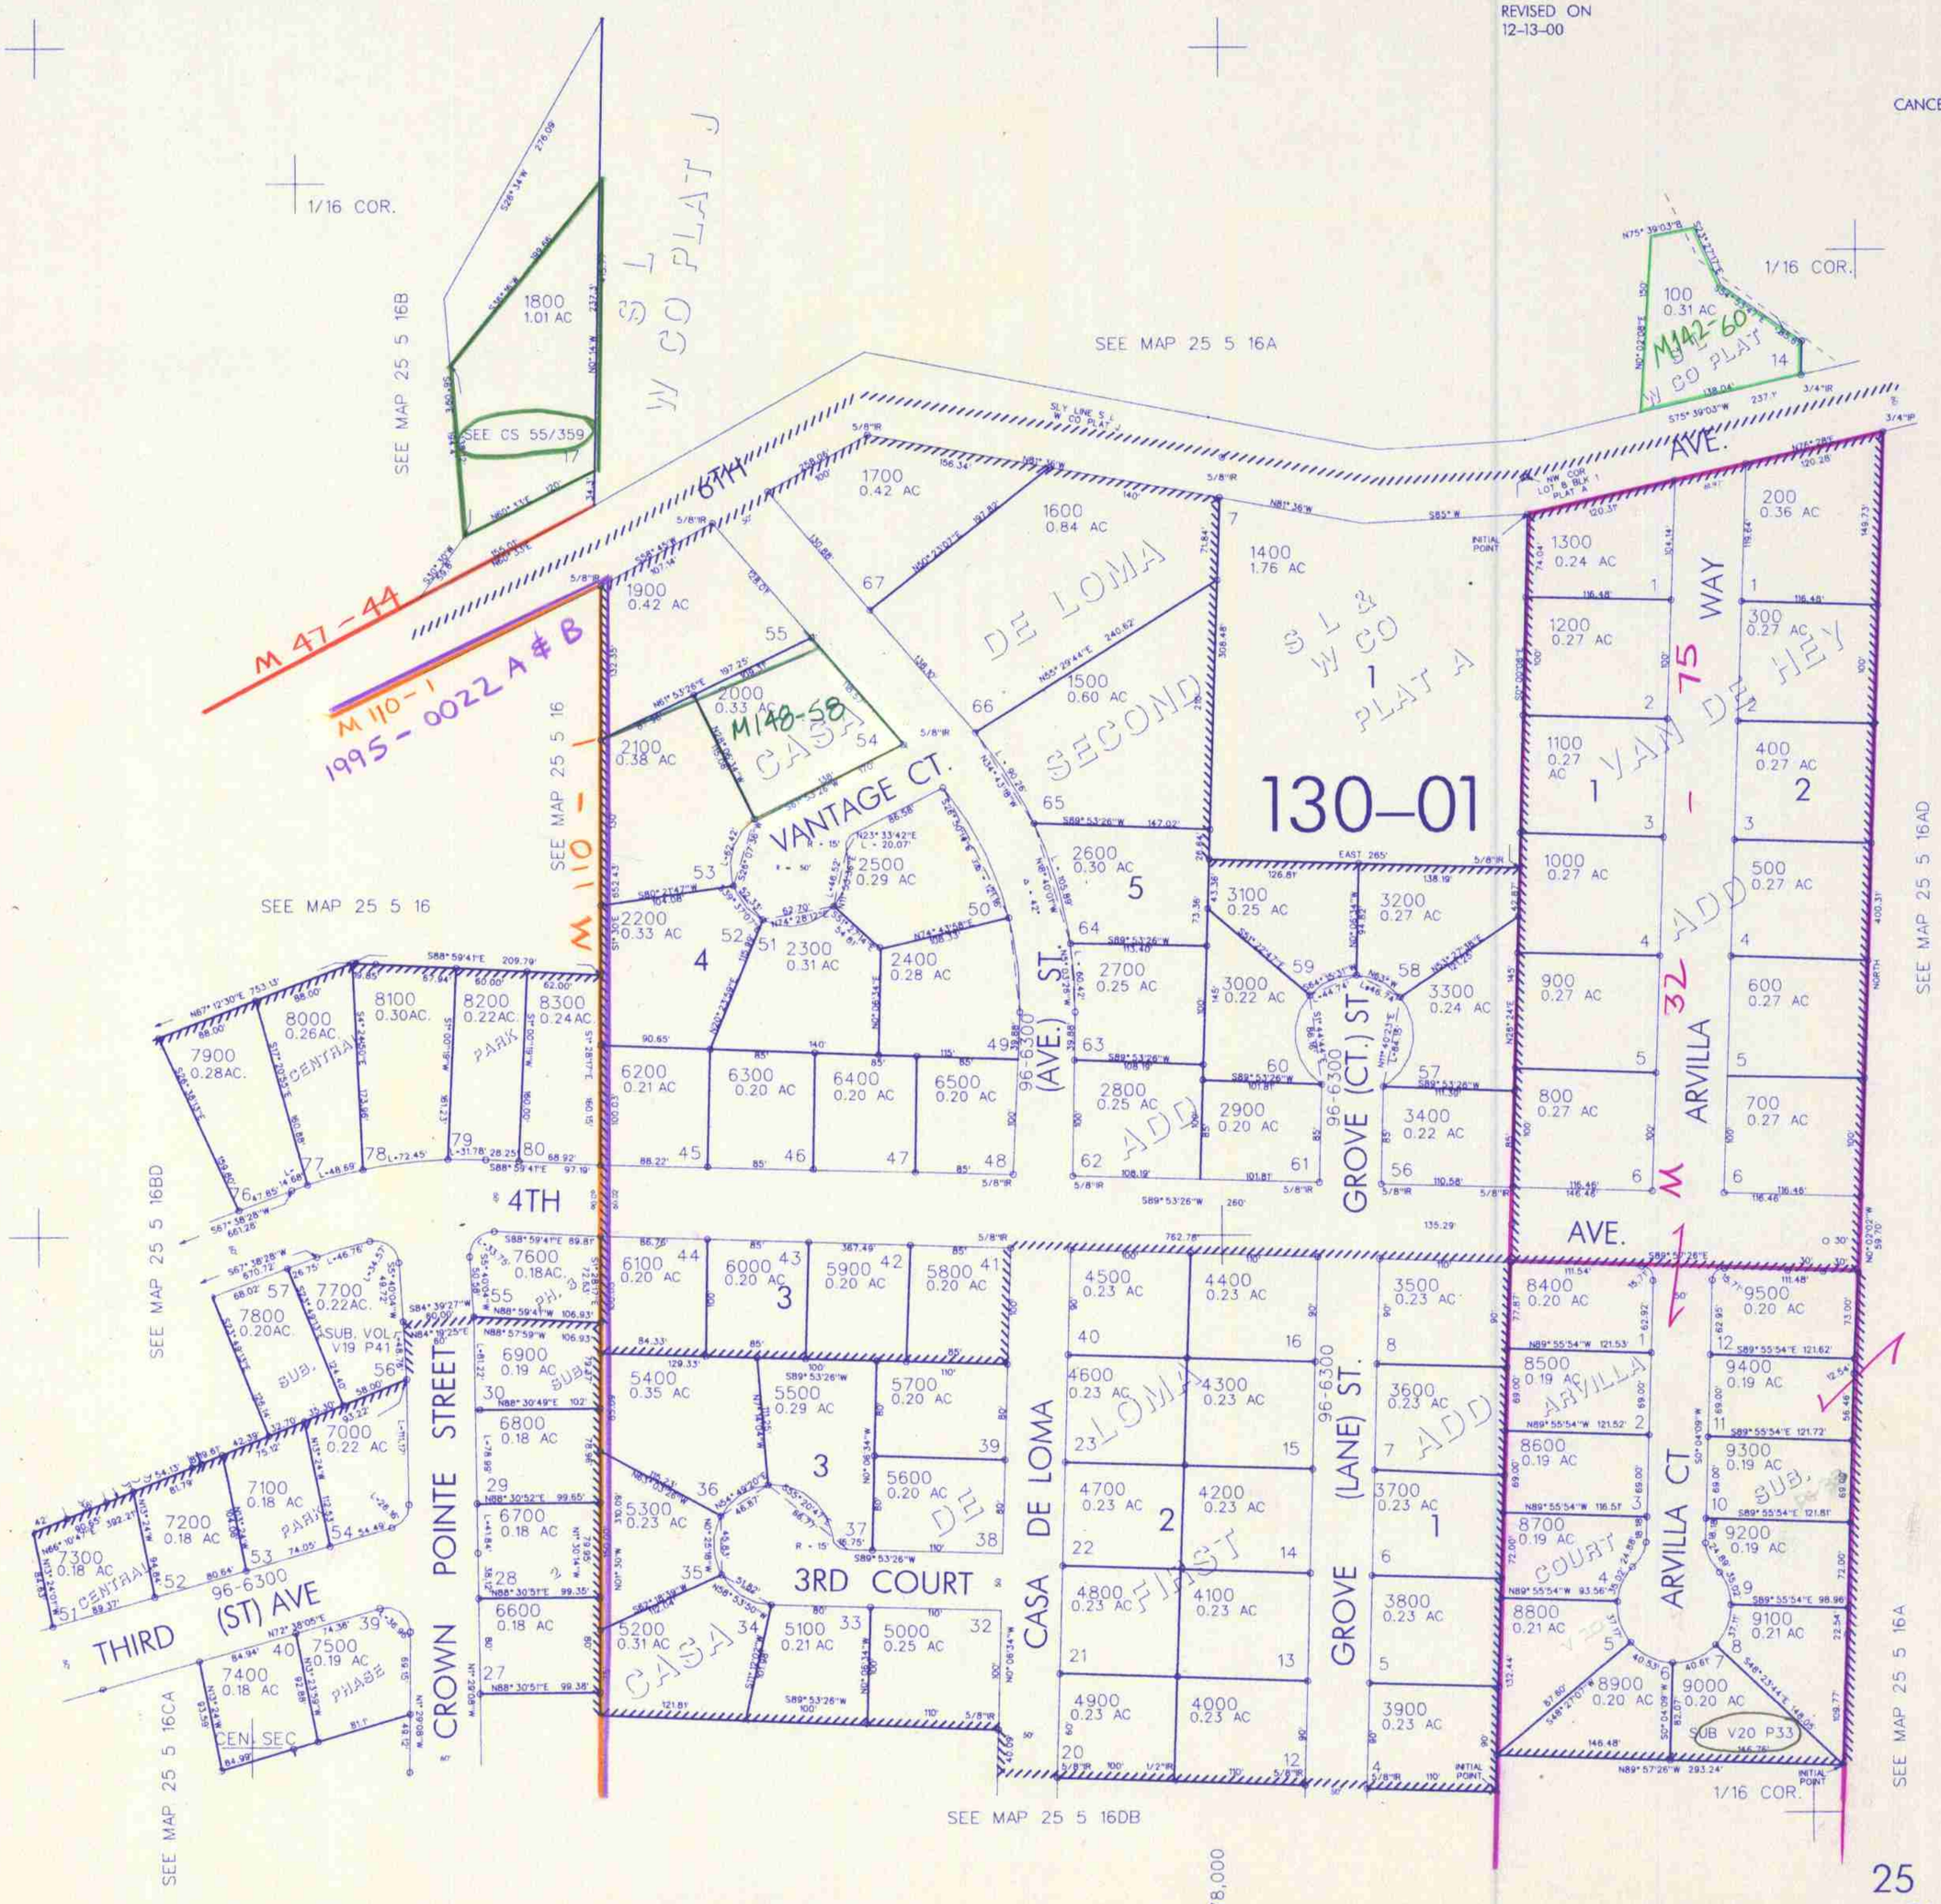

25 5 16AC
SUTHERLIN

12-2000