

THIS MAP WAS PREPARED FOR
ASSESSMENT PURPOSE ONLY

SE1/4 NW1/4 SEC. 16 T.25S. R. 5W W.M.
DOUGLAS COUNTY

25 5 16BD
SUTHERLIN

1"=100'

REVISED ON
6-17-98


1/16 COR.

1/16 COR.

CANCELLED NO'S
200 300MI 400MI
3201 3401 3301
2201 3200, 300

SEE MAP 25 5 16B

130-01

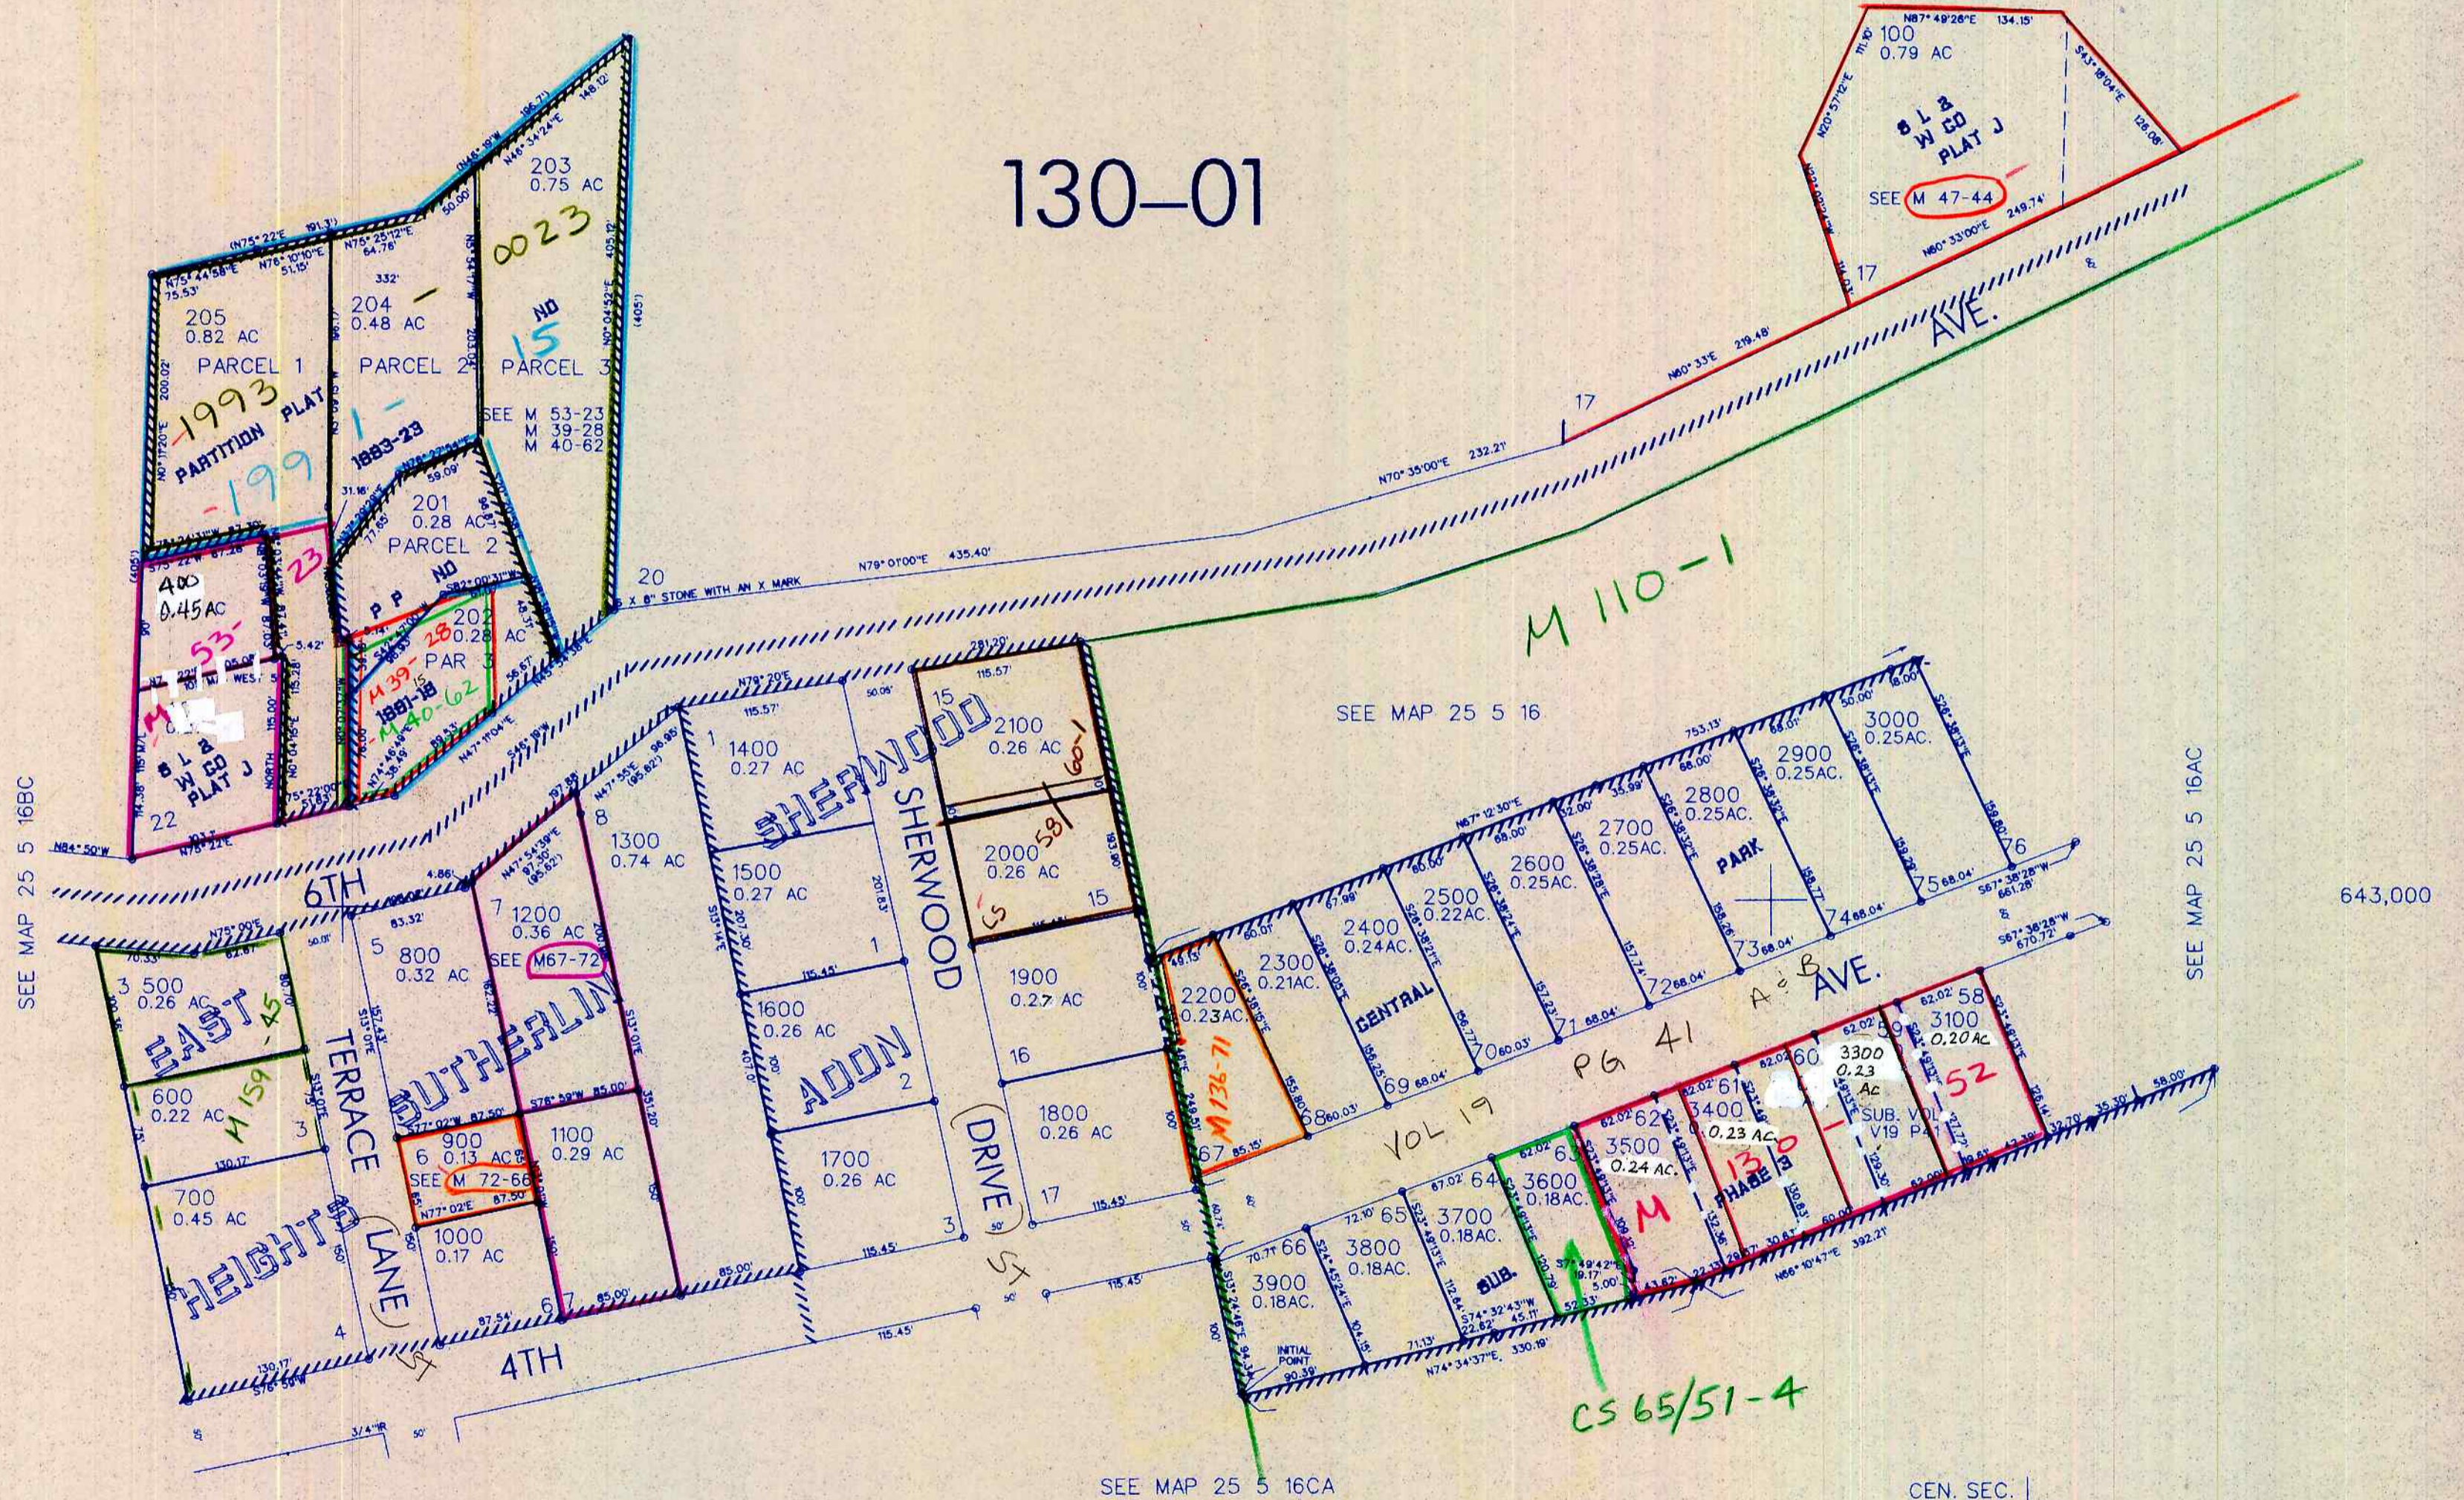

643,000

4,178,000

25 5 16BD
SUTHERLIN
7198
SC JP