

THIS MAP WAS PREPARED FOR ASSESSMENT PURPOSE ONLY.

SW1/4 SE1/4 SEC.17 T.25S. R.5W. W.M.
DOUGLAS COUNTY
1" = 100'

REVISED ON
12-14-16

25 5 17DC
SUTHERLIN

SEE MAP 25 5 17DB

1/16 COR

CANCELLED NOS
9800A1 3200A1 6900A1
7800A1 12700M1 3502
8600A1 12701 10301
8300 6101 10401 15900

SEE MAP 25 5 17DD

640,500

1/16 COR


25 5 17DC
SUTHERLIN

4,174,000

SEE MAP 25 5 20BA

SEE MAP 25 5 20AB

see Calapooia

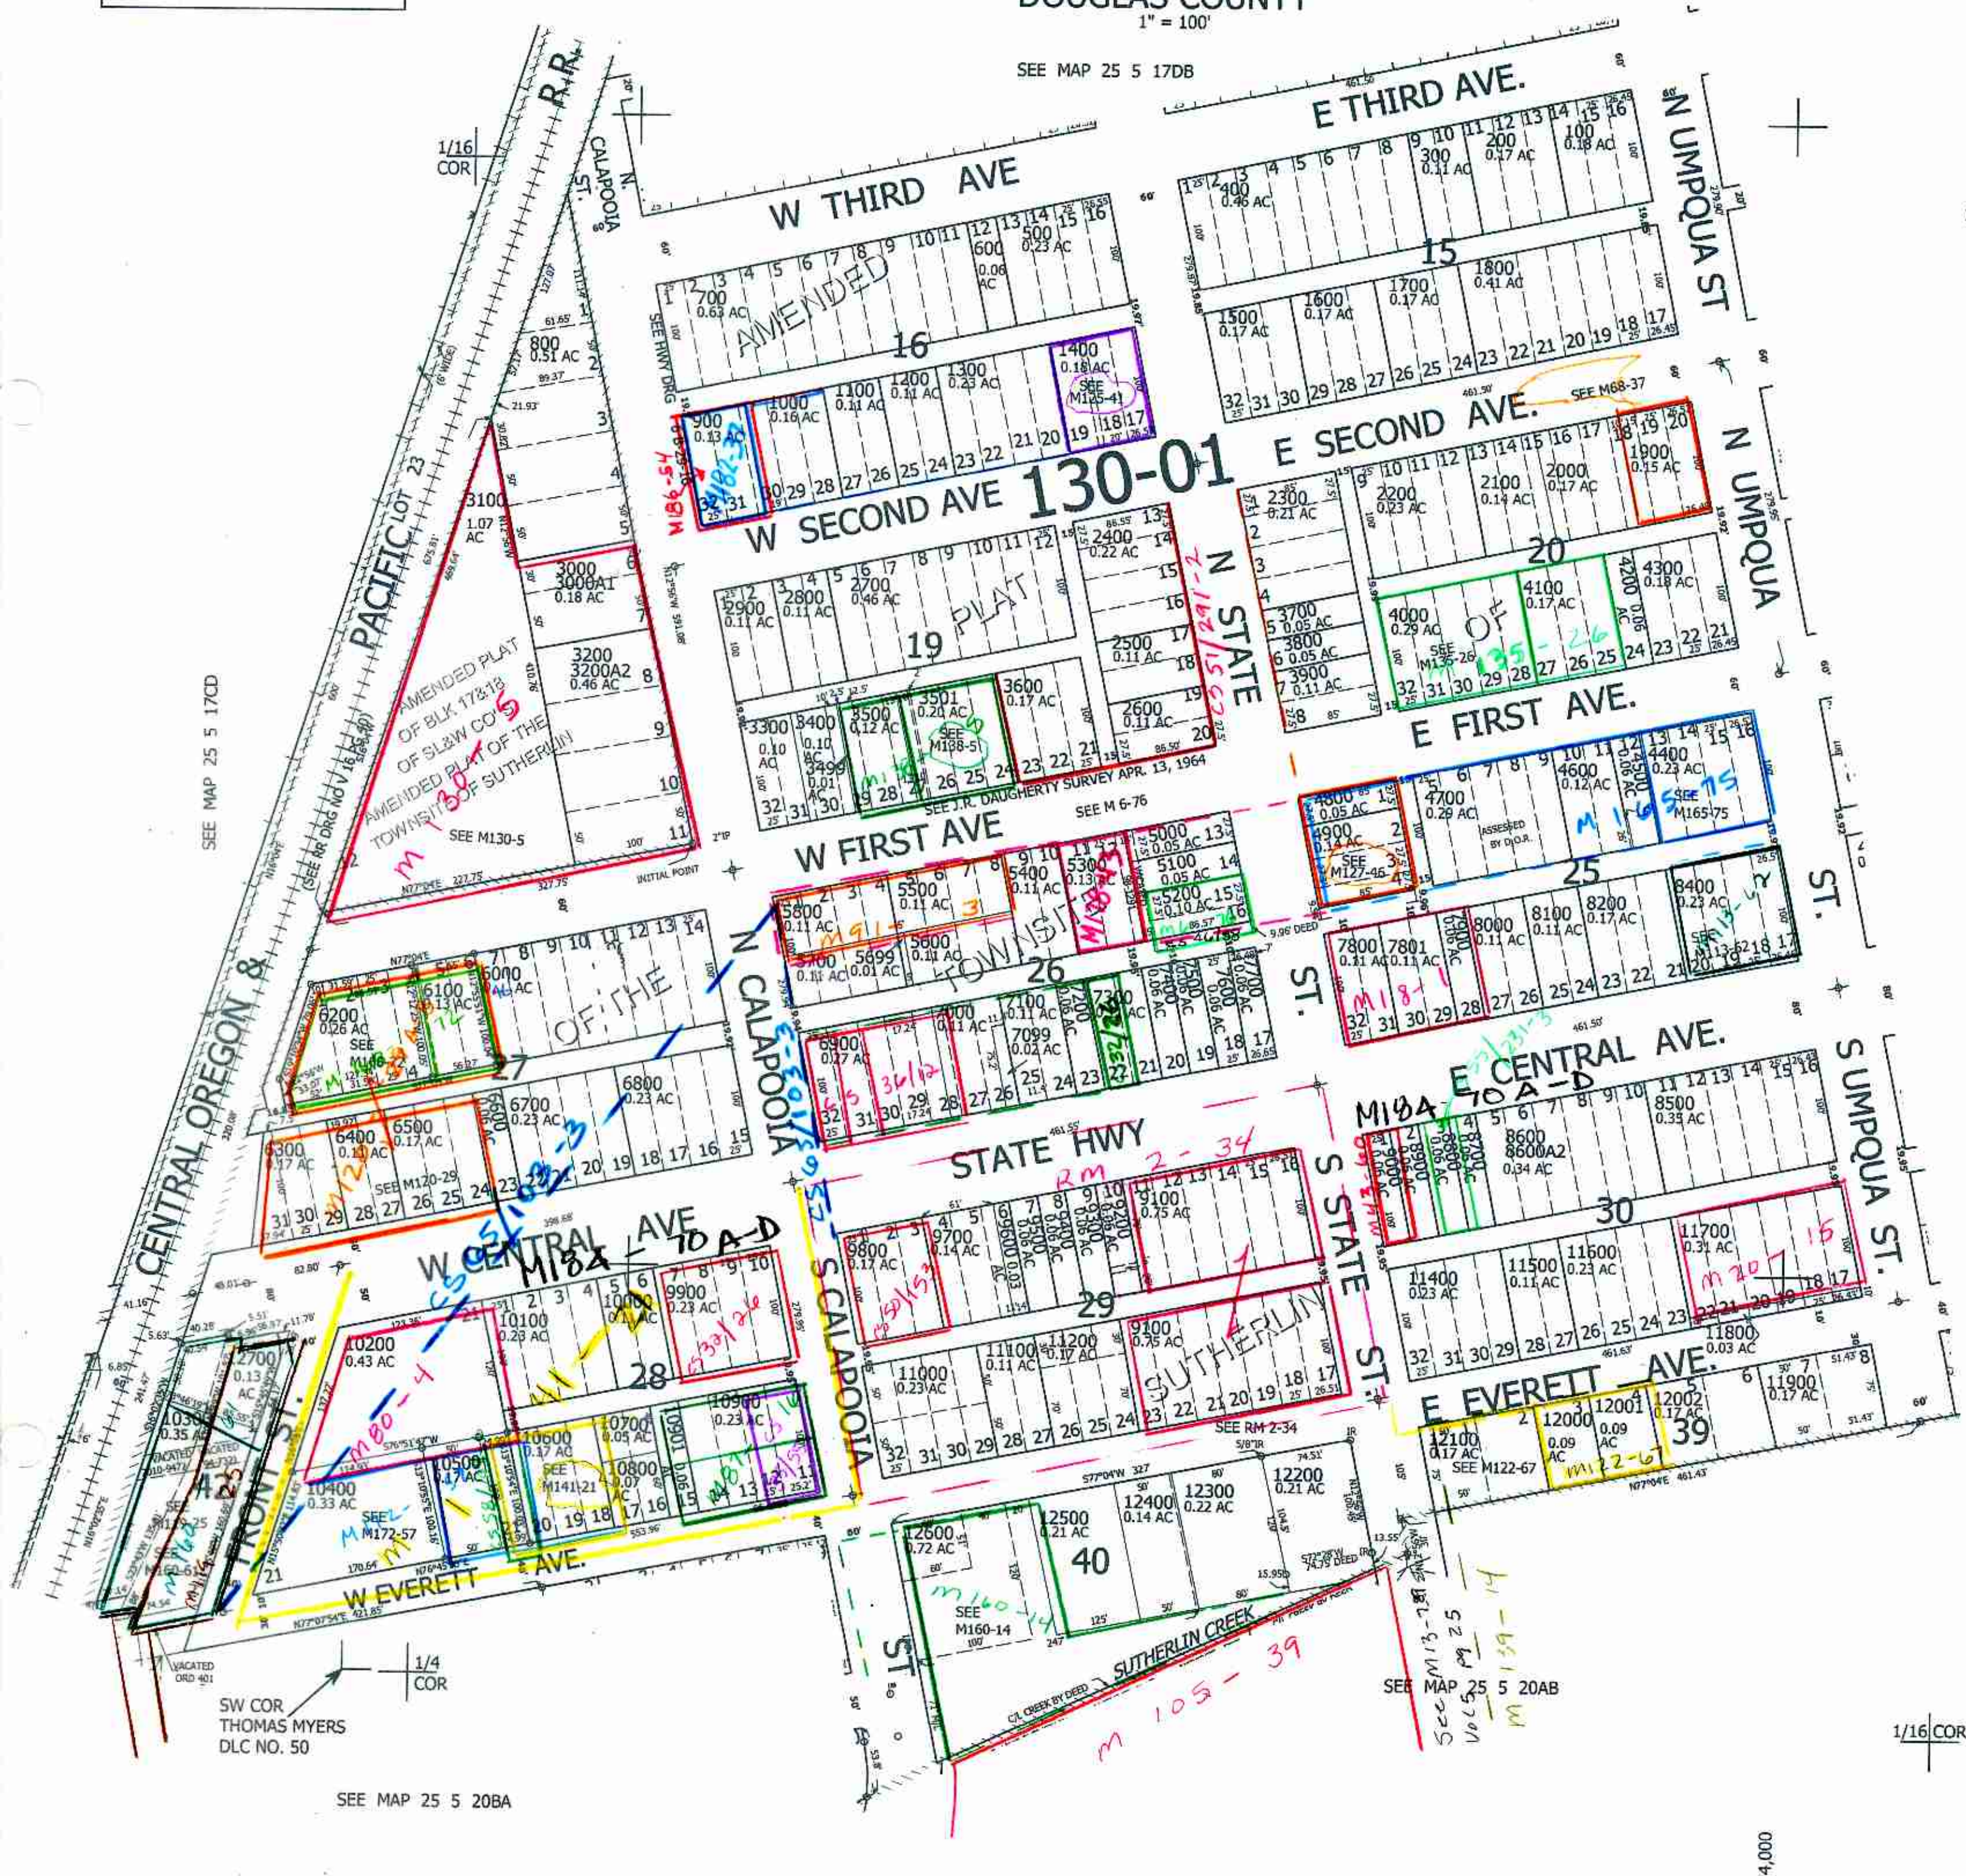

SEE MAP 25 5 17CD

SW COR
THOMAS MYERS
DLC NO. 50