

NW1/4SE1/4 SEC. 19 T.25S. R.5W. W.M.  
DOUGLAS COUNTY

25 5 19DB  
SUTHERLIN

1"=100'

REVISED ON  
12-31-92

APPROX CEN. SEC

APPROX 1/16 COR


THIS MAP WAS PREPARED FOR  
ASSESSMENT PURPOSE ONLY.

CANCELLED NO'S  
601  
1703

130-02

SEE MAP 25 5 19CA

1.246.500

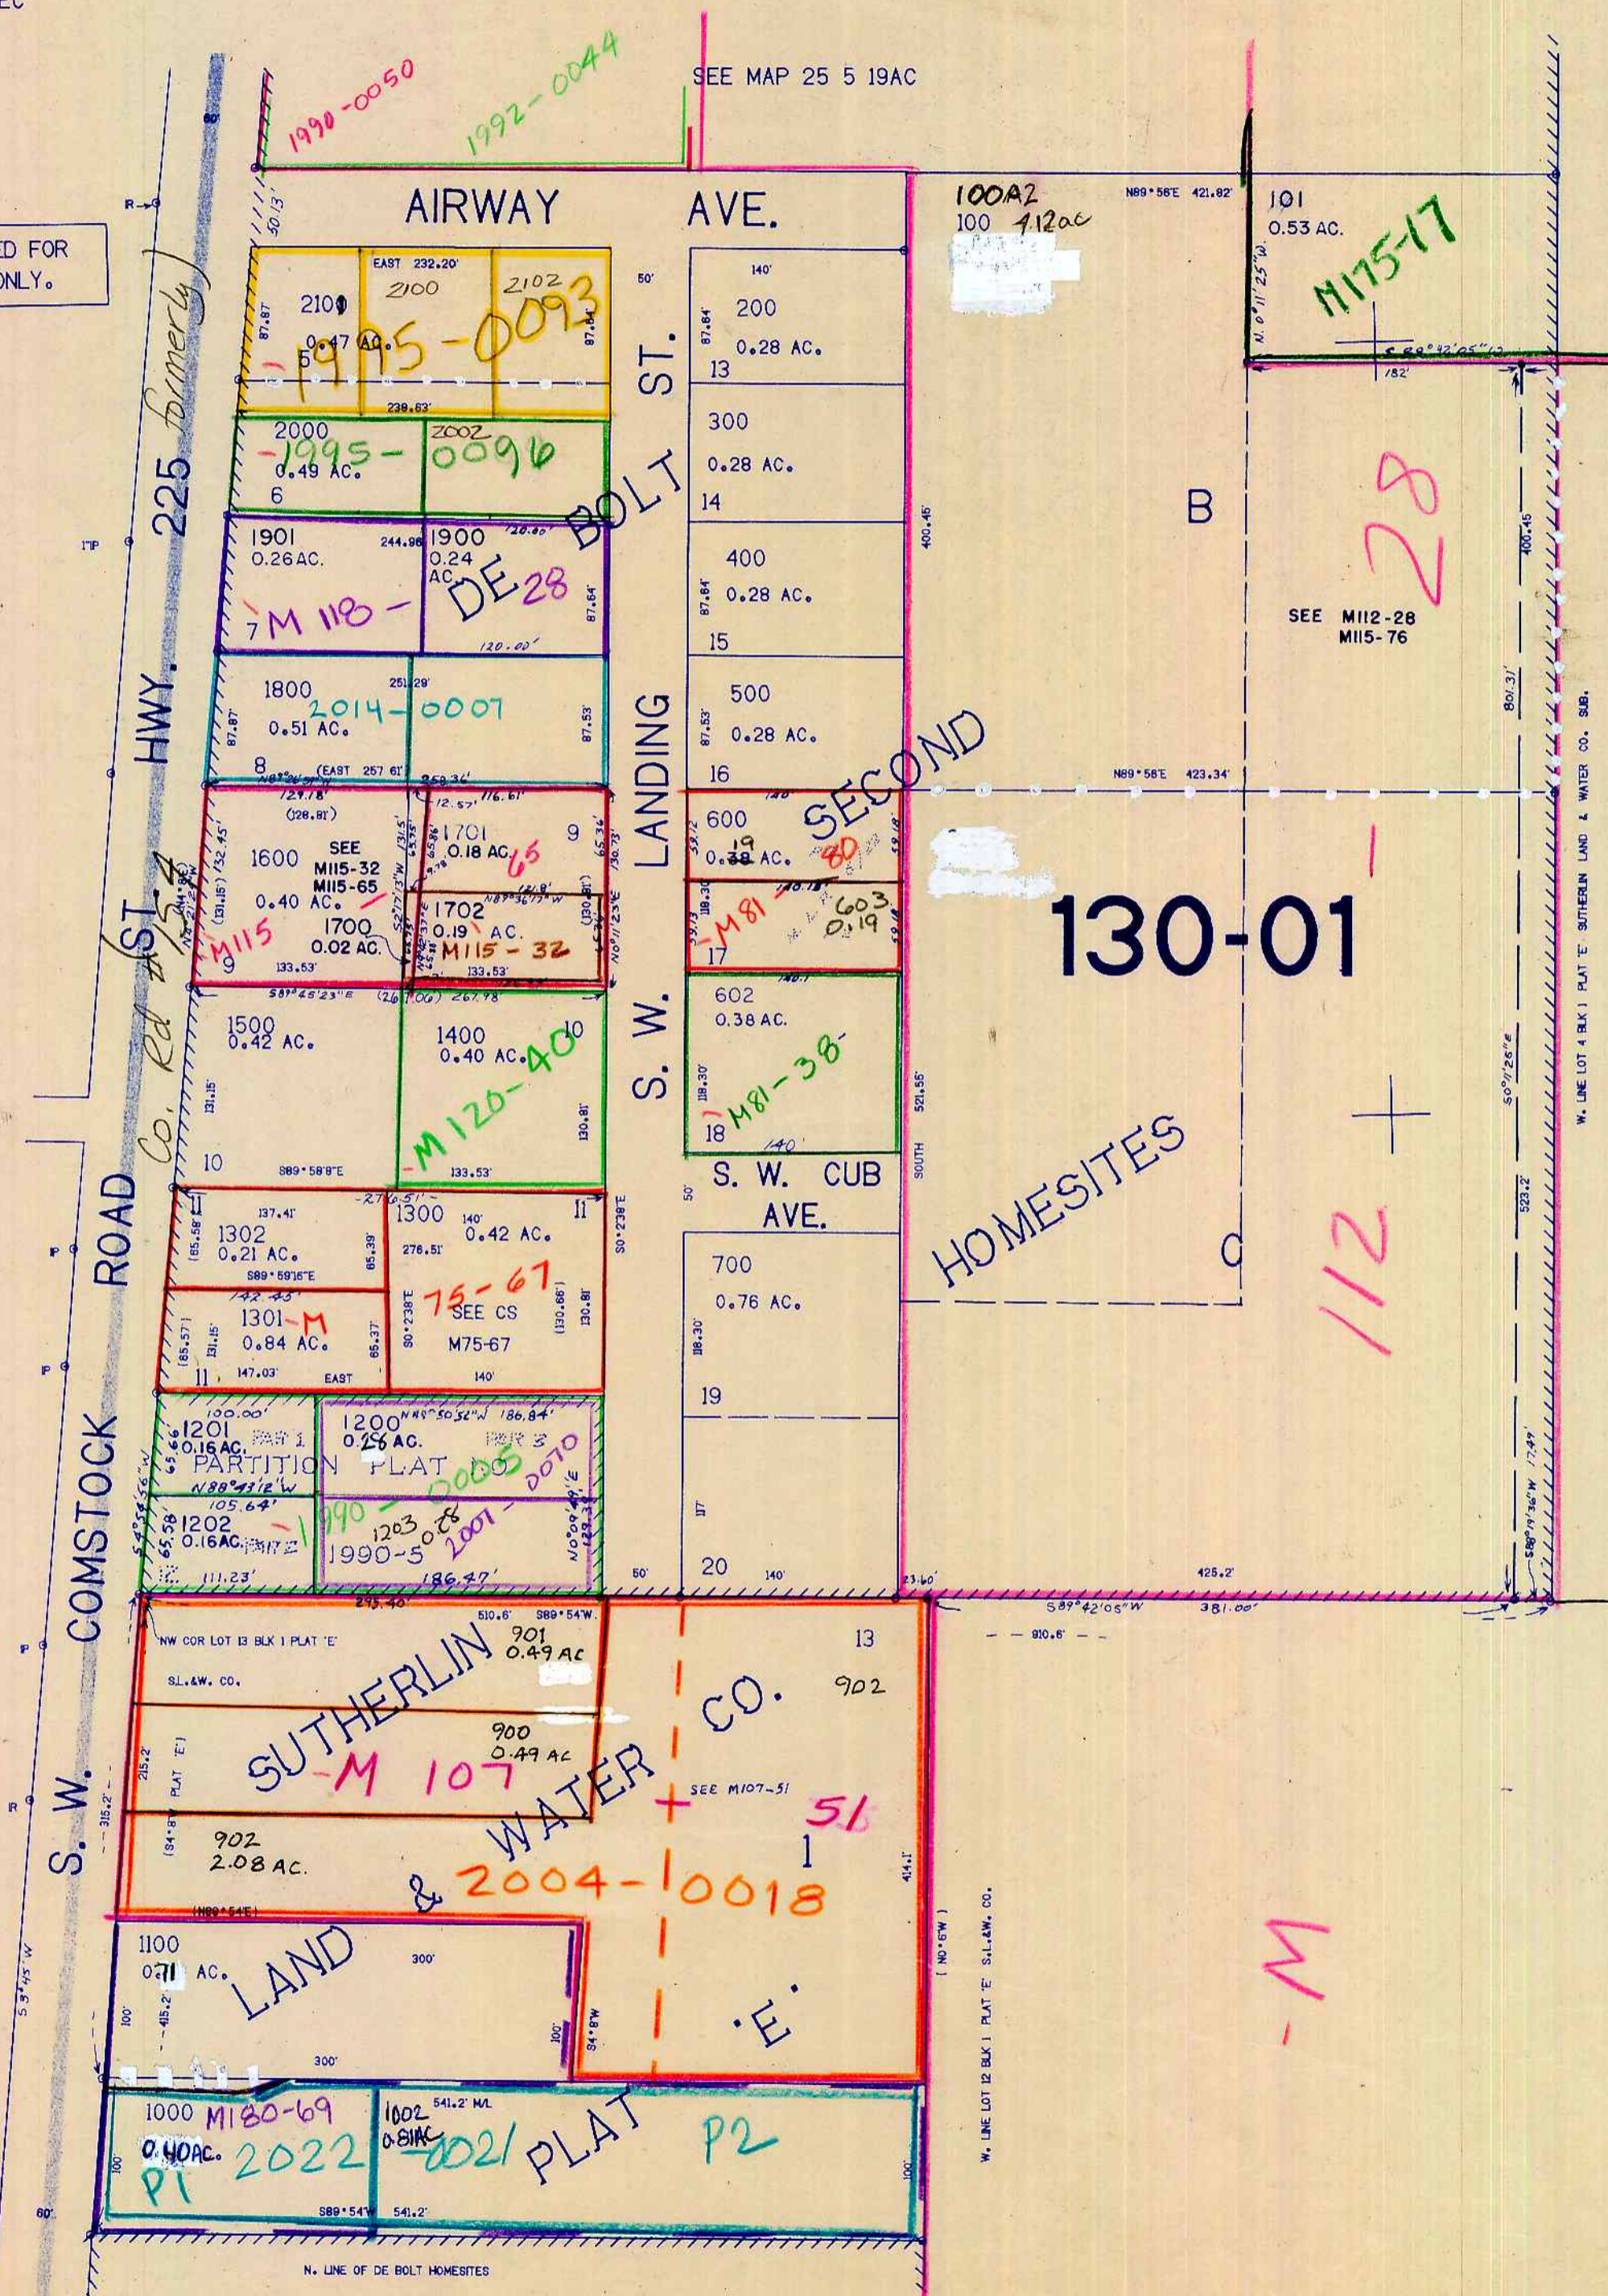

130-01

HOMESITES

SEE MAP 25 5 19D

637.000

APPROX 1/16 COR

APPROX 1/16 COR

25 5 19DB  
SUTHERLIN

1/93 ac