


SEE MAP
2505W20C

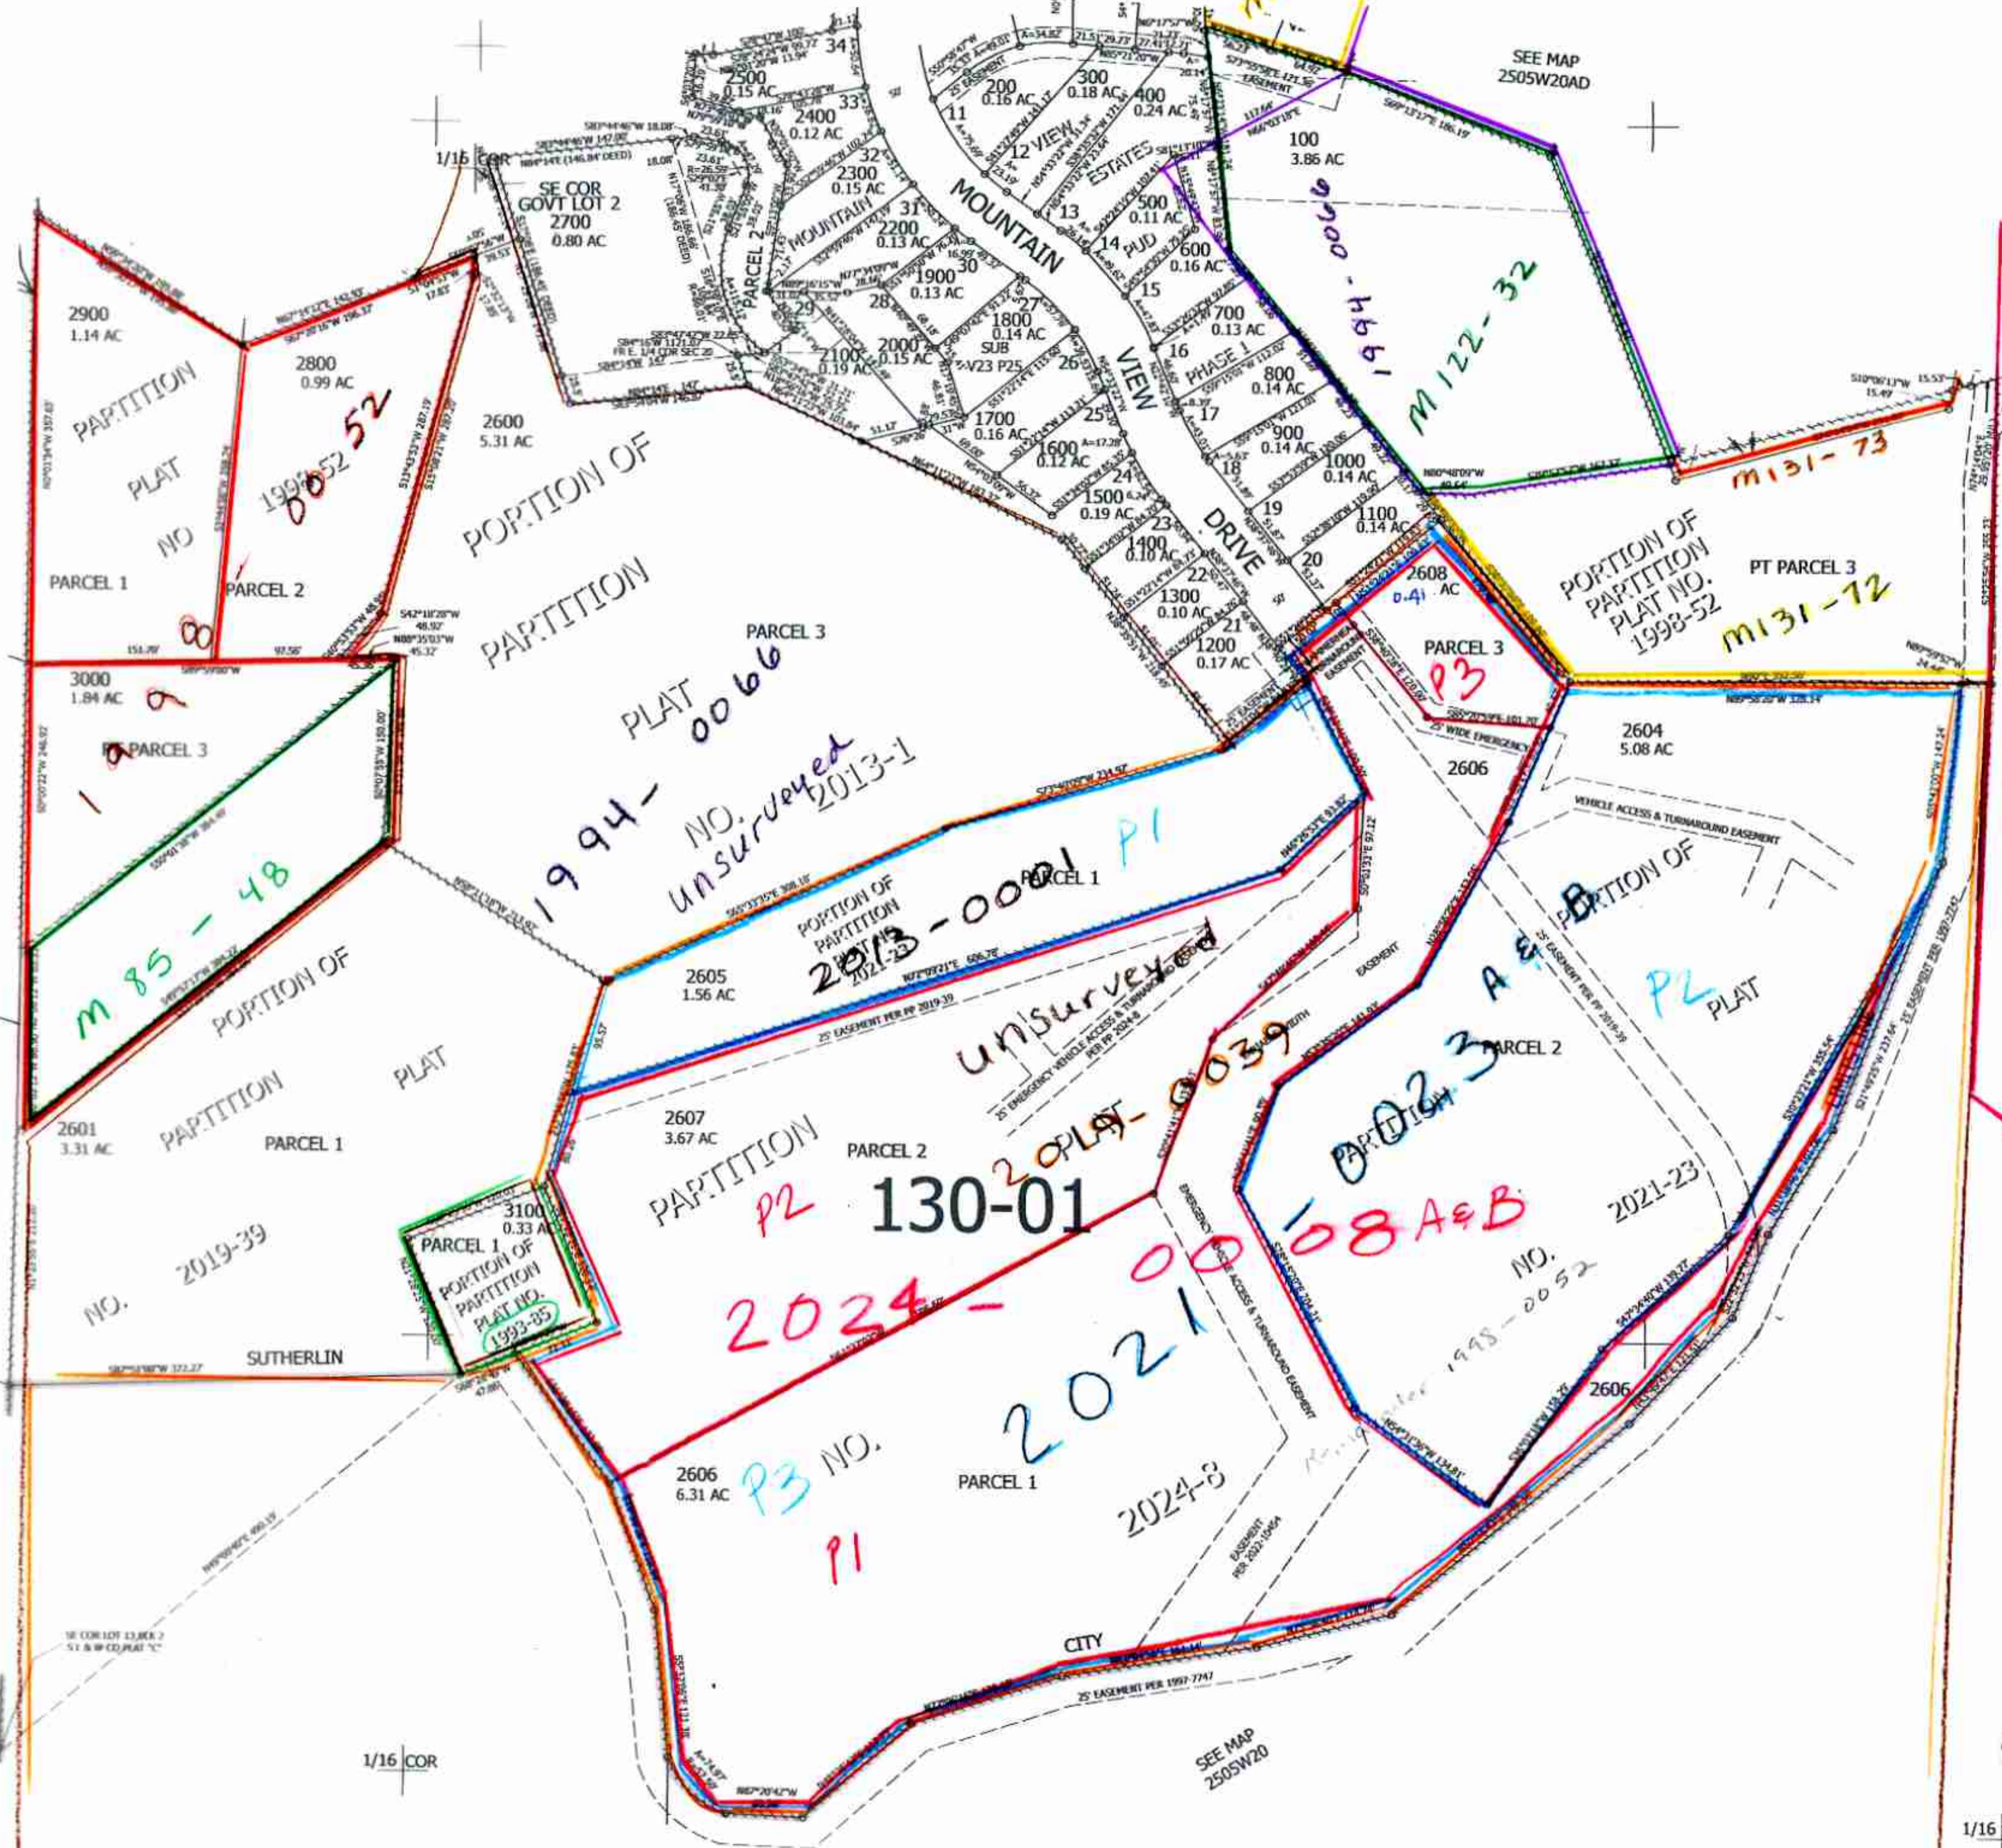

1/4 COR

RM 2-66

cm 8/20/09

1/16 COR