


THIS MAP WAS PREPARED FOR ASSESSMENT PURPOSE ONLY.

SE1/4 NW1/4 SEC.21 T.25S. R.5W. W.M.
DOUGLAS COUNTY
1" = 100'

REVISED ON
5-20-14

25 5 21BD
SUTHERLIN

SEE MAP 25 5 21BA

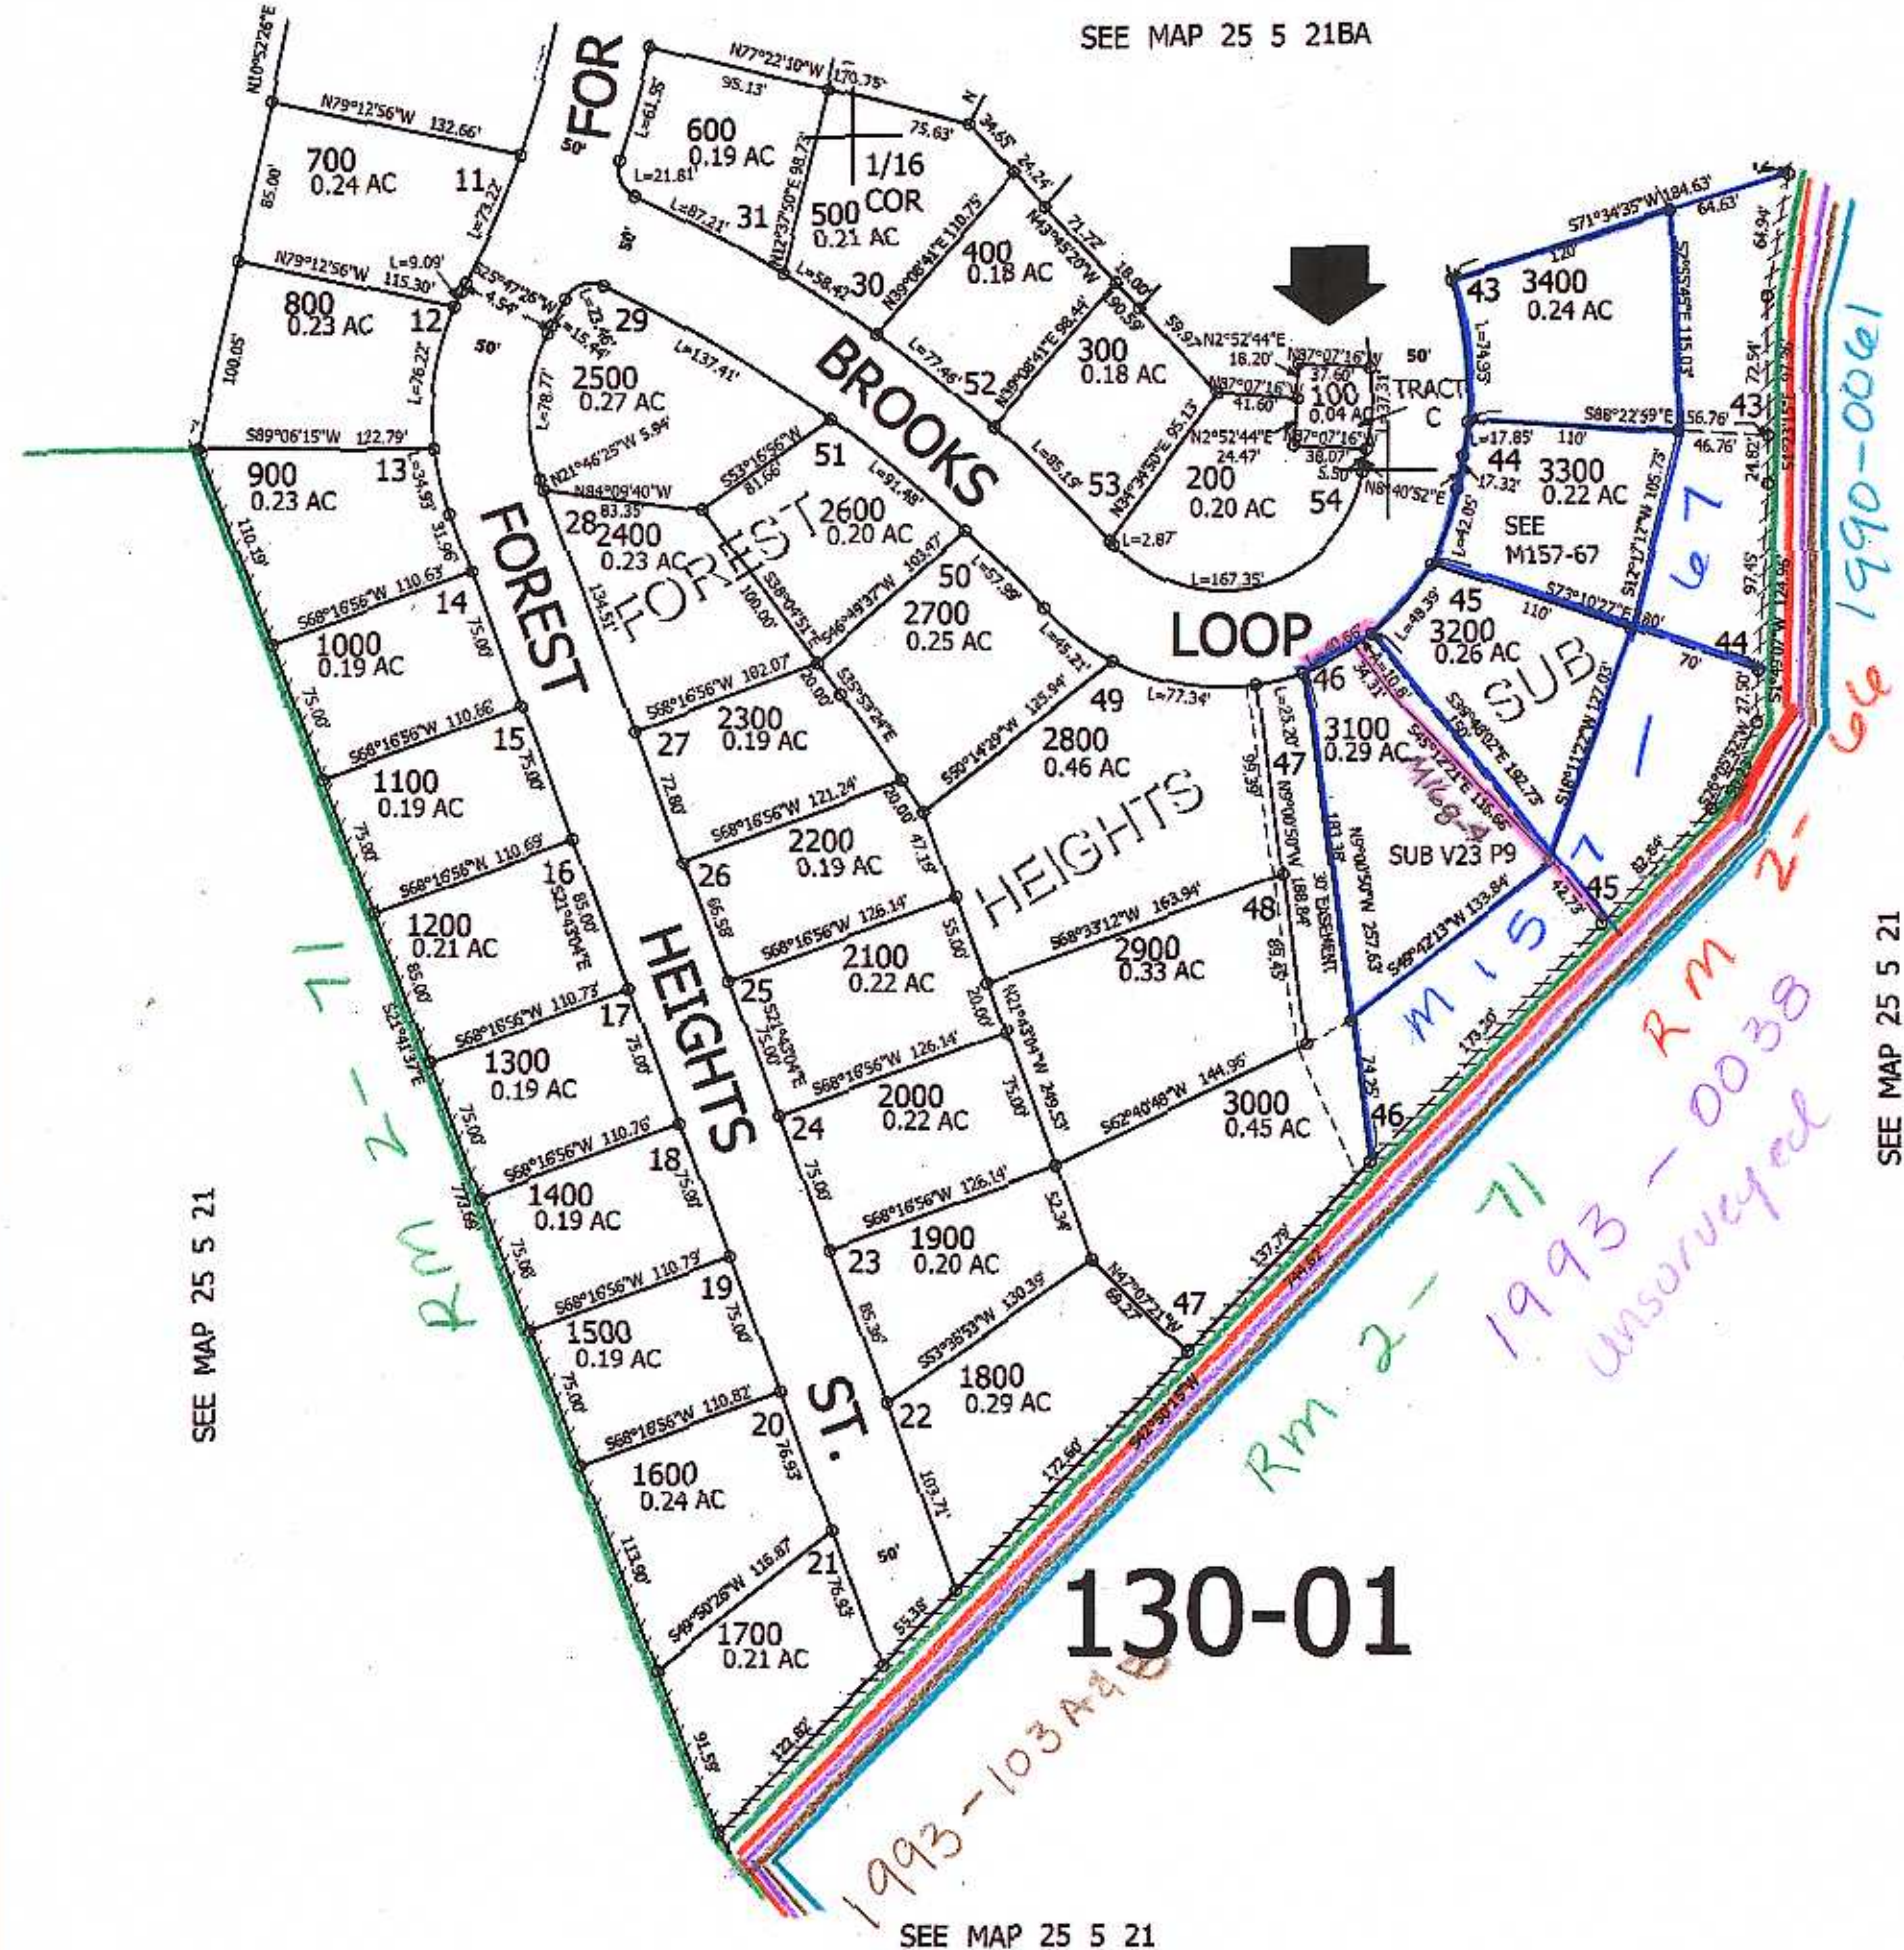

SEE MAP 25 5 21

SEE MAP 25 5 21

SEE MAP 25 5 21

1/16 COR.

CANCELLED NOS
3101 3201 3301
3401 3102

+

+

637,500

1/16 COR.

CEN. SEC.

scr

25 5 21BD
SUTHERLIN

4,177,000