


SECTION 25 T.25S. R.5W. W.M.
DOUGLAS COUNTY

25 5 25

THIS MAP WAS PREPARED FOR
ASSESSMENT PURPOSE ONLY.

1"=400'

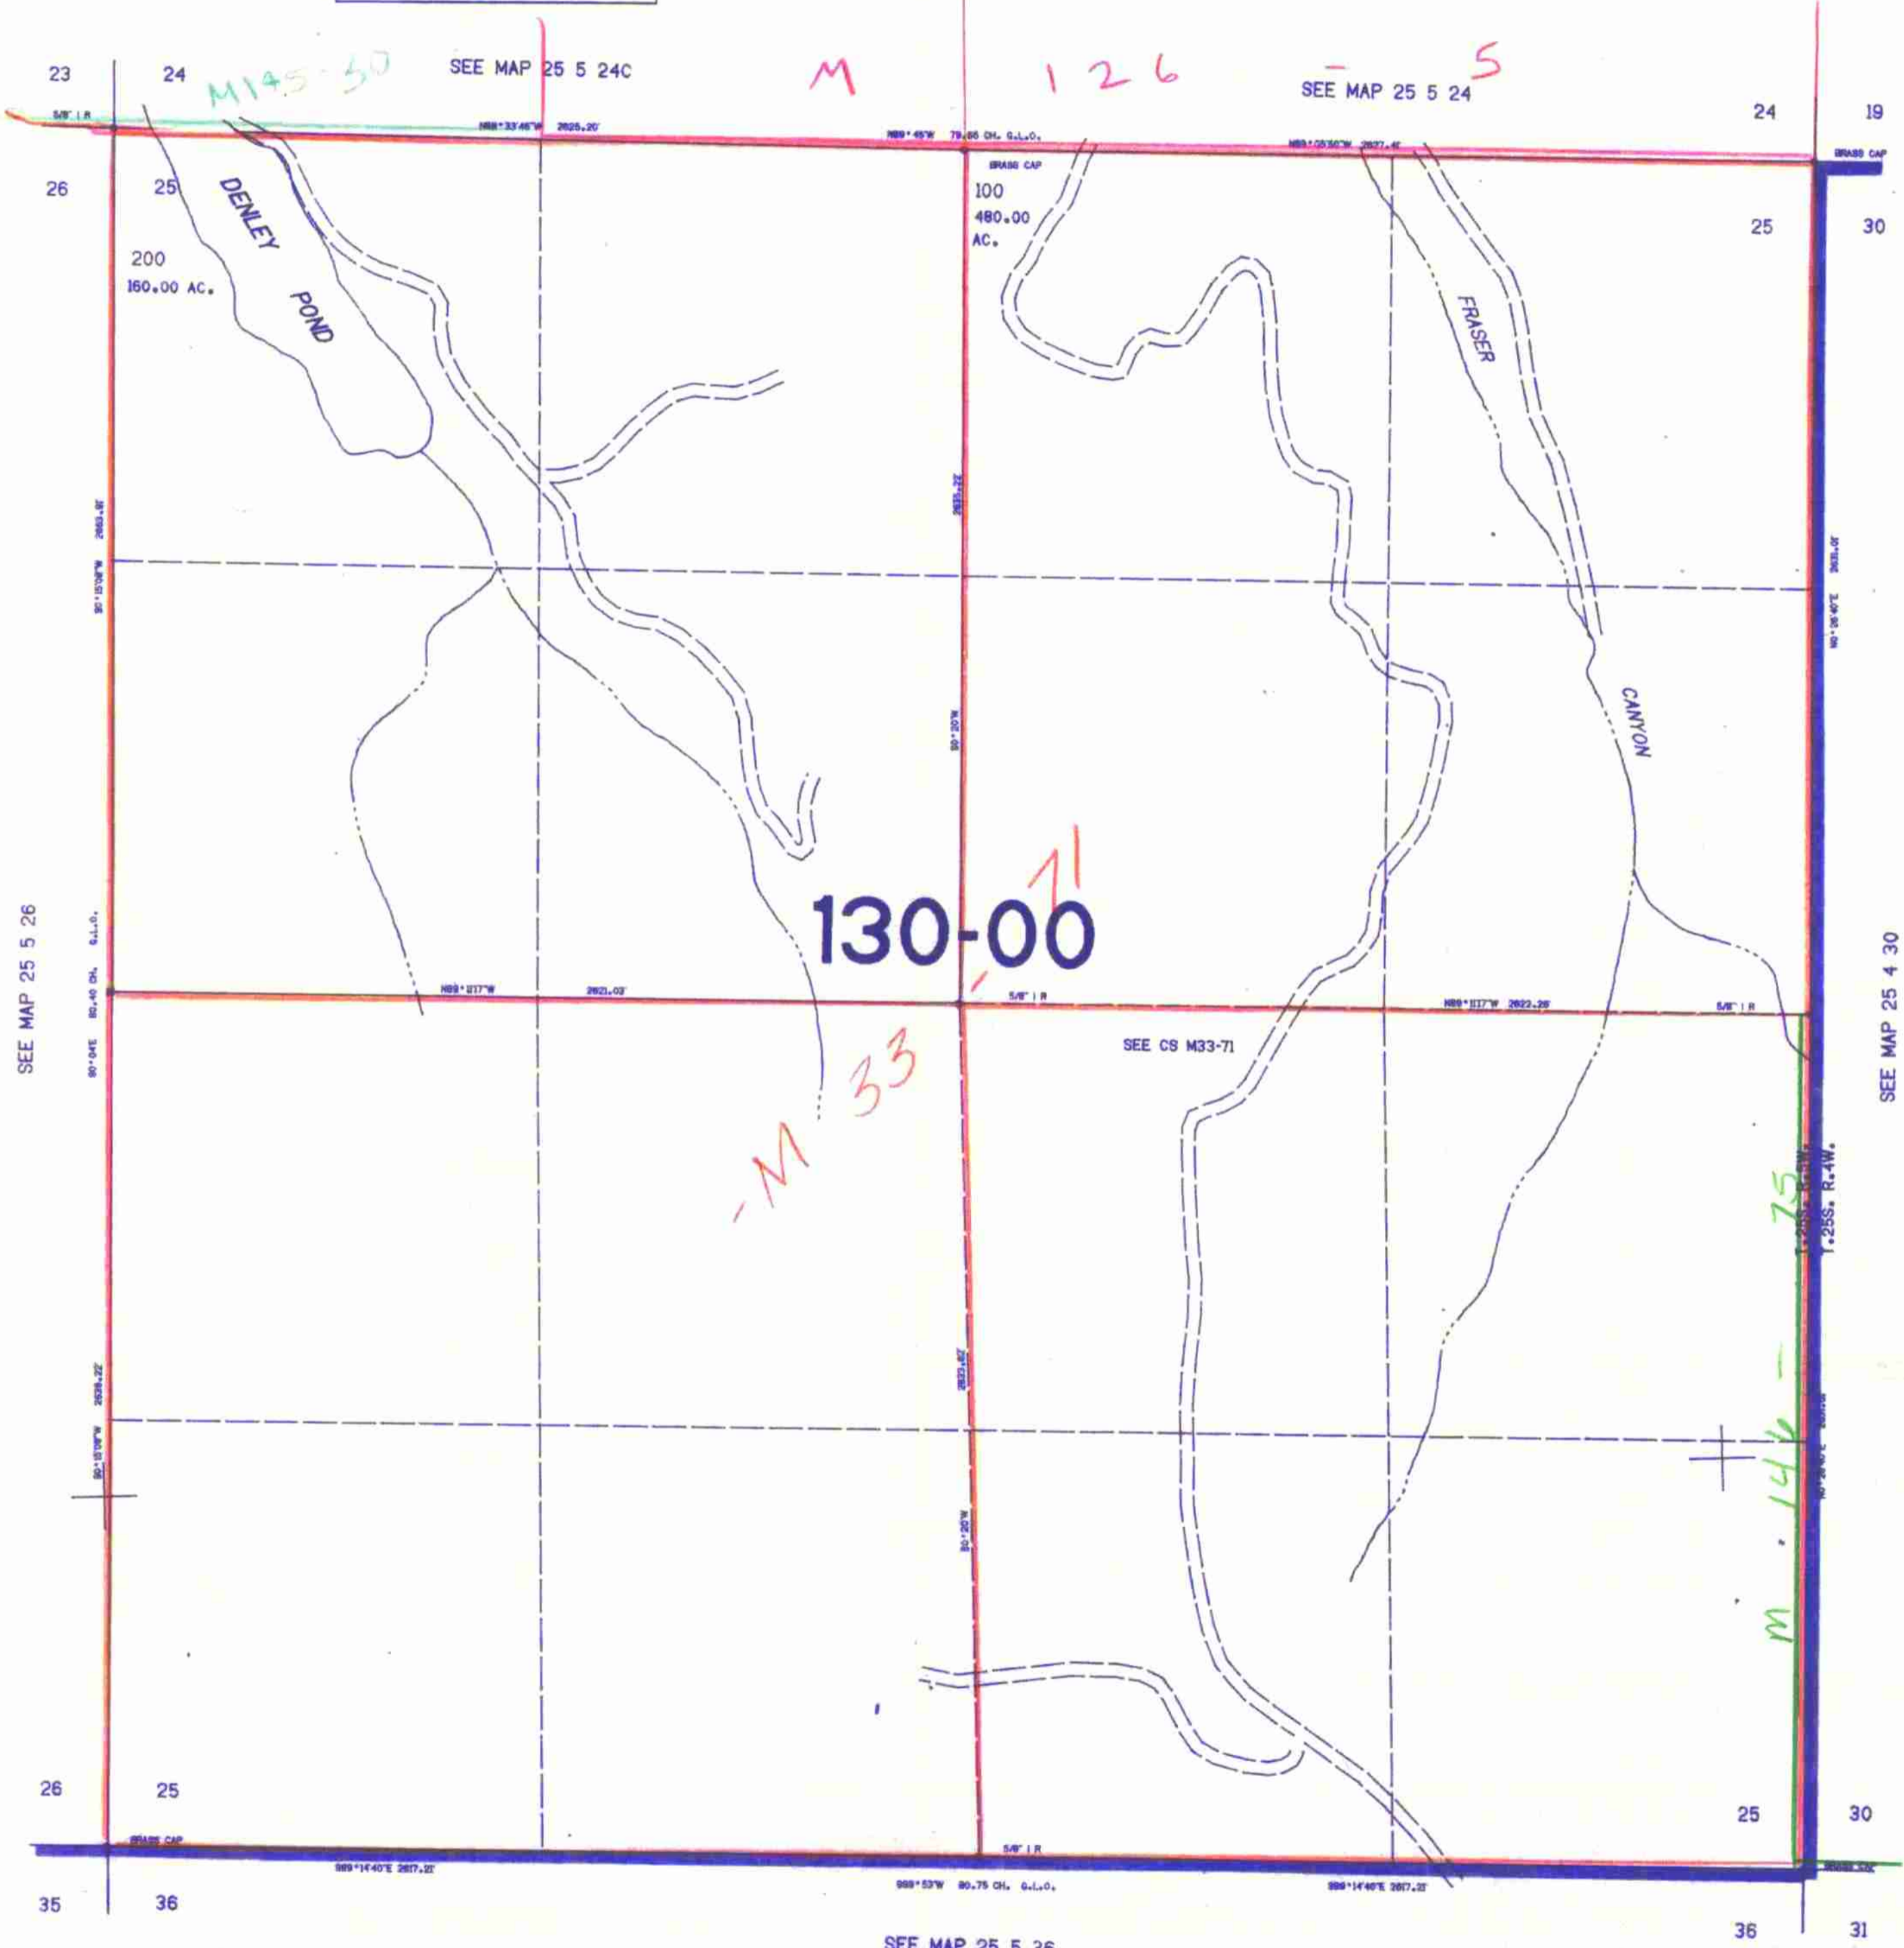

SEE MAP 25 5 26

SEE MAP 25 5 24C

SEE MAP 25 5 24

SEE MAP 25 4 30

SEE MAP 25 5 36

630.000

25 5 25

1275.000

9/80 J.P.