THIS MAP WAS PREPARED FOR ASSESSMENT PURPOSE ONLY

Upper Left
123°19'58"W 43°22'34"N
4168275E 635781N ft

SEC.29 T.25S. R.05W. W.M.
DOUGLAS COUNTY
1" =400'

Date Exported 2023-08-08

250529
& INDEX
Sutherlin

CANCELLED NOS:
100 101 901
1101 902 700
702 801 802

PARCEL 402
S52°42'W 131.56'
S36°24'W 110.6'
S0°48'W 116.8'

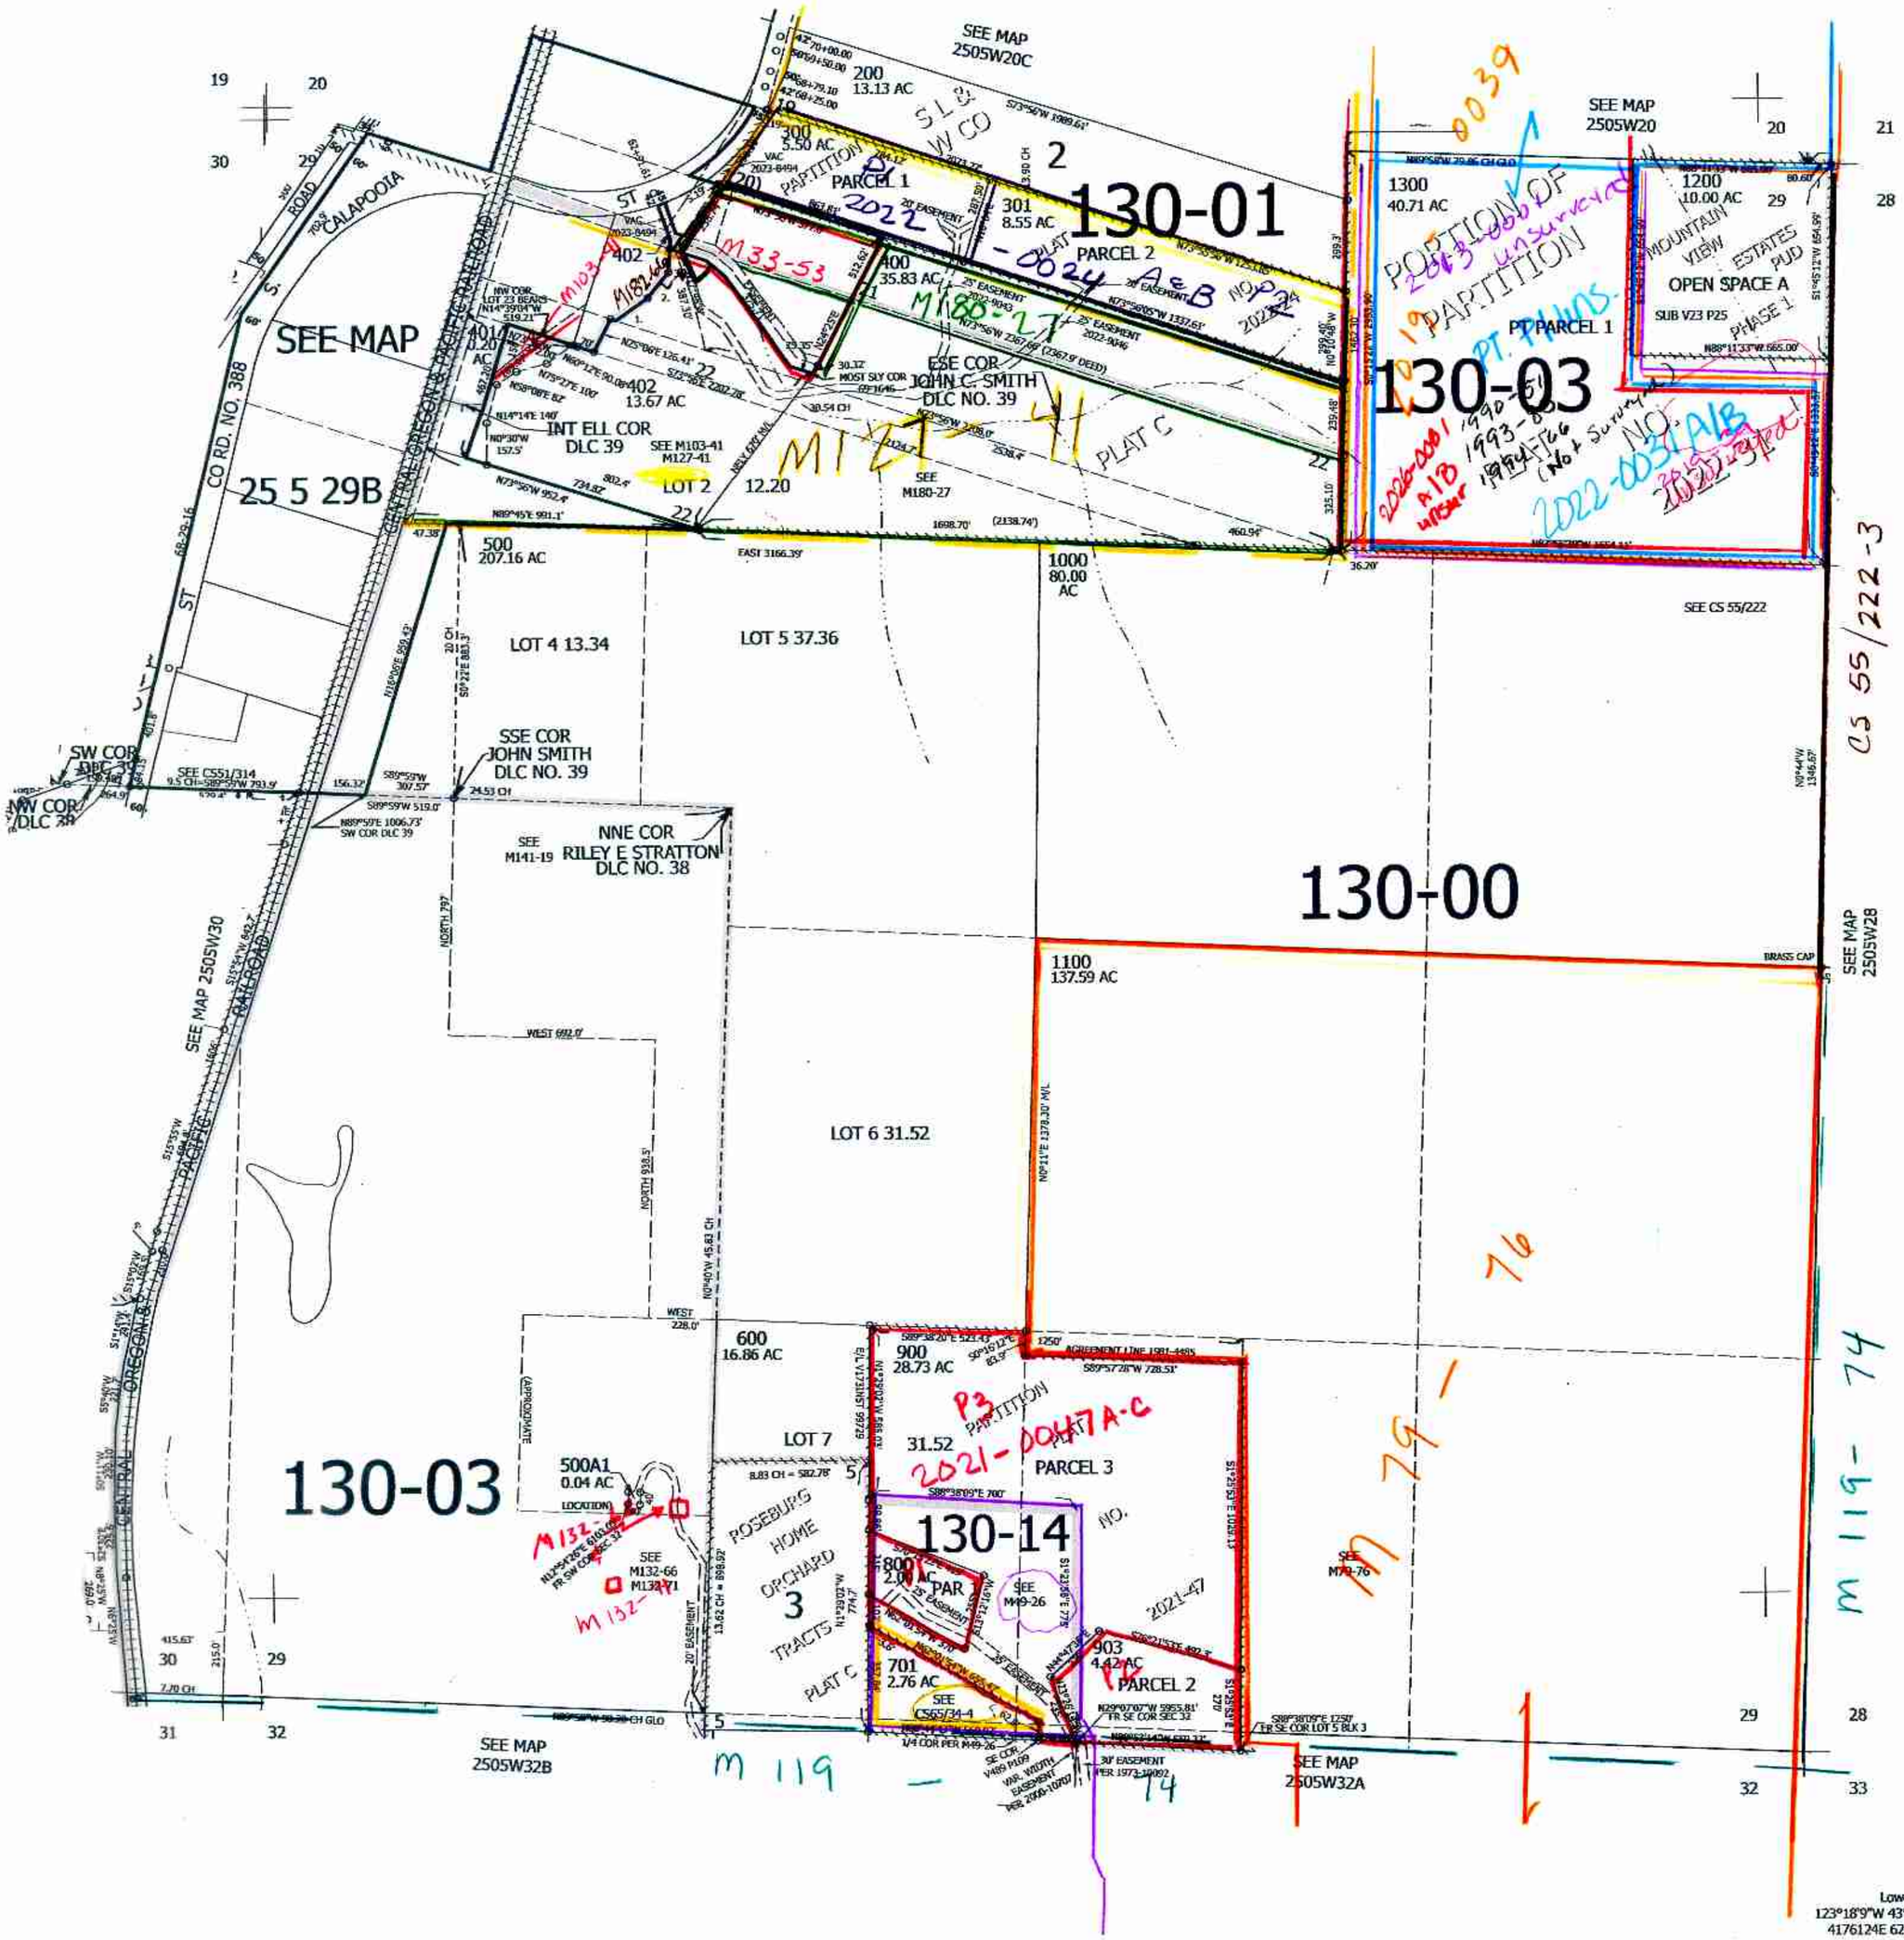

Lower Right:
123°18'9"W 43°21'28"N
4176124E 628826N ft

250529
& INDEX
Sutherlin