


THIS MAP WAS PREPARED FOR ASSESSMENT PURPOSE ONLY.

SEC.31 T.25S. R.5W. W.M.
DOUGLAS COUNTY
1" = 400'

REVISED ON
11-19-20

25 5 31

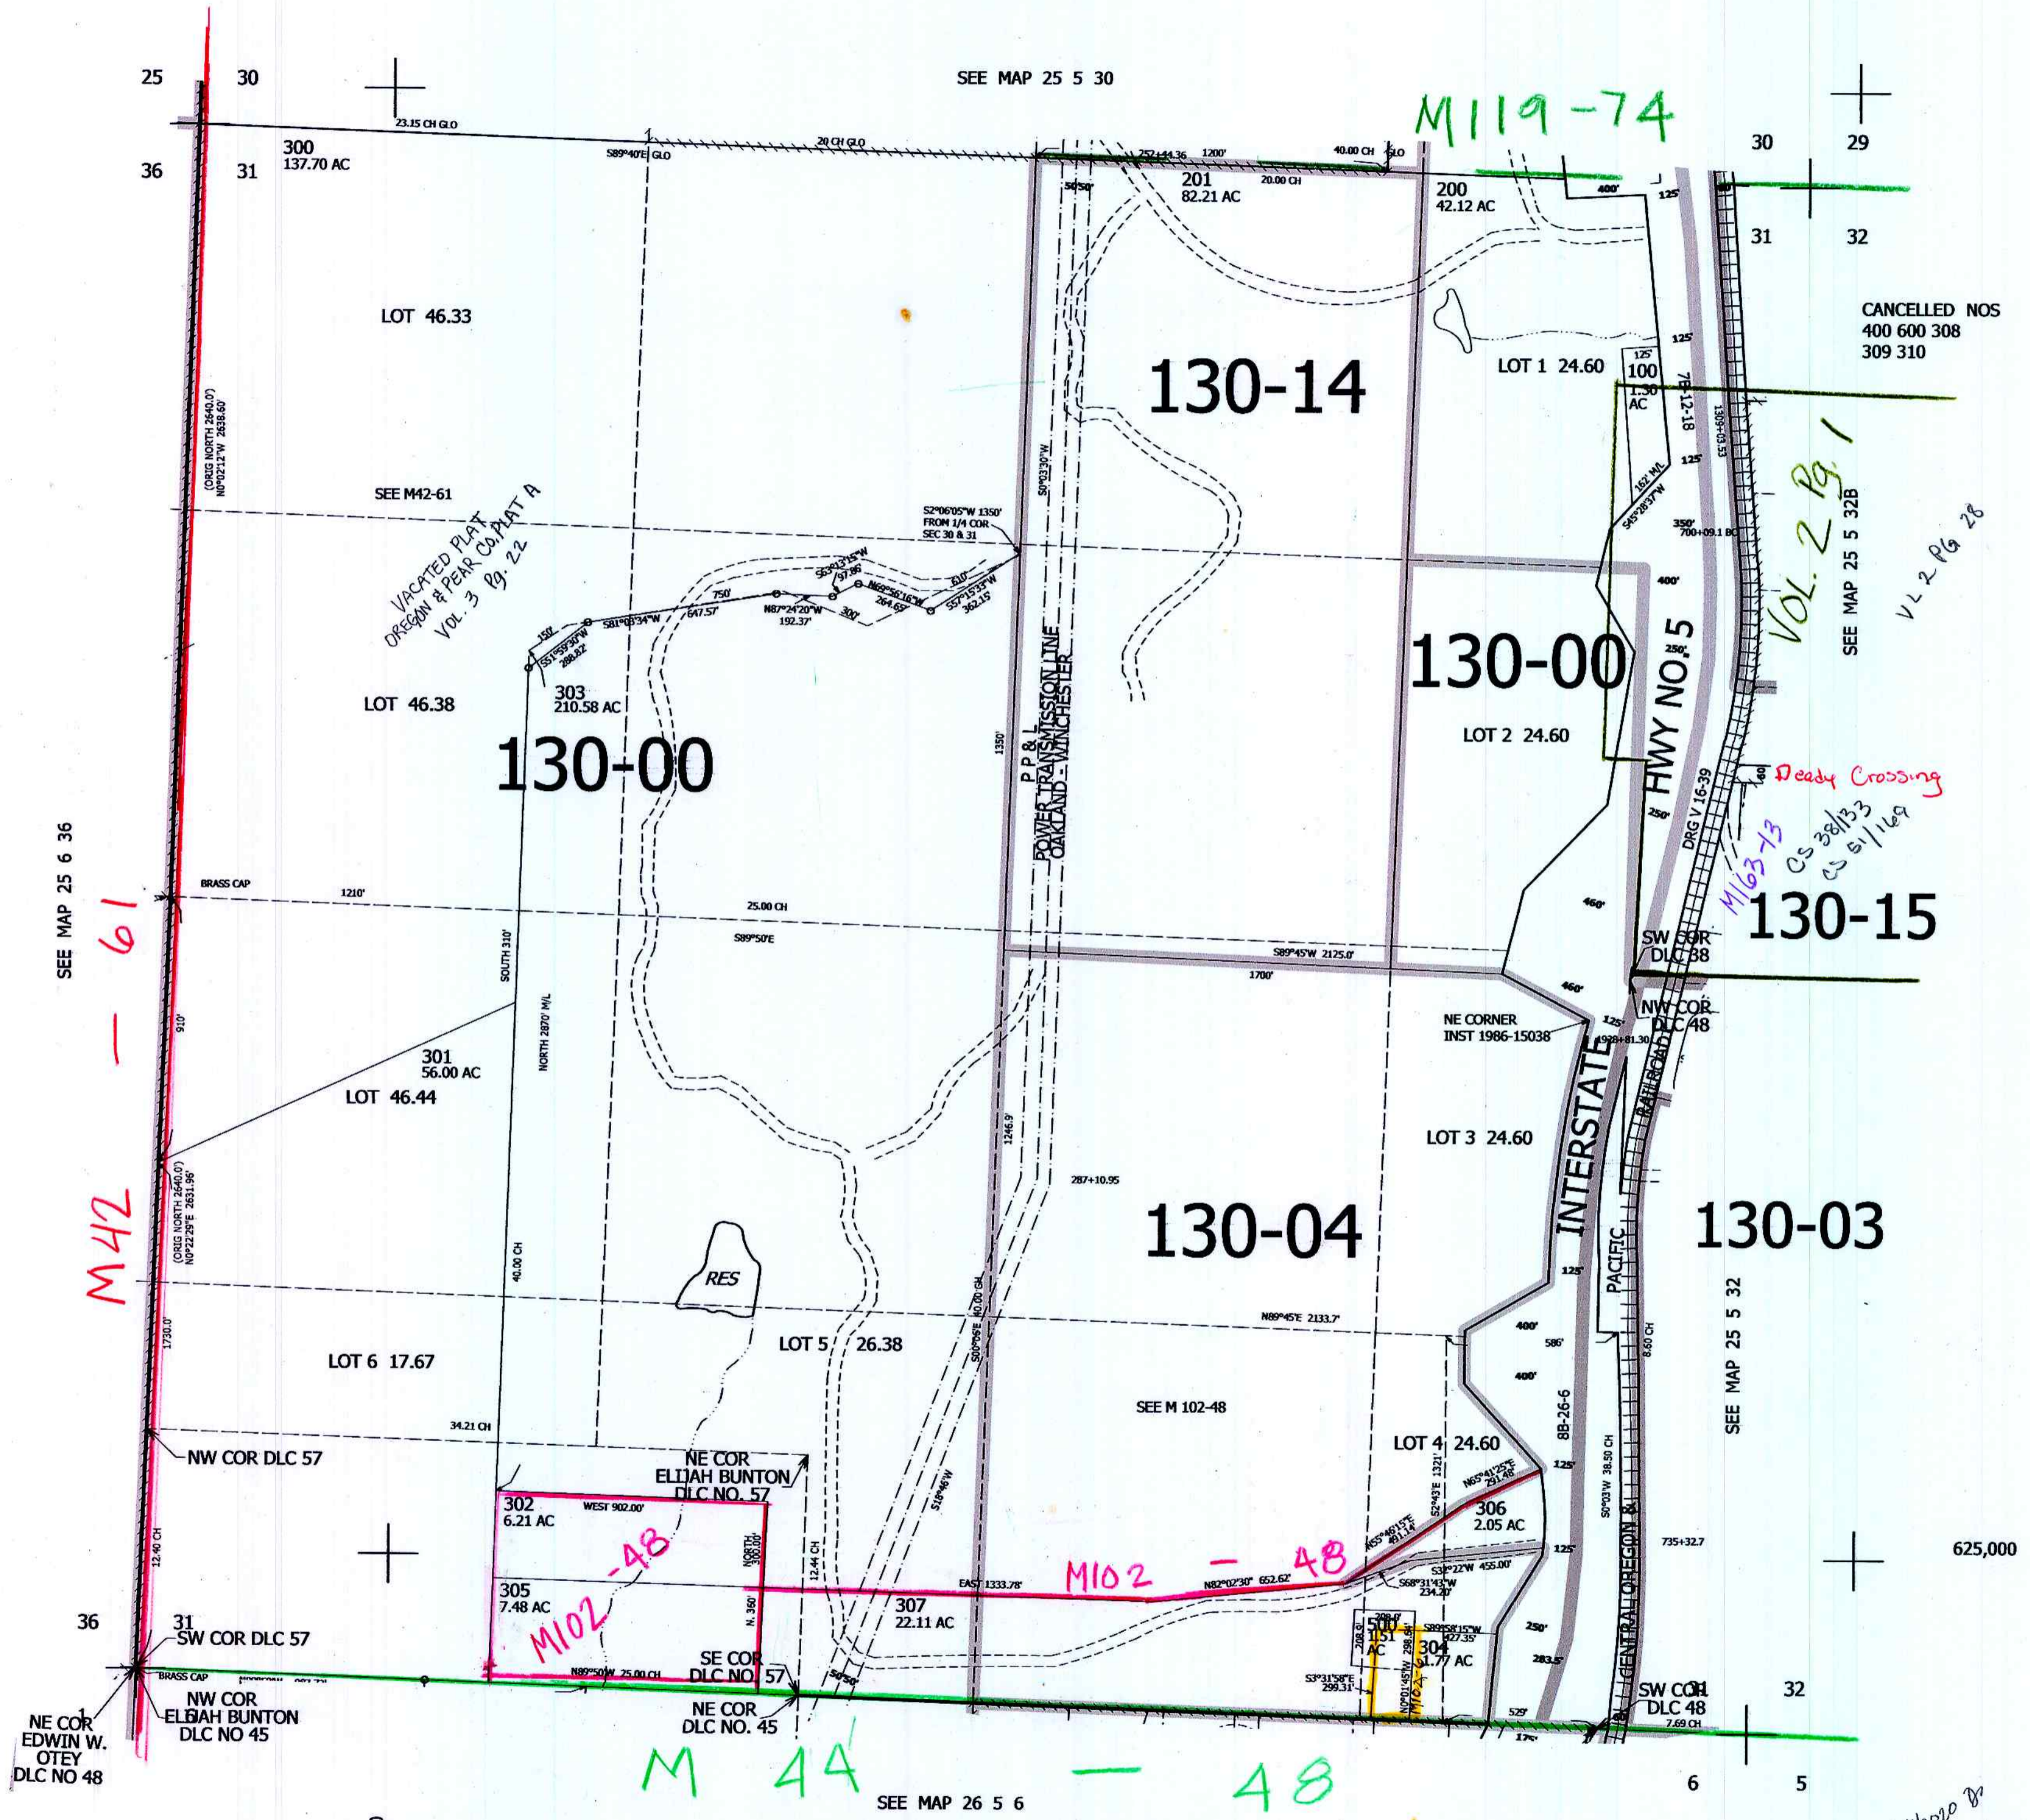

SEE MAP 25 6 36

SEE MAP 25 5 30

SEE MAP 25 5 32

SEE MAP 26 5 6

M42-61

M119-74

130-00

130-14

130-00

130-15

130-04

130-03

M102-48

M102-48

M44-48

M44-48

VOL. 2 Pg. 1
SEE MAP 25 5 32B

Ready Crossing
M163-73
CS 38/133
CS 51/169

NE COR EDWIN W. OTEY DLC NO 48

NW COR ELBAH BUNTON DLC NO 45

NE COR DLC NO. 45

NE COR ELIJAH BUNTON DLC NO. 57

NW COR DLC 57

LOT 4 24.60

306 2.05 AC

307 22.11 AC

305 7.48 AC

302 6.21 AC

LOT 6 17.67

301 56.00 AC
LOT 46.44

303 210.58 AC
LOT 46.38

300 137.70 AC
LOT 46.33

LOT 46.33

SEE M42-61
VACATED PLAT
OREGON & PEARL CO. PART A
Vol. 3 Pg. 22

POWER TRANSMISSION LINE
OAKLAND - WINCHESTER

INTERSTATE

HWY NO. 5

CANCELLED NOS
400 600 308
309 310

25 5 31

4,165,000

625,000

11/20/20 Dr
JCL