THIS MAP WAS PREPARED FOR ASSESSMENT PURPOSE ONLY

SEC. 36 T.25S. R. 5W W.M.
DOUGLAS COUNTY

1" = 400 '

REVISED ON

25 5 36

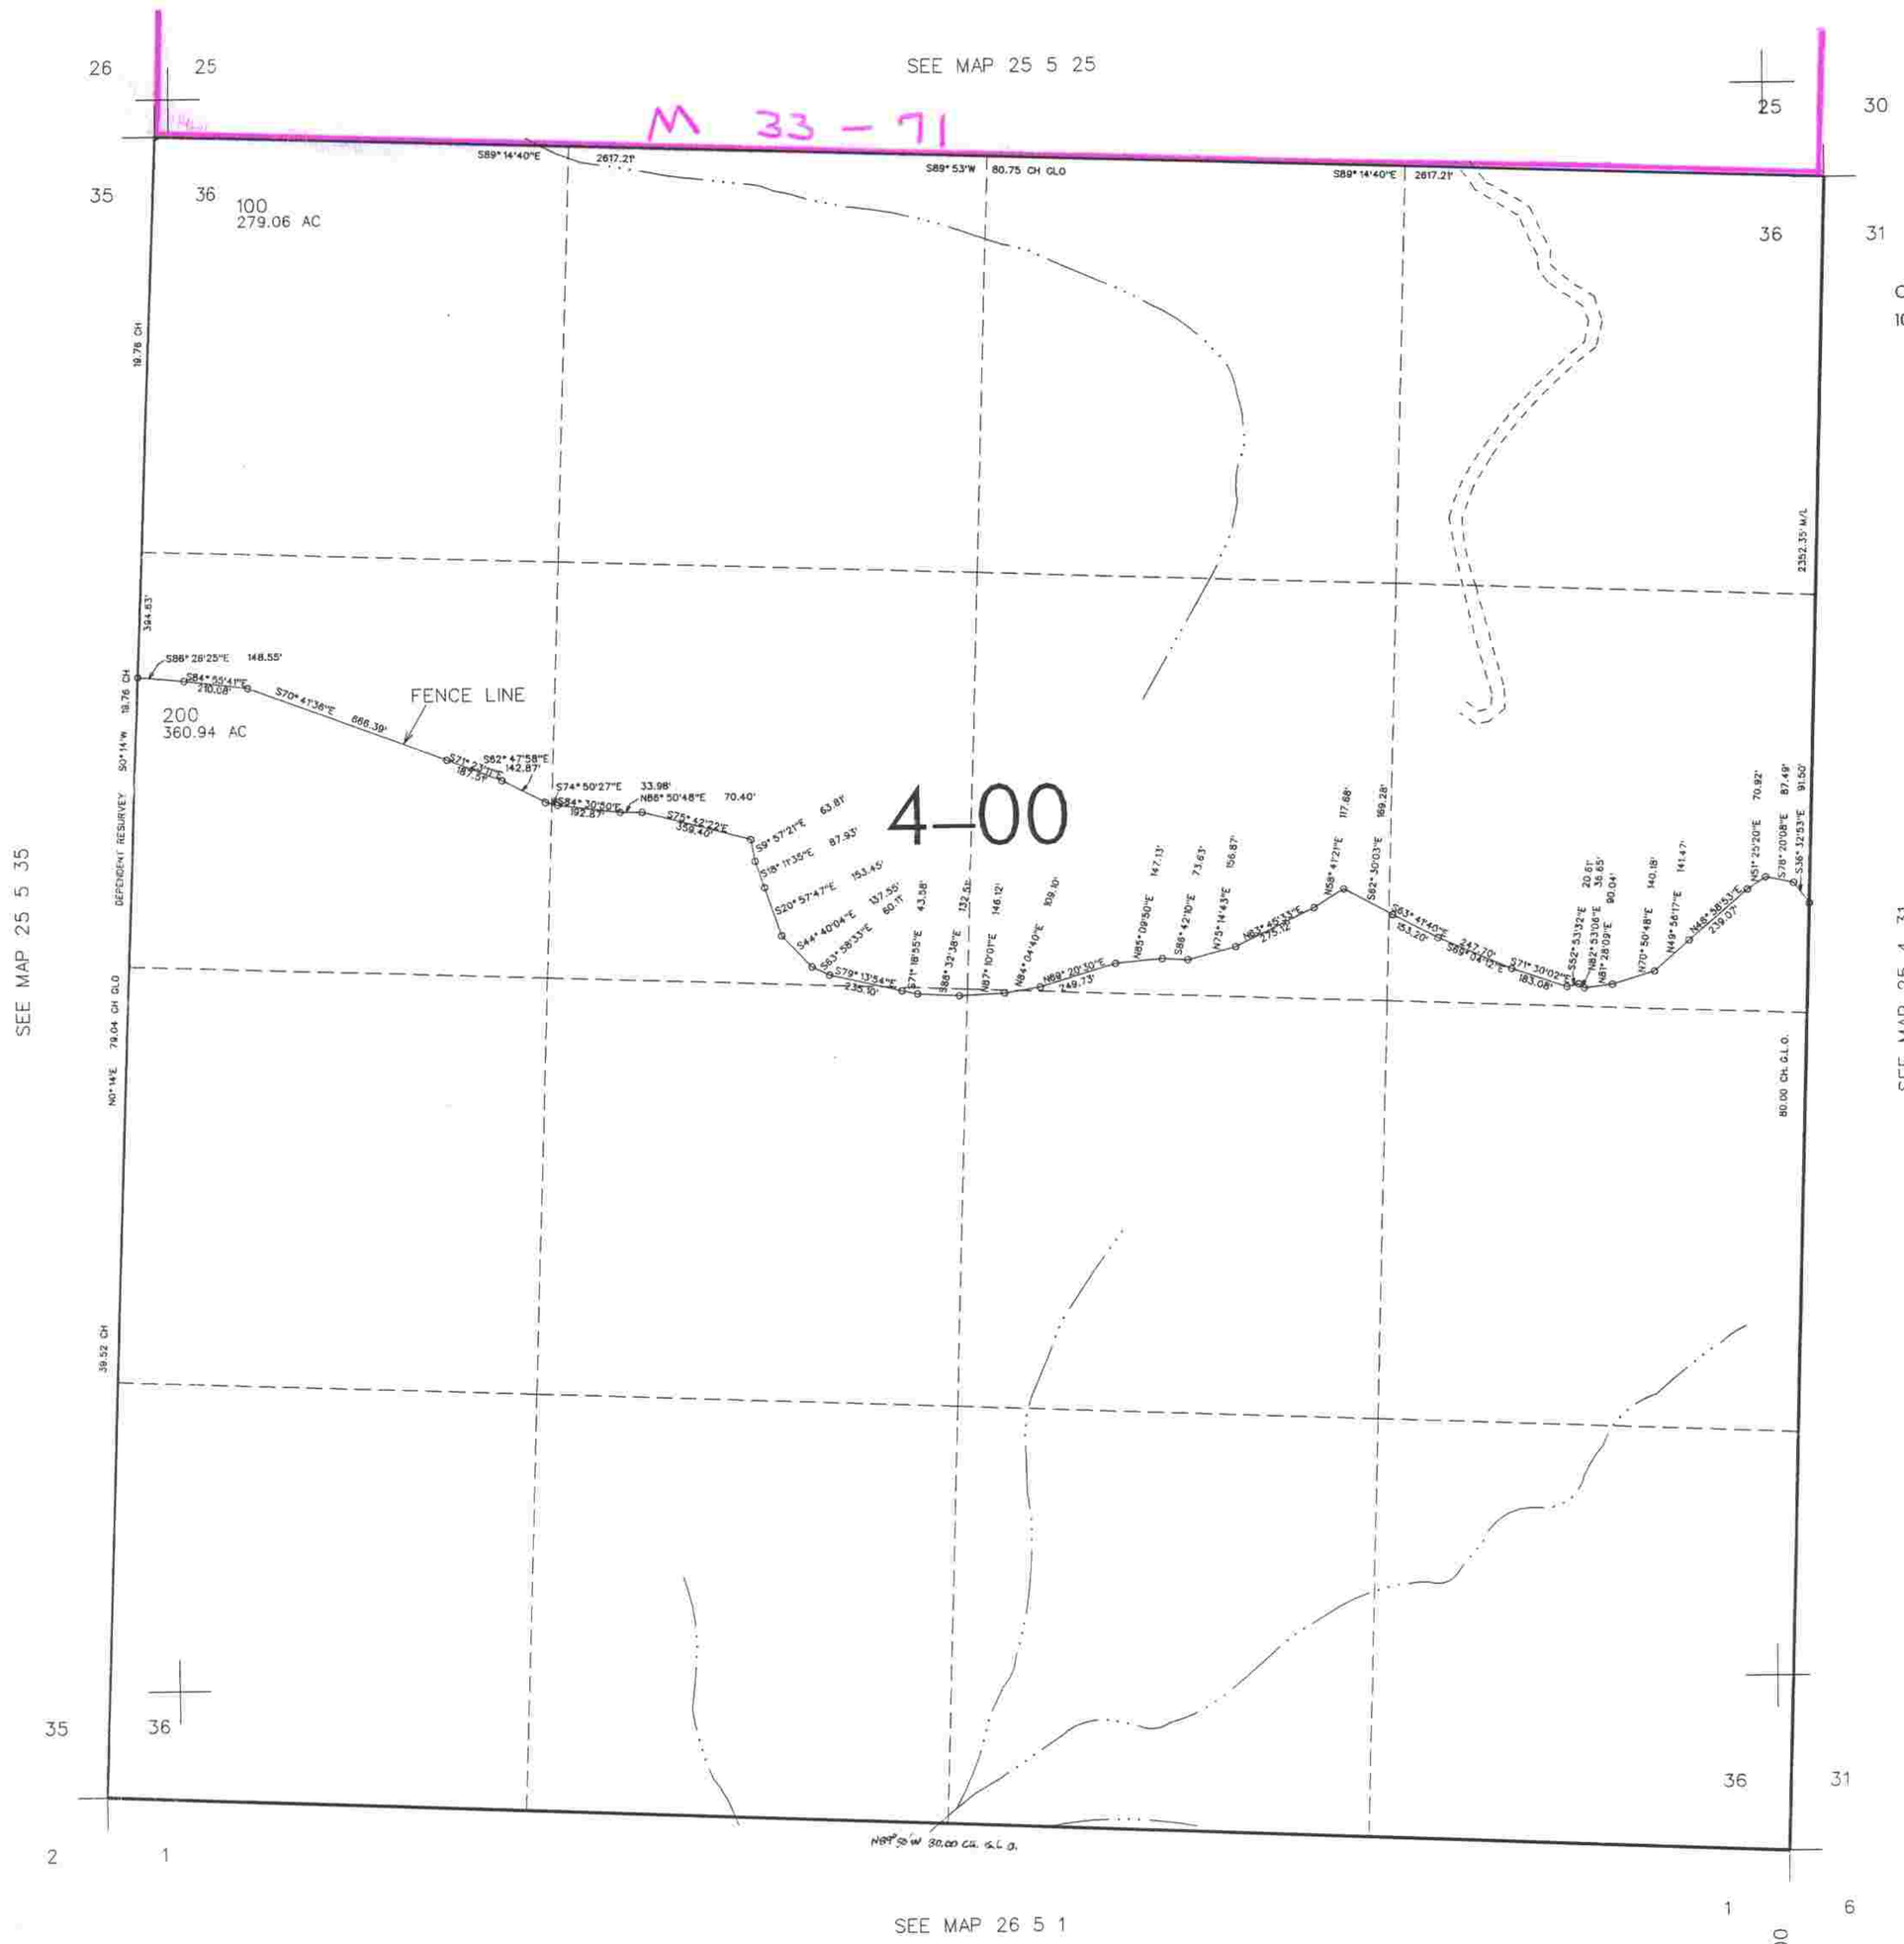

25 5 36

4/00