THIS MAP WAS PREPARED FOR ASSESSMENT PURPOSE ONLY.

SW1/4 SE1/4 SEC.13 T.25S. R.6W. W.M.
DOUGLAS COUNTY
1" = 100'

REVISED ON
3-13-06

25 6 13DC
SUTHERLIN

1/16
COR

CANCELLED NOS
301 501

641,500

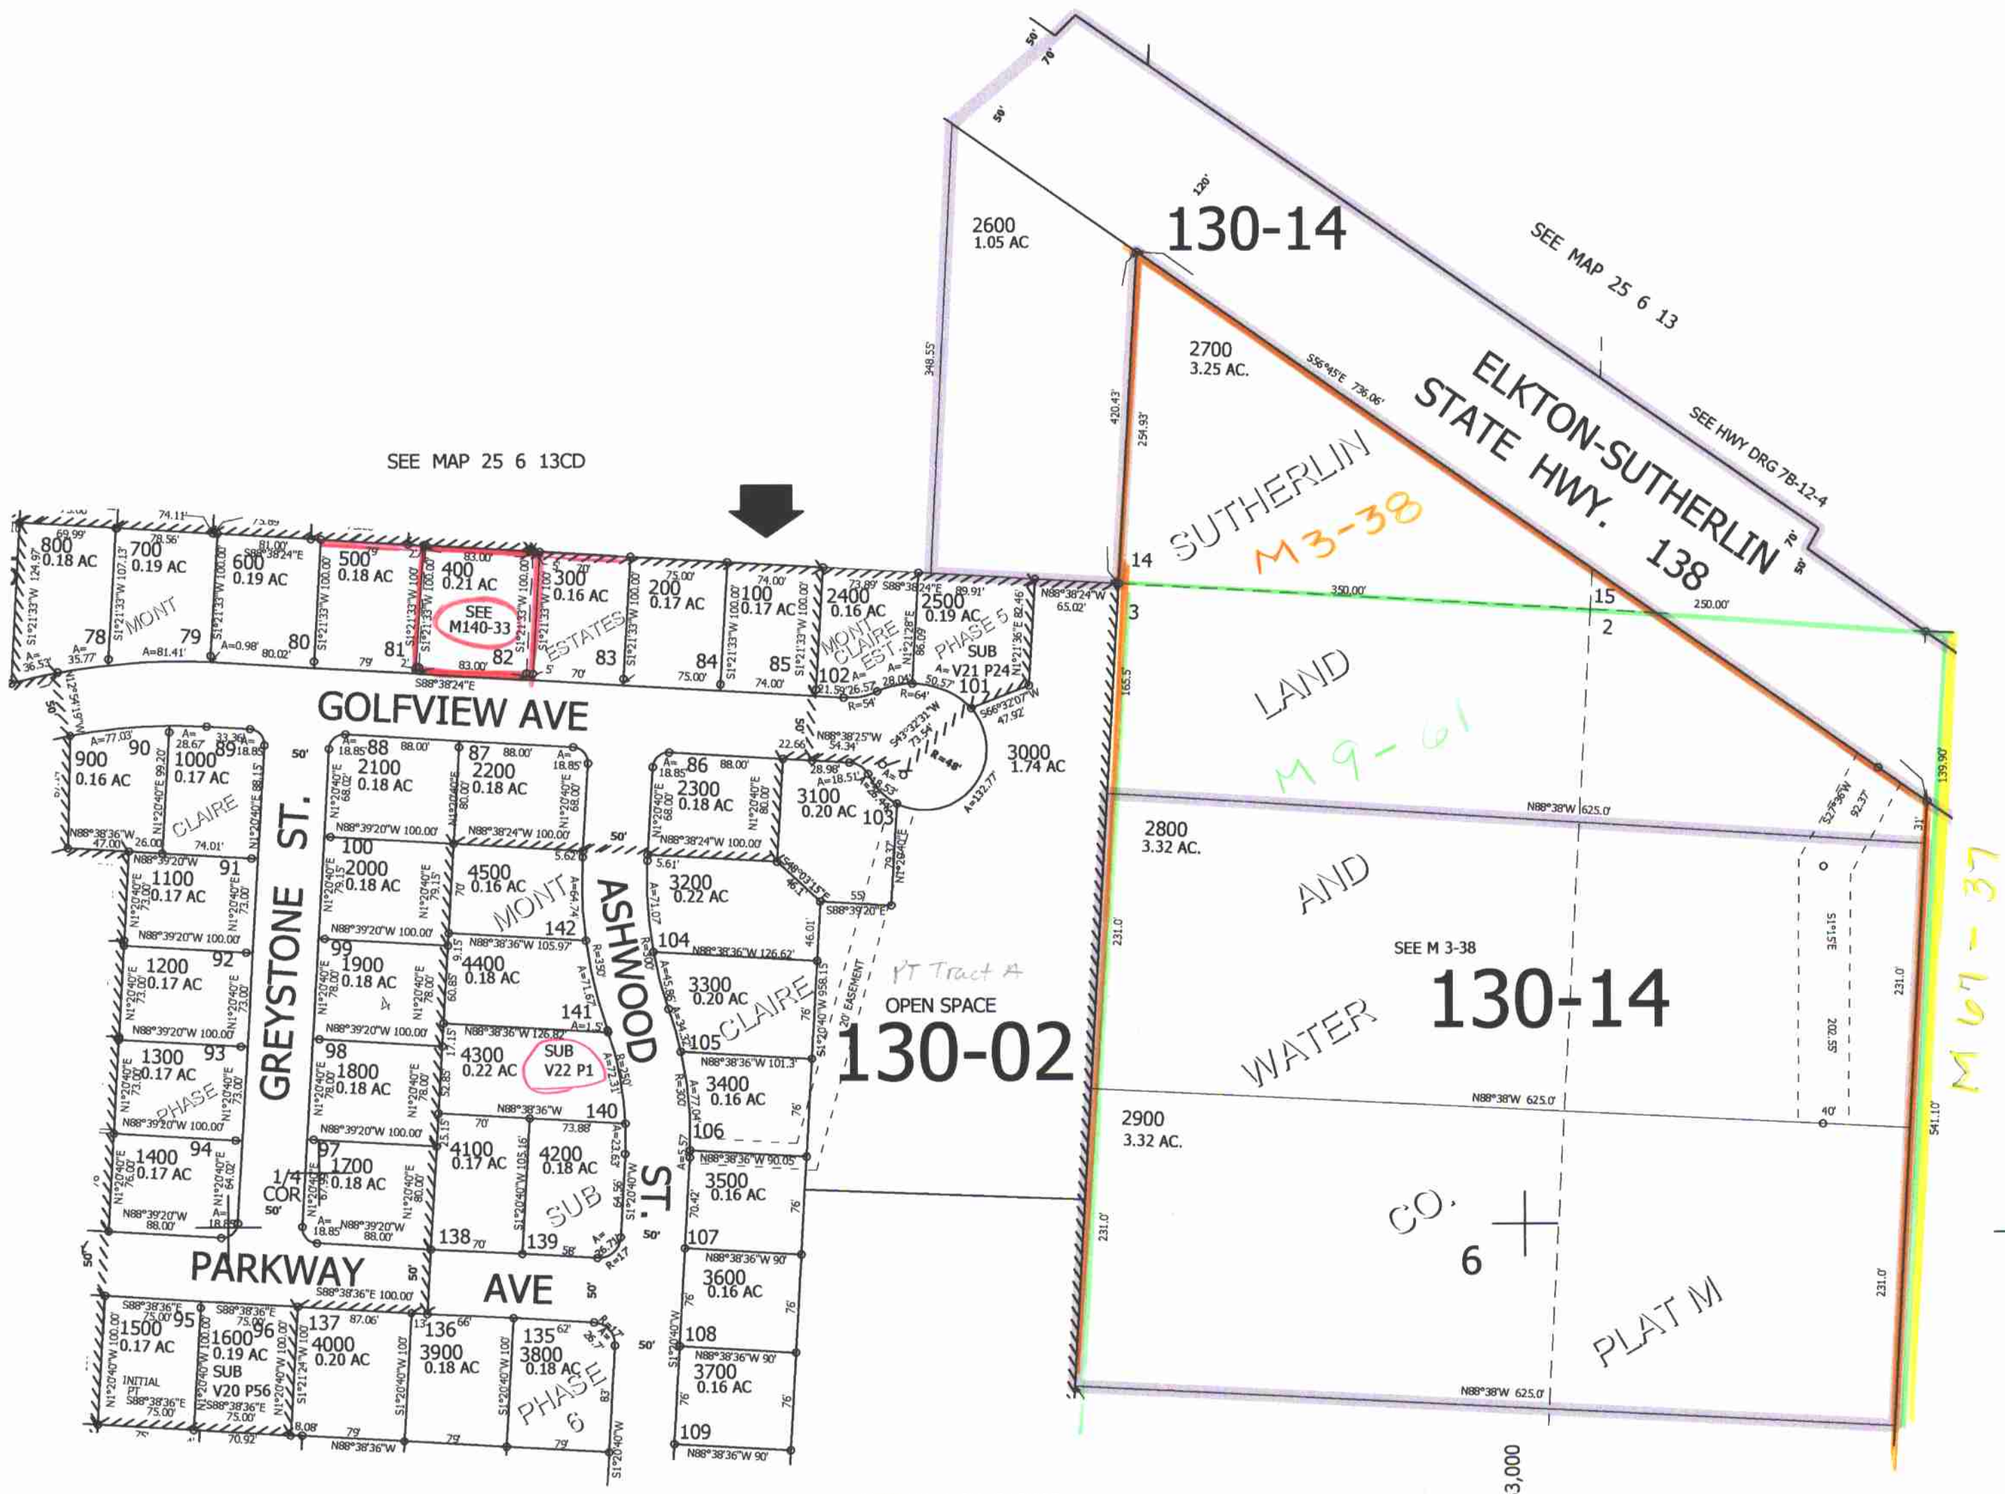

25 6 13DC
SUTHERLIN