THIS MAP WAS PREPARED FOR ASSESSMENT PURPOSE ONLY.

NW1/4NE1/4 SEC.24 T.25S. R.6W. W.M.
DOUGLAS COUNTY

1" = ~~200'~~ 100'

REVISED ON

25 6 24AB
SUTHERLIN

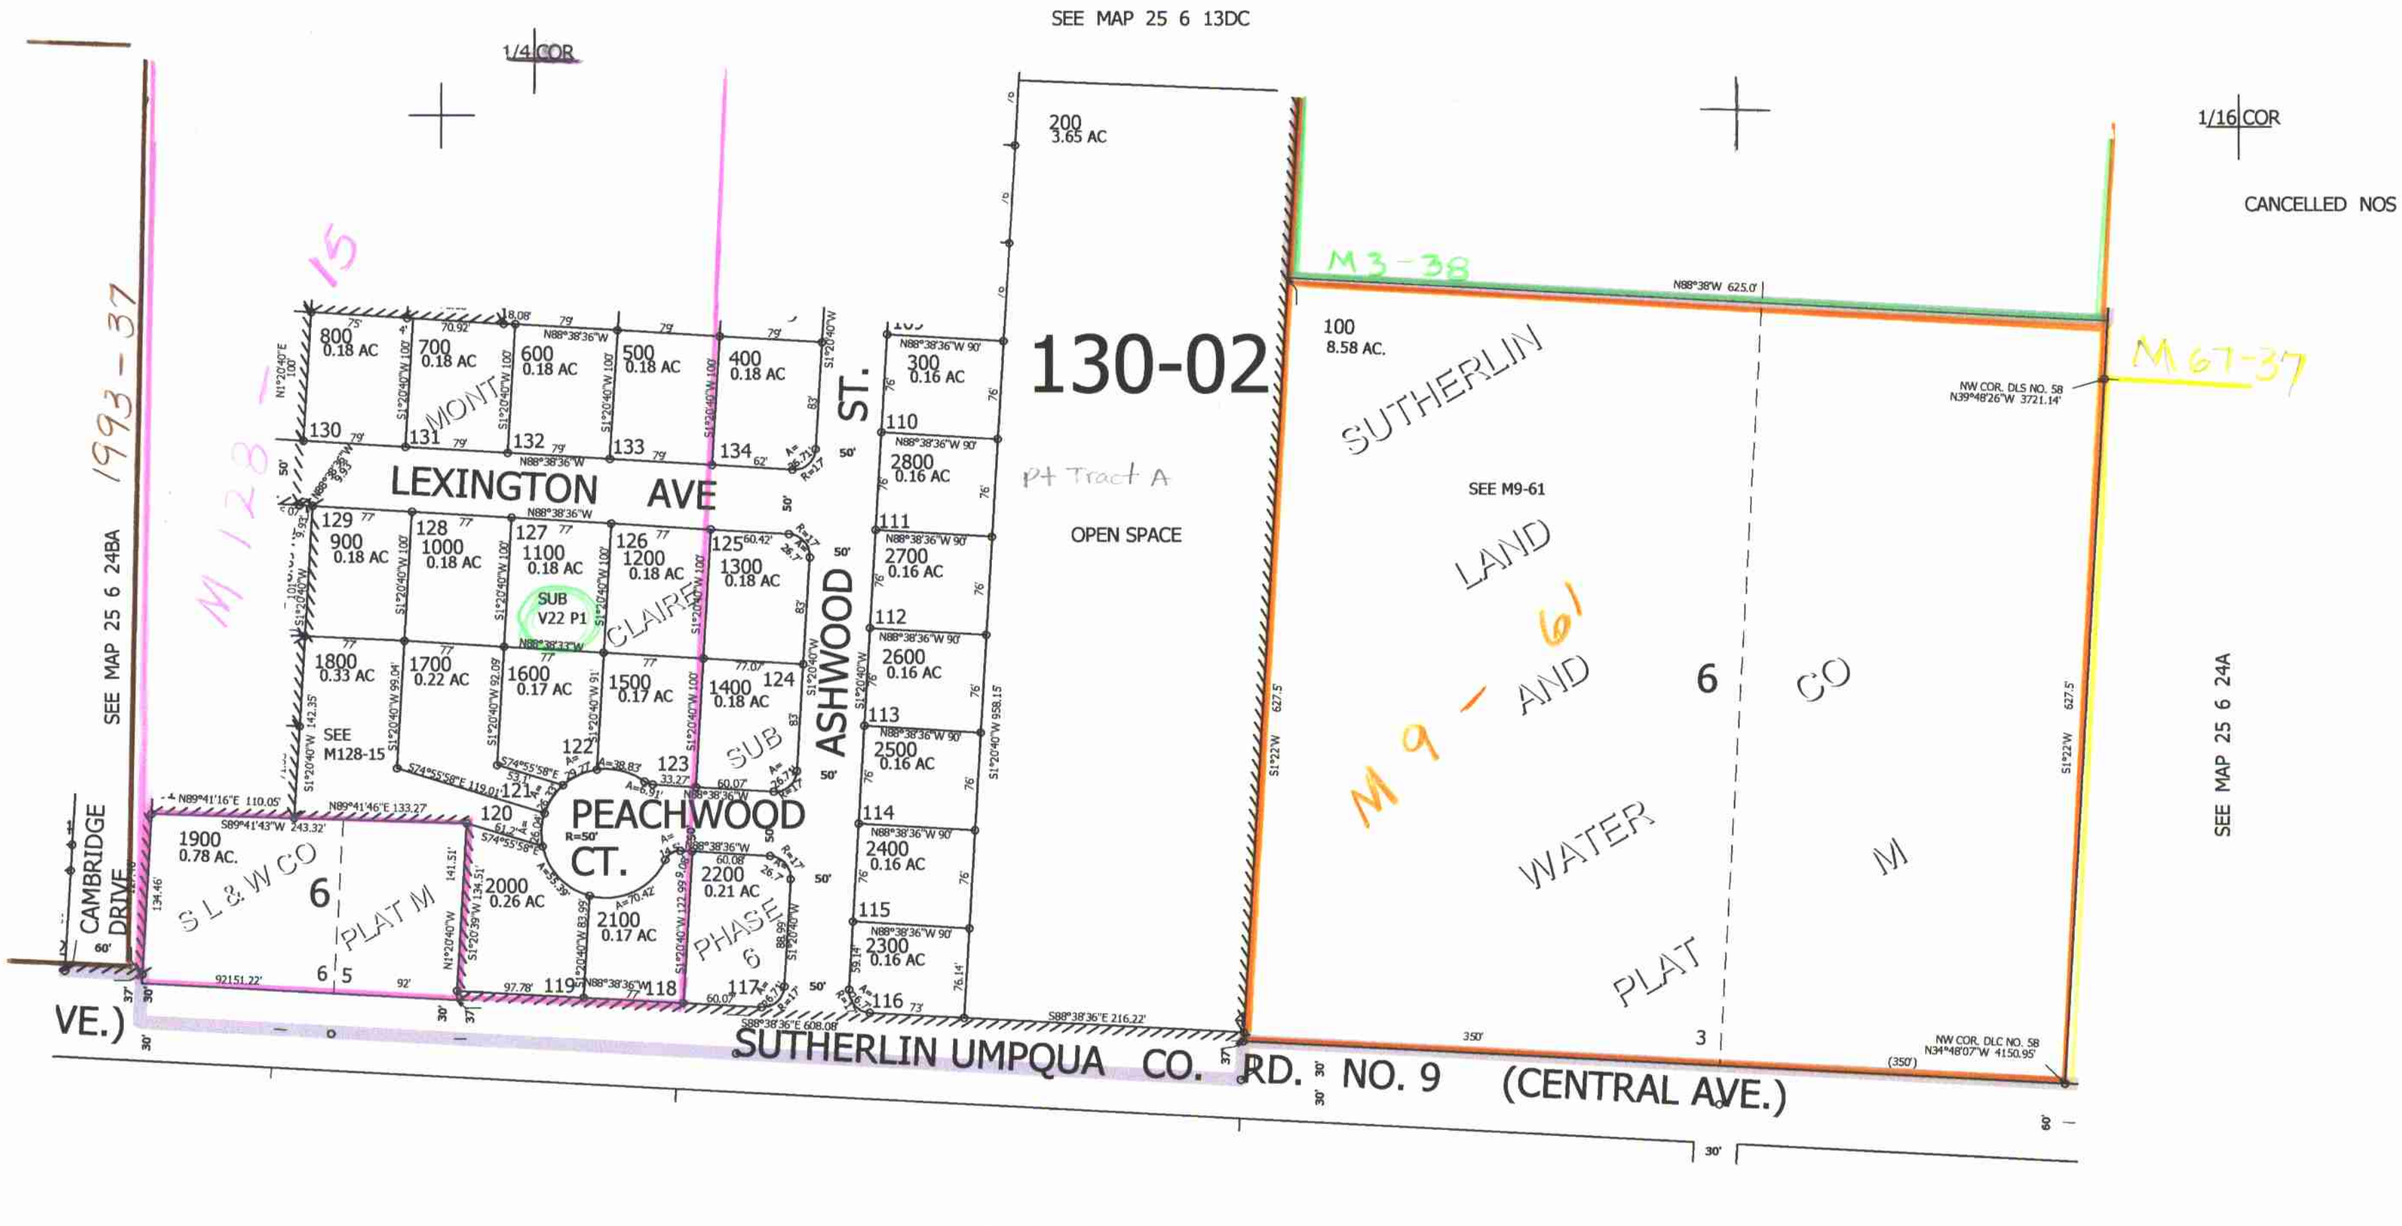

639,500

1/16 COR

1/16 COR

4,163,000

CMC 3/24/06

25 6 24AB
SUTHERLIN