THIS MAP WAS PREPARED FOR ASSESSMENT PURPOSE ONLY

SEC. 34 T.25S. R. 6W W.M.
DOUGLAS COUNTY

REVISED ON 11-15-00

25 6 34
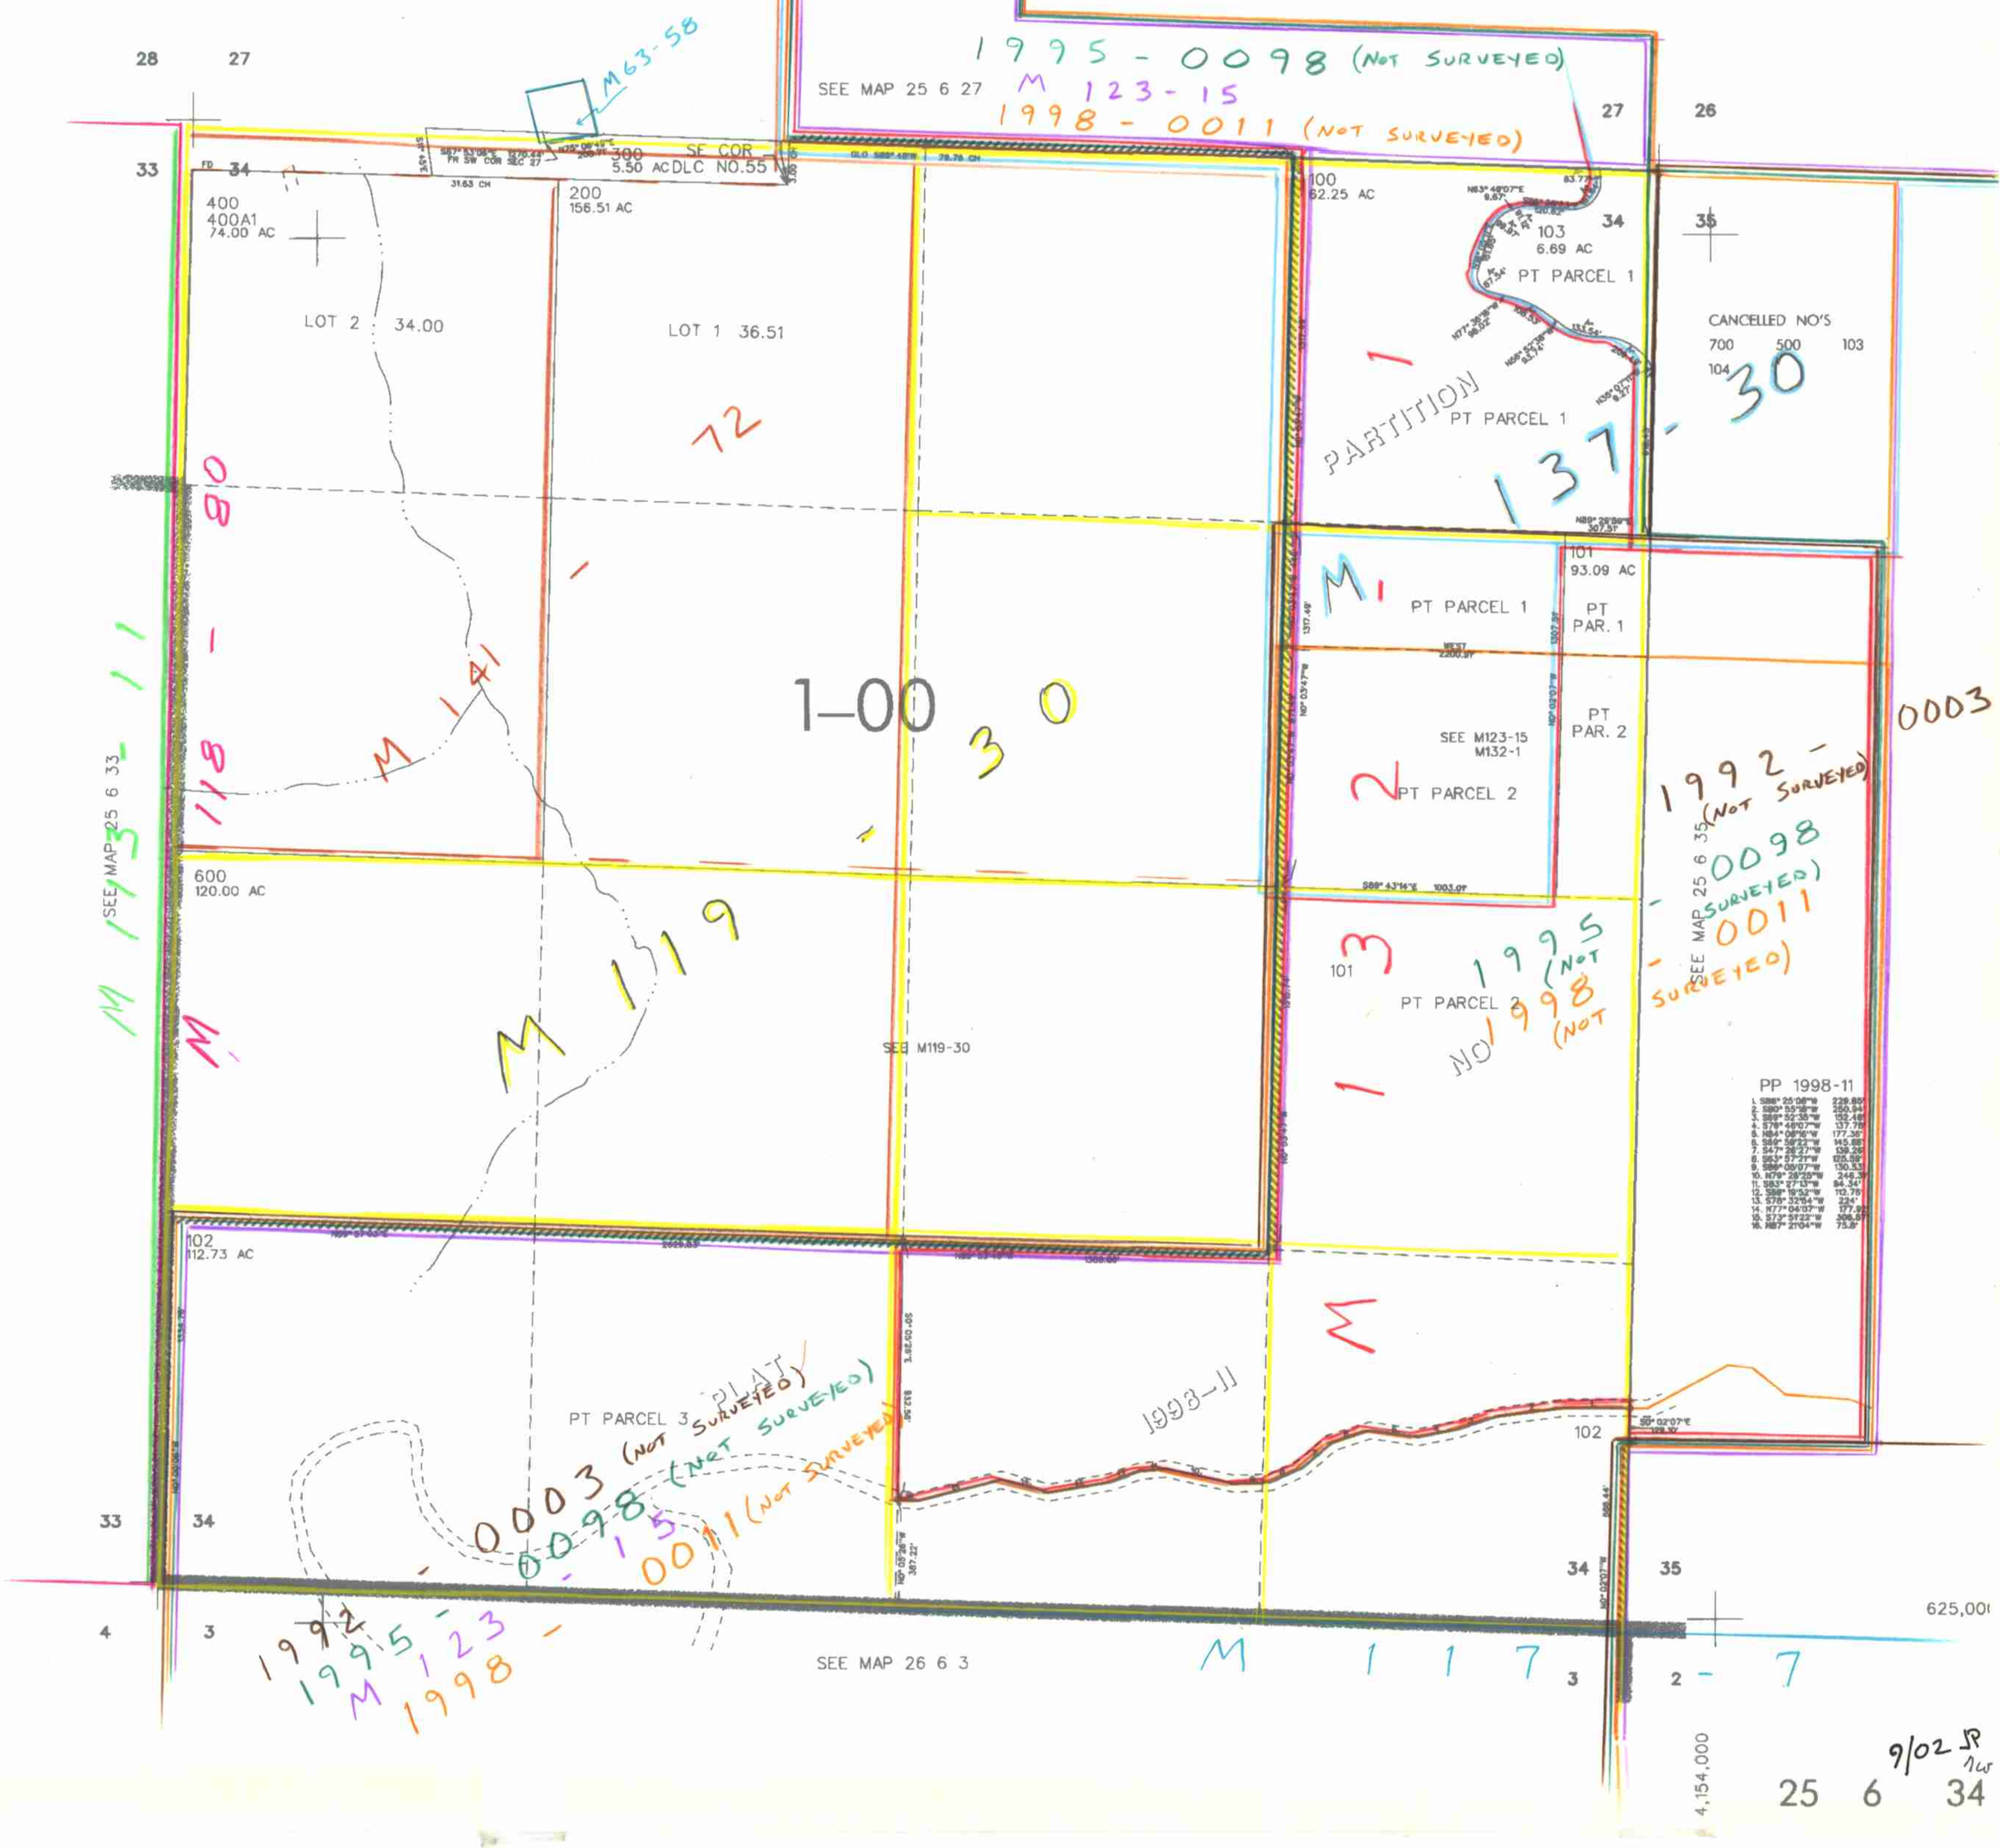
1" = 400'