


THIS MAP WAS PREPARED FOR ASSESSMENT PURPOSE ONLY.

SECTION 34 T.25S. R.7W. W.M.  
DOUGLAS COUNTY

25 7 34'

1"=400'

SEE MAP 25 7 27

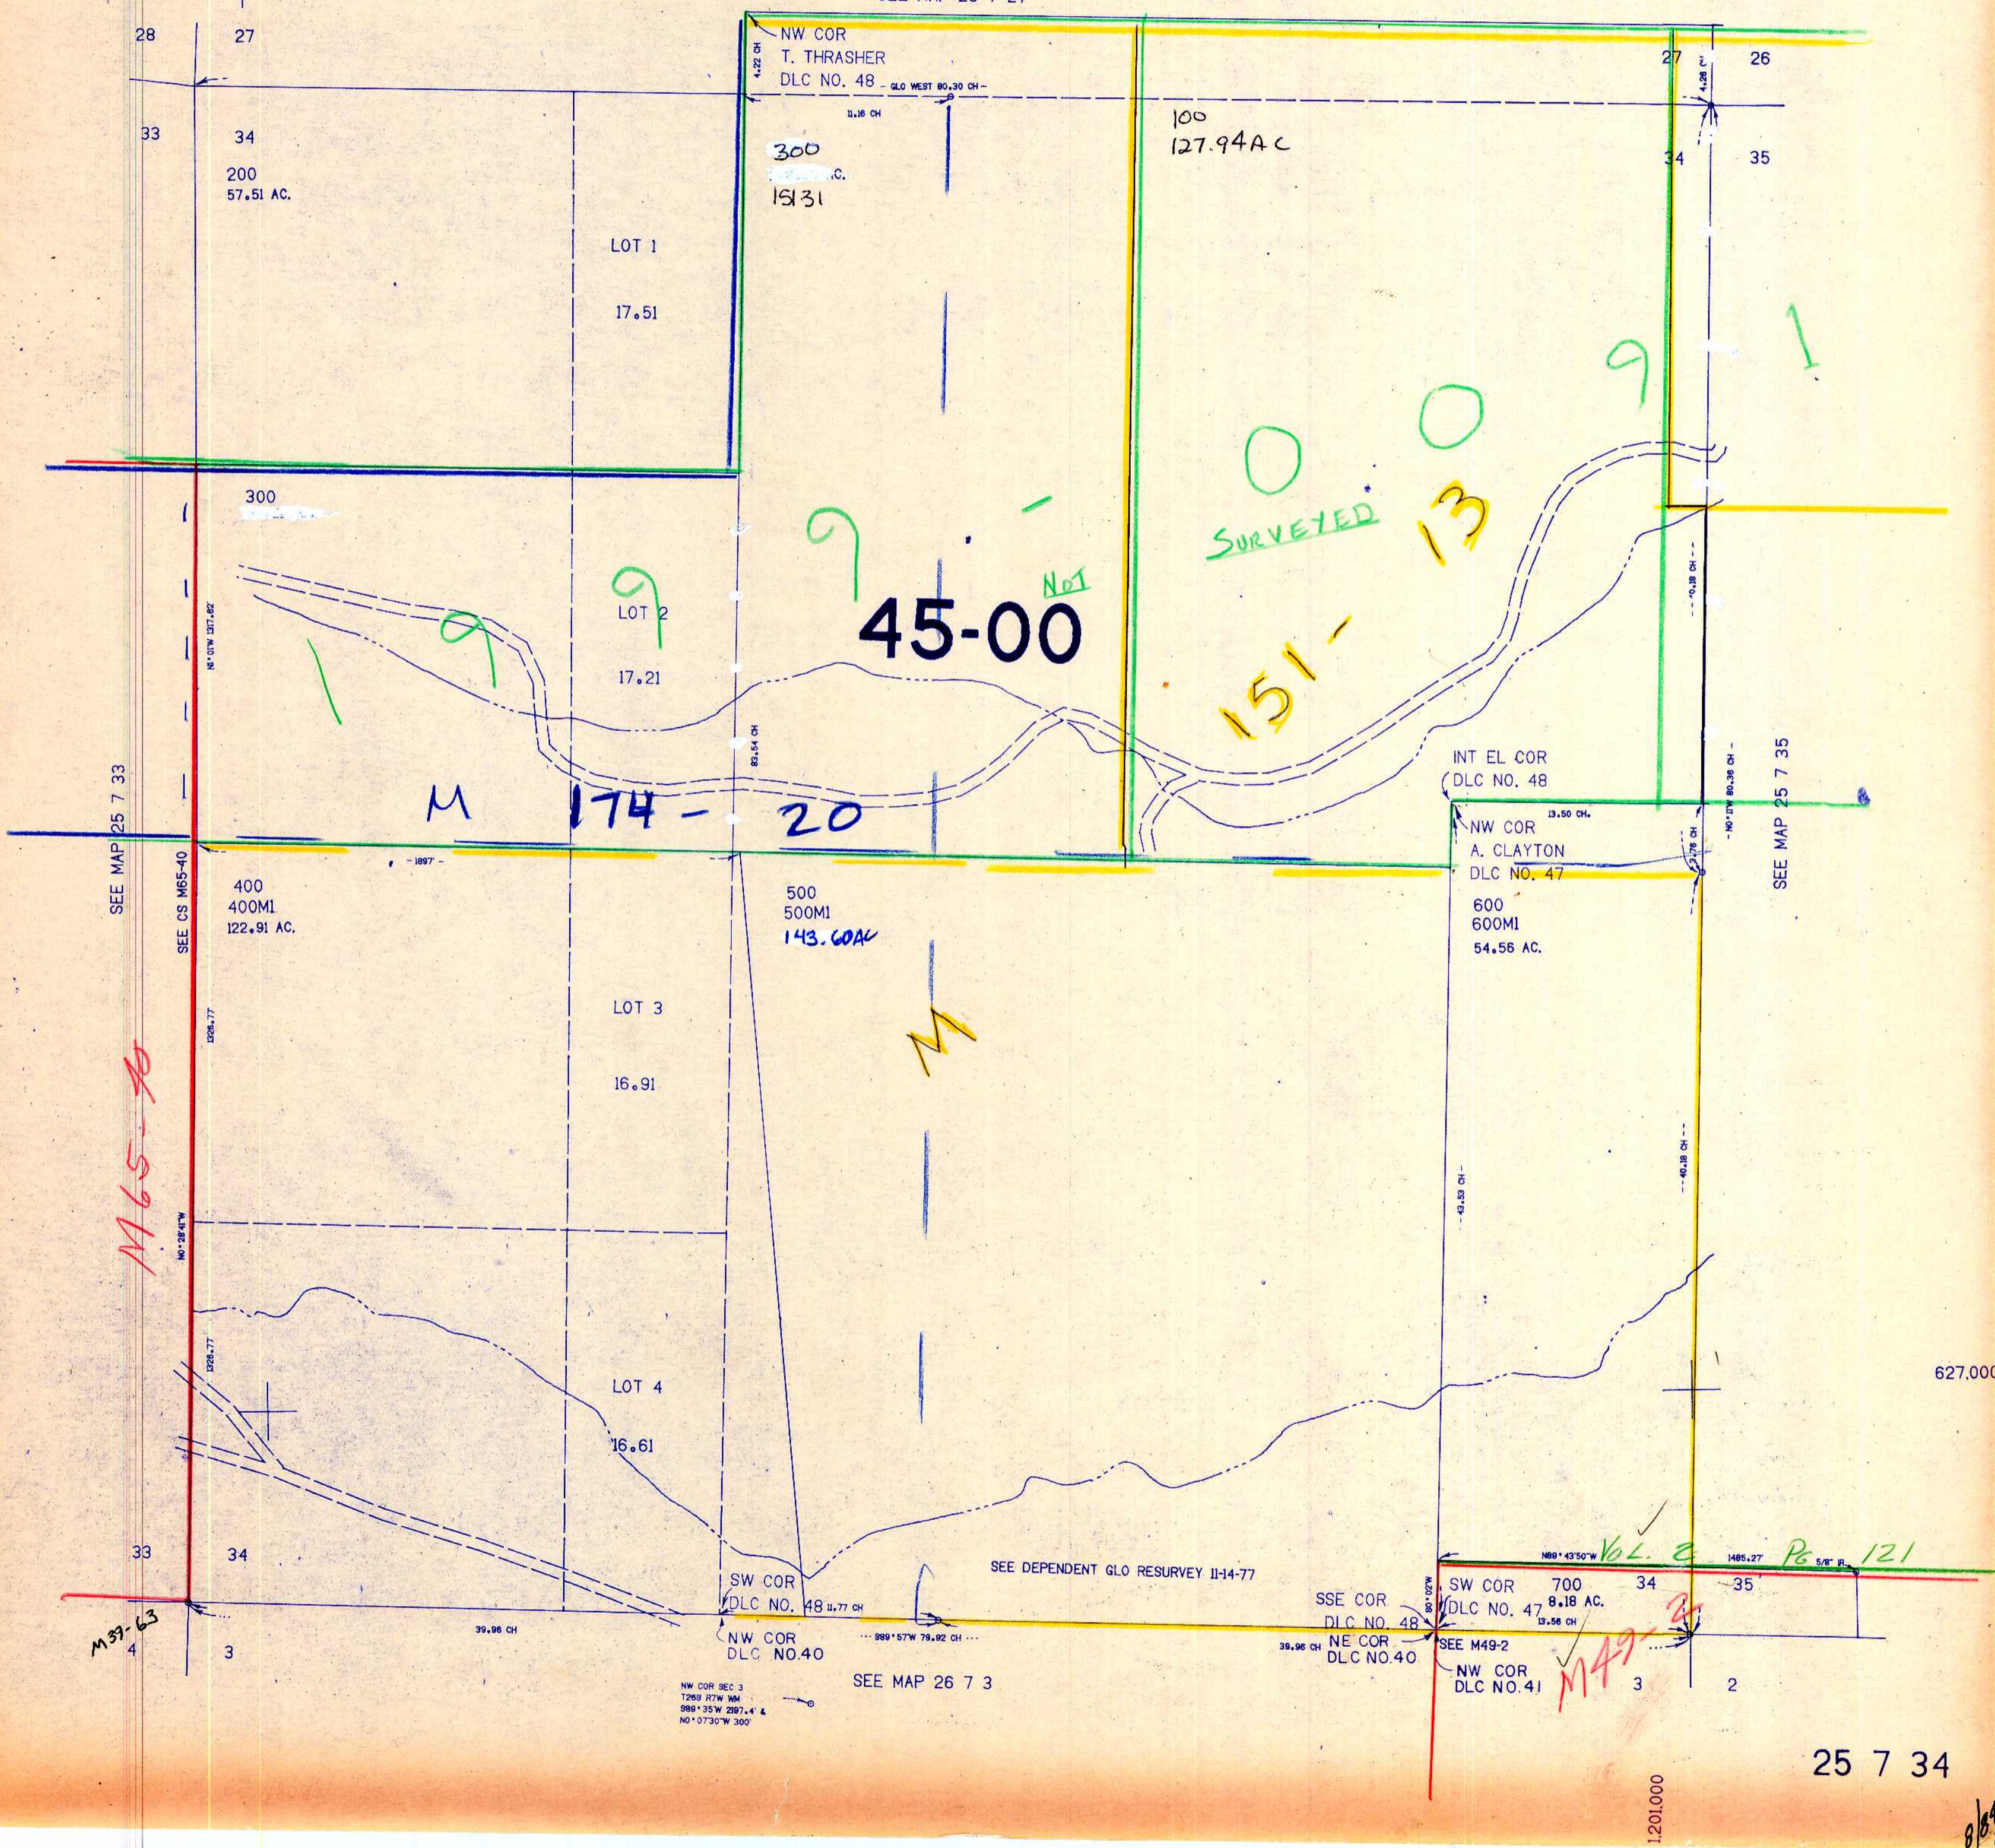

NW COR  
T. THRASHER  
DLC NO. 48 - GLO WEST 80.30 CH -

300  
15131

100  
127.94 AC

200  
57.51 AC.

LOT 1  
17.51

LOT 2  
17.21

45-00

SURVEYED

13

M 174-20

INT EL COR  
DLC NO. 48

NW COR  
A. CLAYTON  
DLC NO. 47

400  
400MI  
122.91 AC.

500  
500MI  
143.60 AC

600  
600MI  
54.56 AC.

LOT 3  
16.91

LOT 4  
16.61

SEE DEPENDENT GLO RESURVEY 11-14-77

SW COR  
DLC NO. 48 11.77 CH

SSE COR  
DLC NO. 48  
NE COR  
DLC NO. 40

SW COR  
DLC NO. 47 8.18 AC.

SEE M49-2  
NW COR  
DLC NO. 41

NW COR SEC 3  
T26S R7W WM  
989° 35' W 2197.4' &  
N0° 07' 30" W 300'

SEE MAP 26 7 3

25 7 34

M 65-40

M 39-63

1,201,000

627,000

8/10/78