


SECTION 17 T.26S. R. 2 W. W.M.  
DOUGLAS COUNTY

26 2 17

THIS MAP WAS PREPARED FOR  
ASSESSMENT PURPOSE ONLY.

1" = 400'

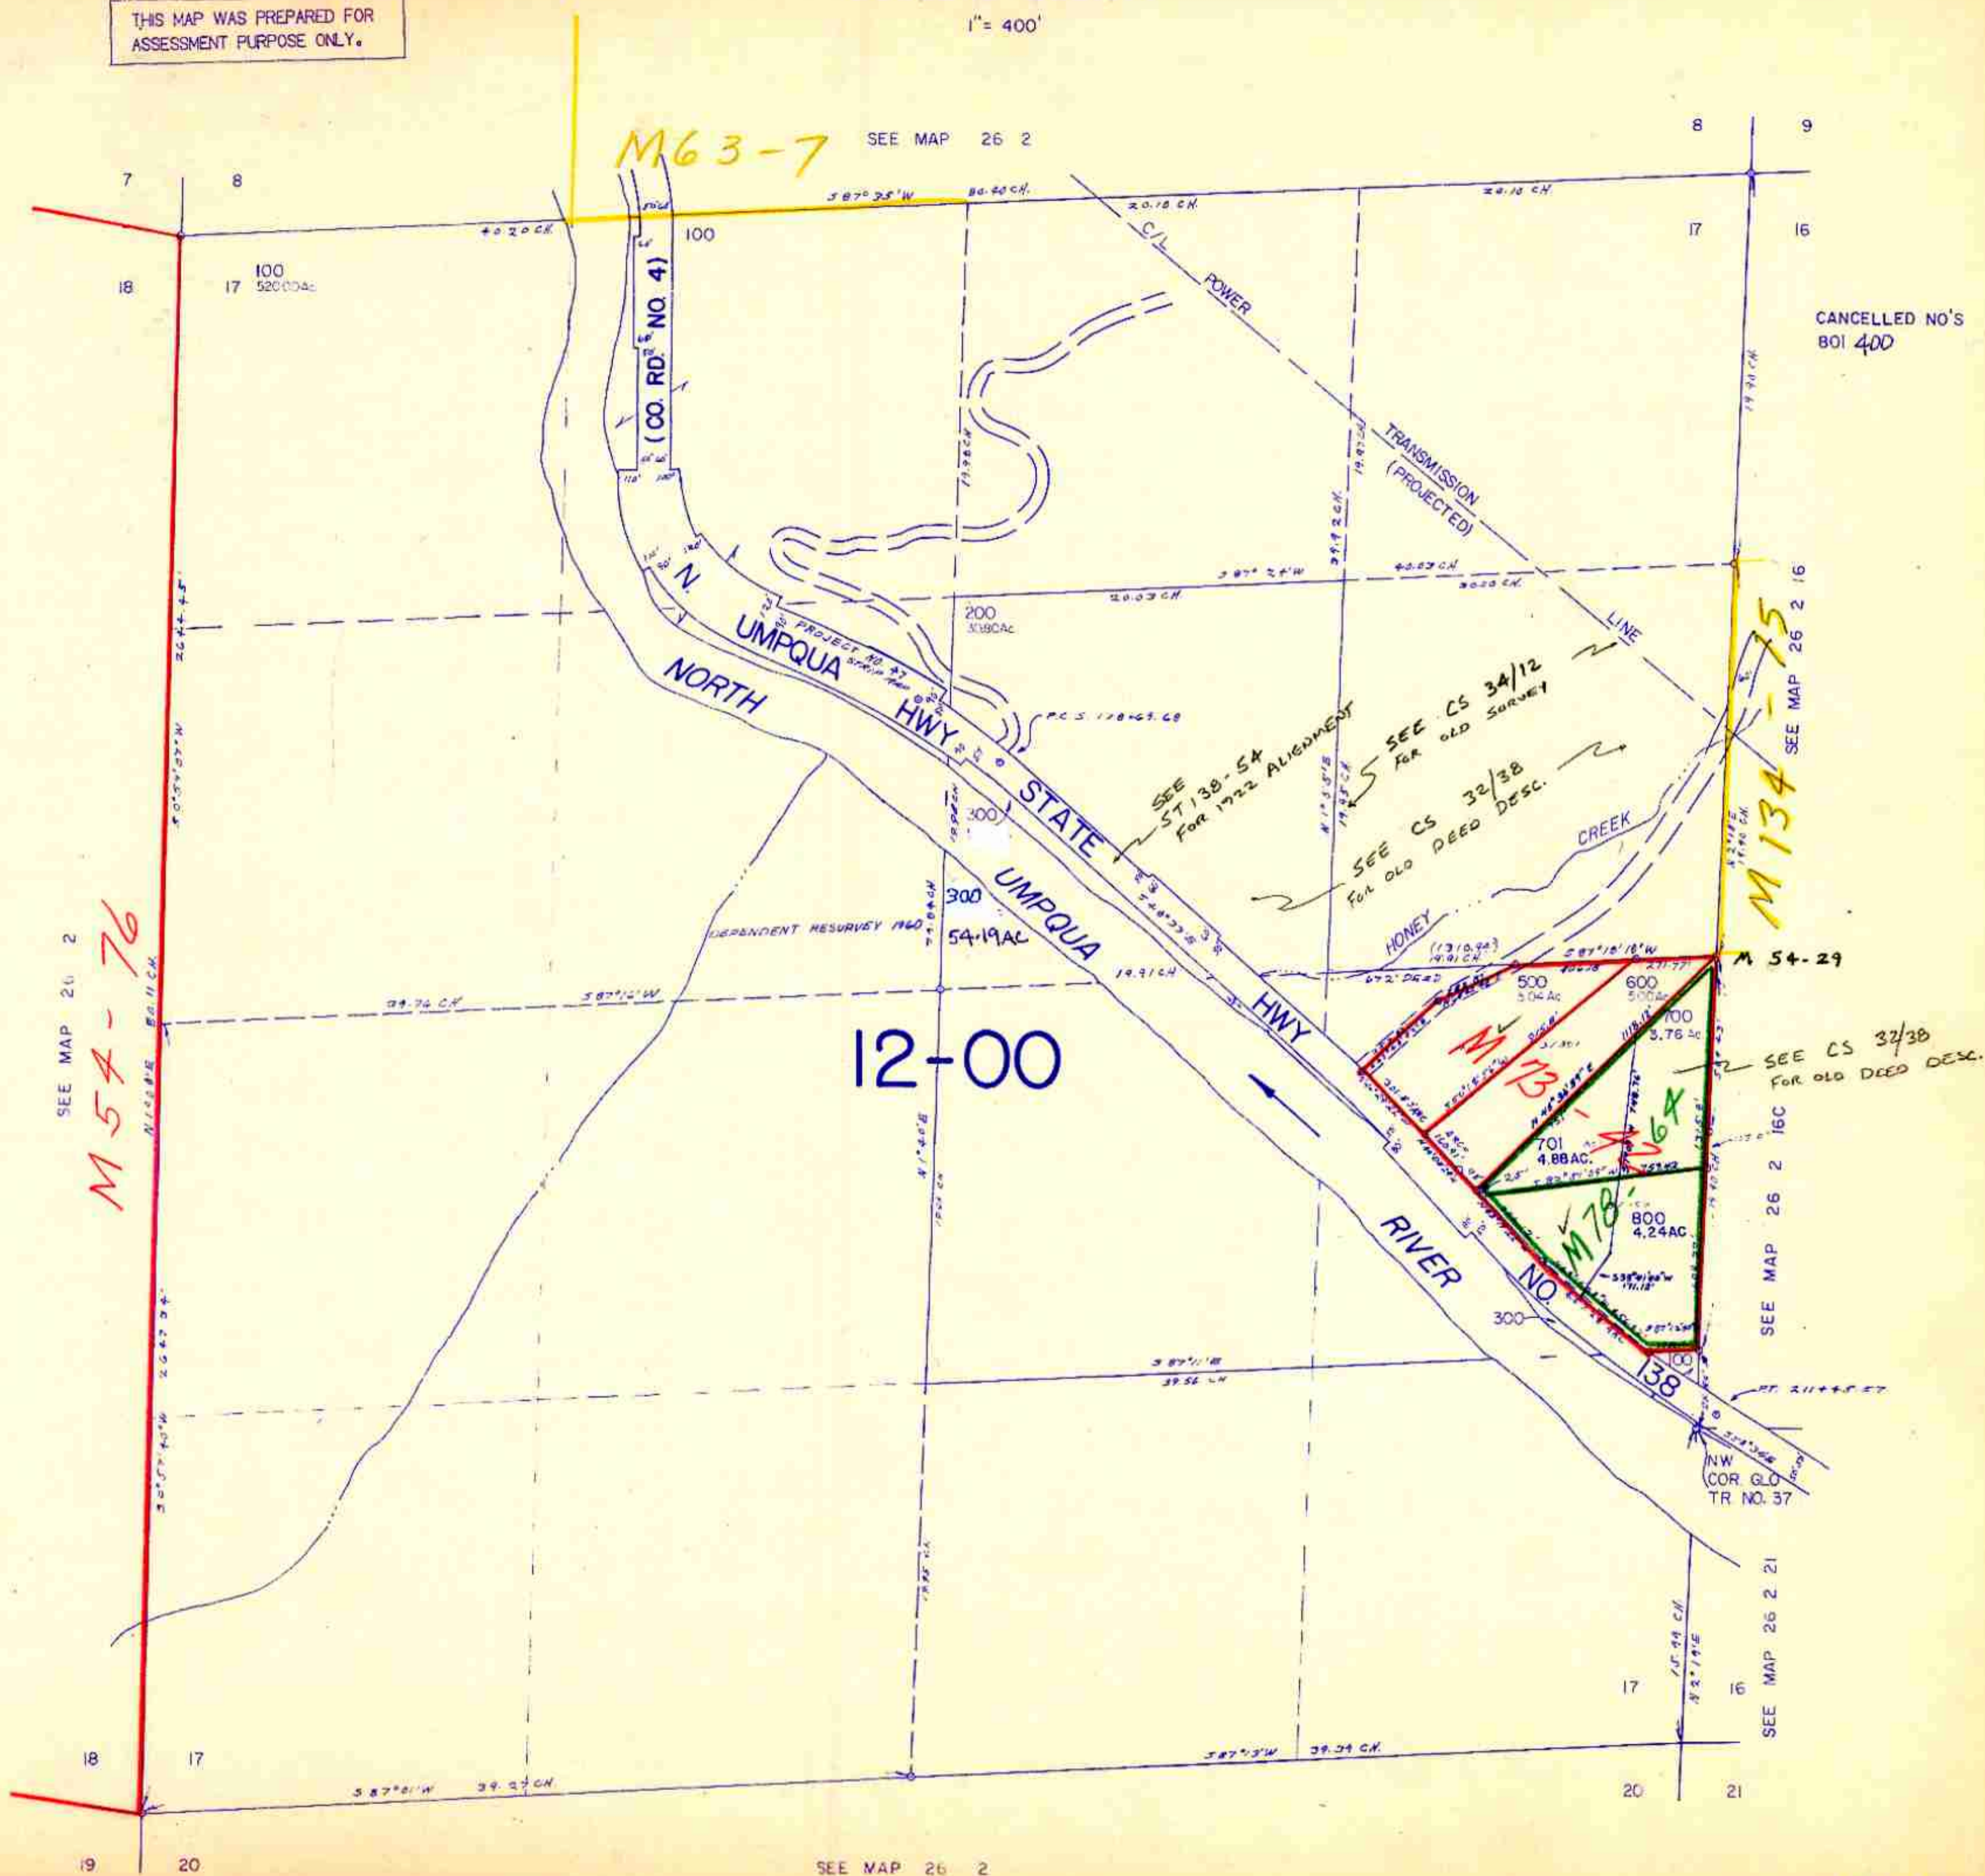

SEE MAP 26 2

26 2 17

10/2