SECTION 2 T.26S. R.3W. W.M.
DOUGLAS COUNTY

1"=400'

THIS MAP WAS PREPARED FOR ASSESSMENT PURPOSE ONLY.

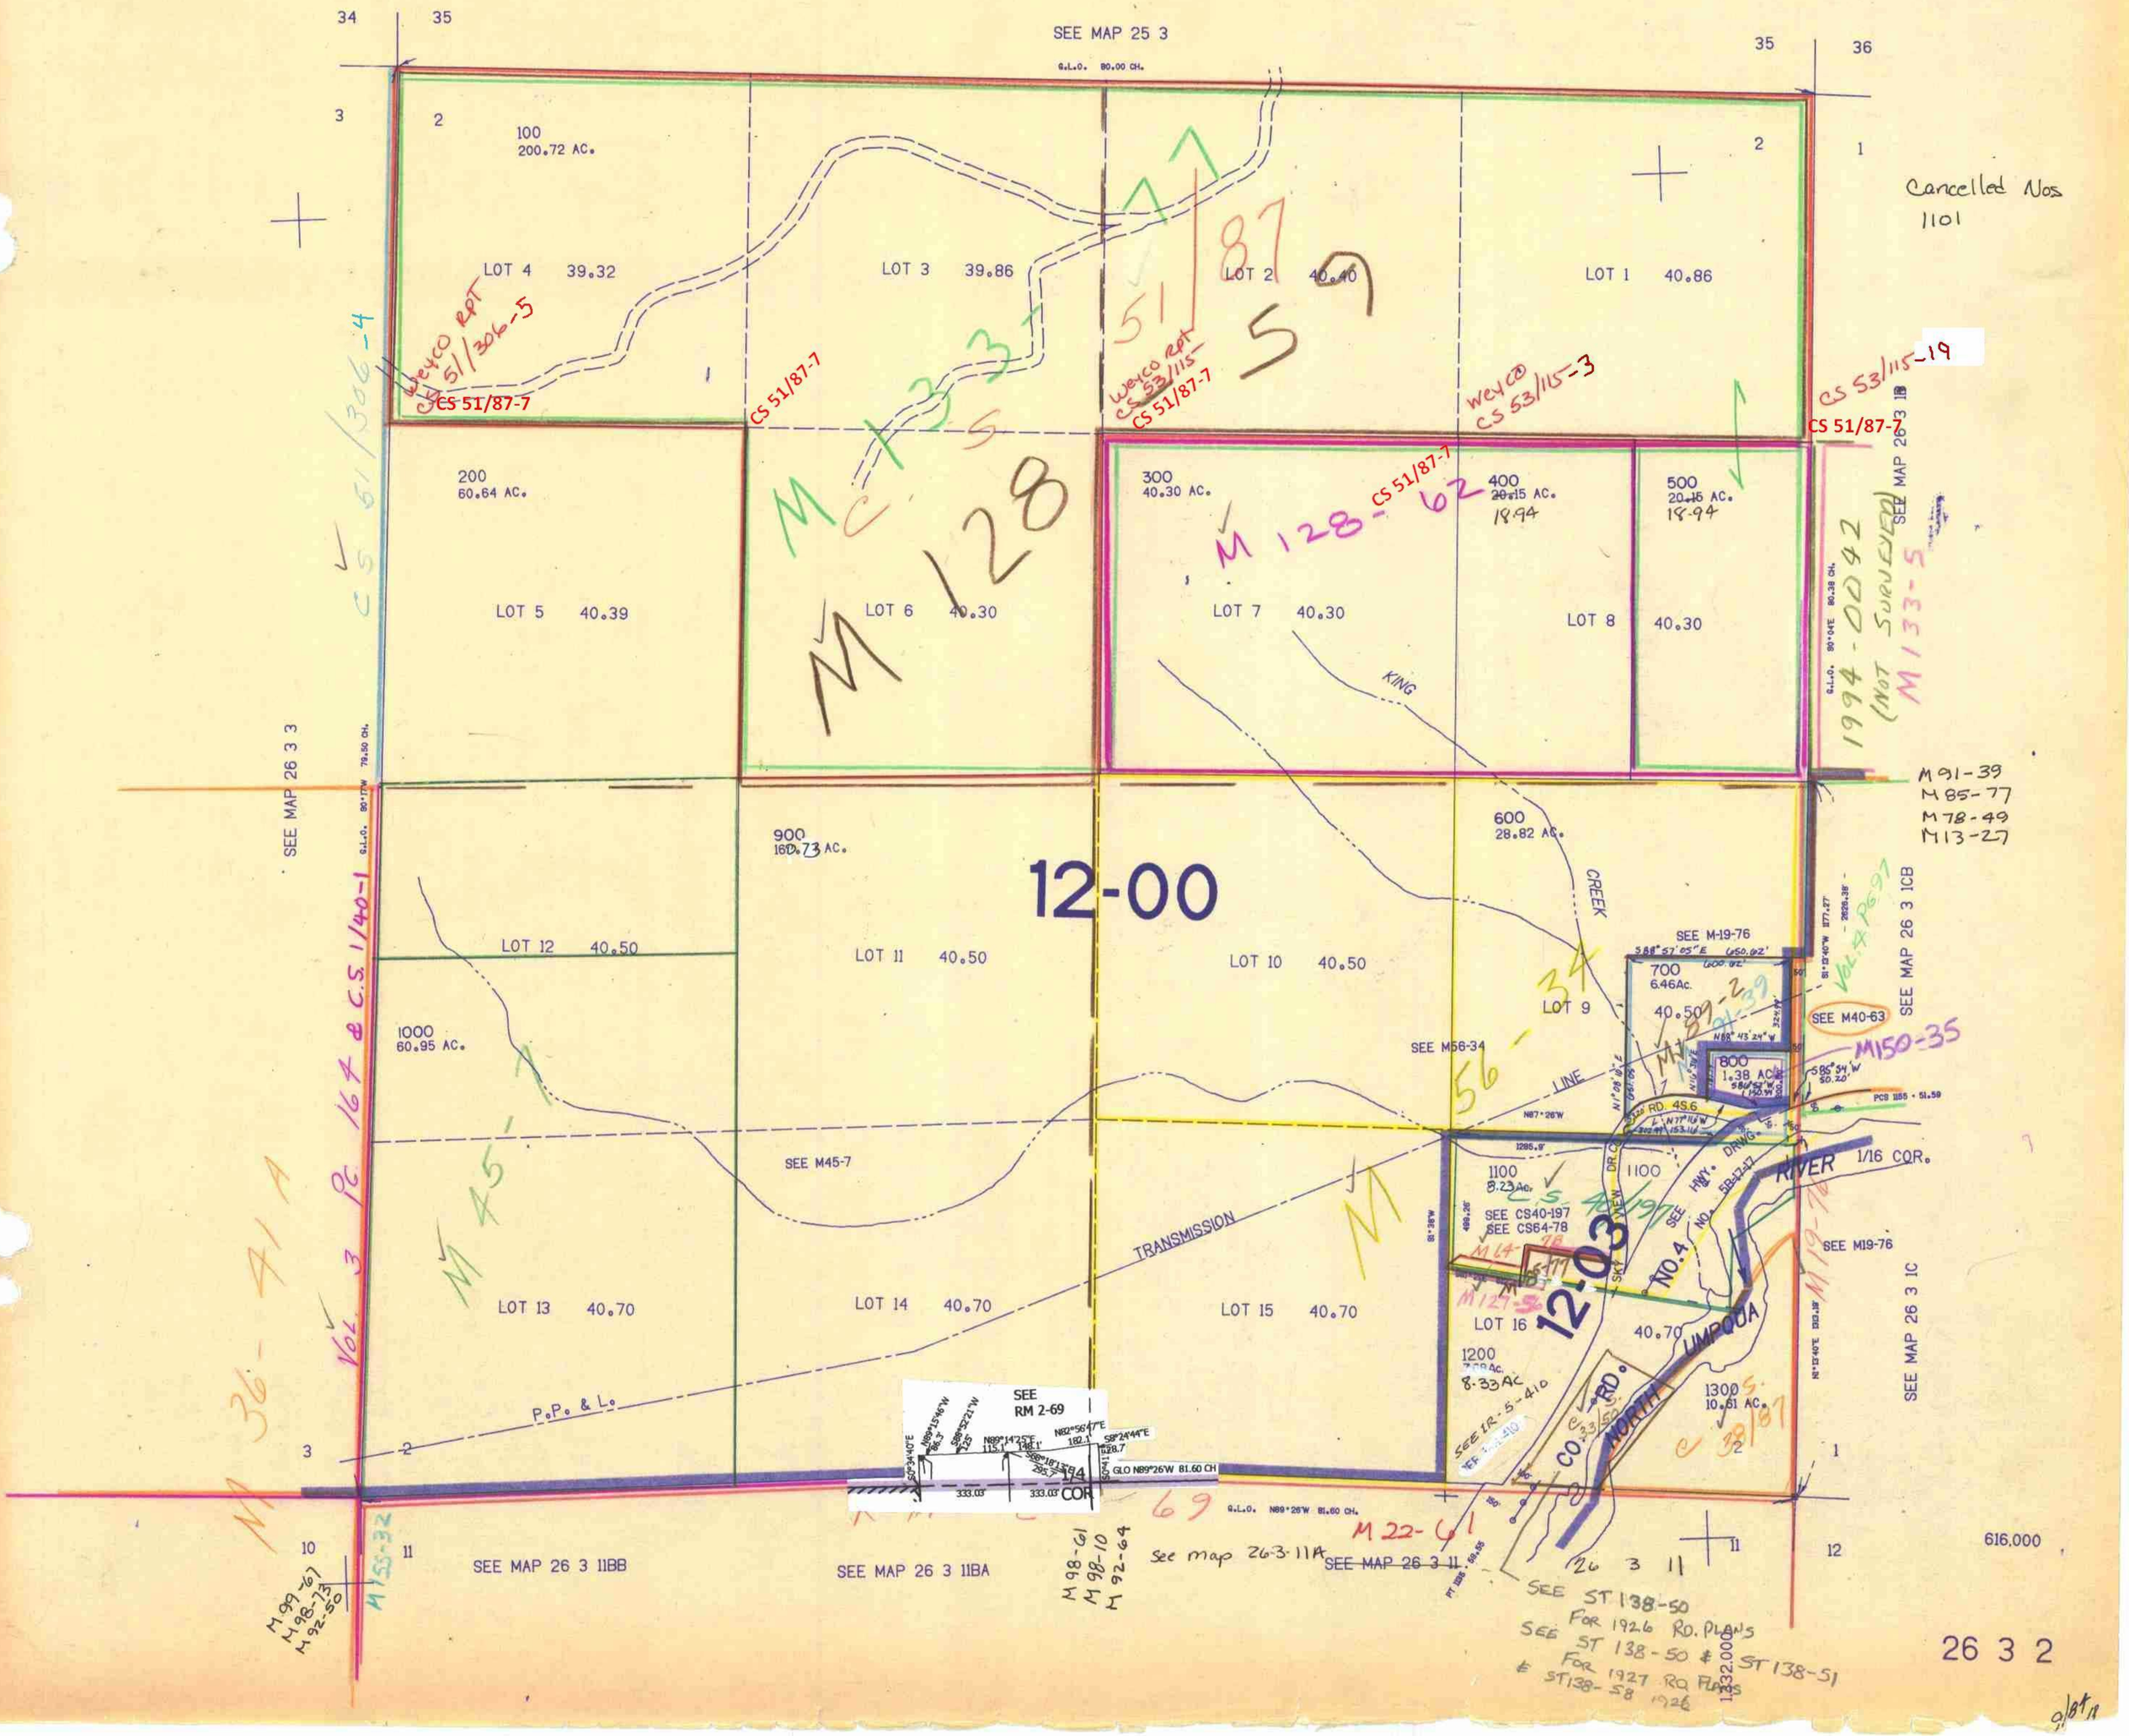

Cancelled Nos
1101

CS 51/87-7
CS 53/115-19
CS 51/87-7
CS 51/306-4
Weyco rpt CS 51/306-5
CS 51/87-7
Weyco rpt CS 53/115-
CS 51/87-7
Weyco CS 53/115-3
M 128-62
CS 51/87-7
1994-0042 (NOT SURVEYED)
M133-5
M91-39
M85-77
M78-49
M13-27
M 128
M 133
M 45
M 36-41A
Vol. 3 Pg 164 & C.S. 1/40-1
M 155-32
M99-67
M98-73
M92-50
M98-61
M98-10
M92-64
M 22-61
See map 26-3-11A
SEE ST 138-50 FOR 1926 RD. PLANS
SEE ST 138-50 & ST 138-51 FOR 1927 RD PLANS
& ST 138-58 1926
M150-35
Vol. A Pg 97
M 19-76
M 127-5
M 14-78
M 56-34
M 89-2
M 12-39
M 69
