THIS MAP WAS PREPARED FOR ASSESSMENT PURPOSE ONLY.

SEC.10 T.26S. R.3W. W.M.
DOUGLAS COUNTY
1" = 400'

REVISED ON 8-20-19
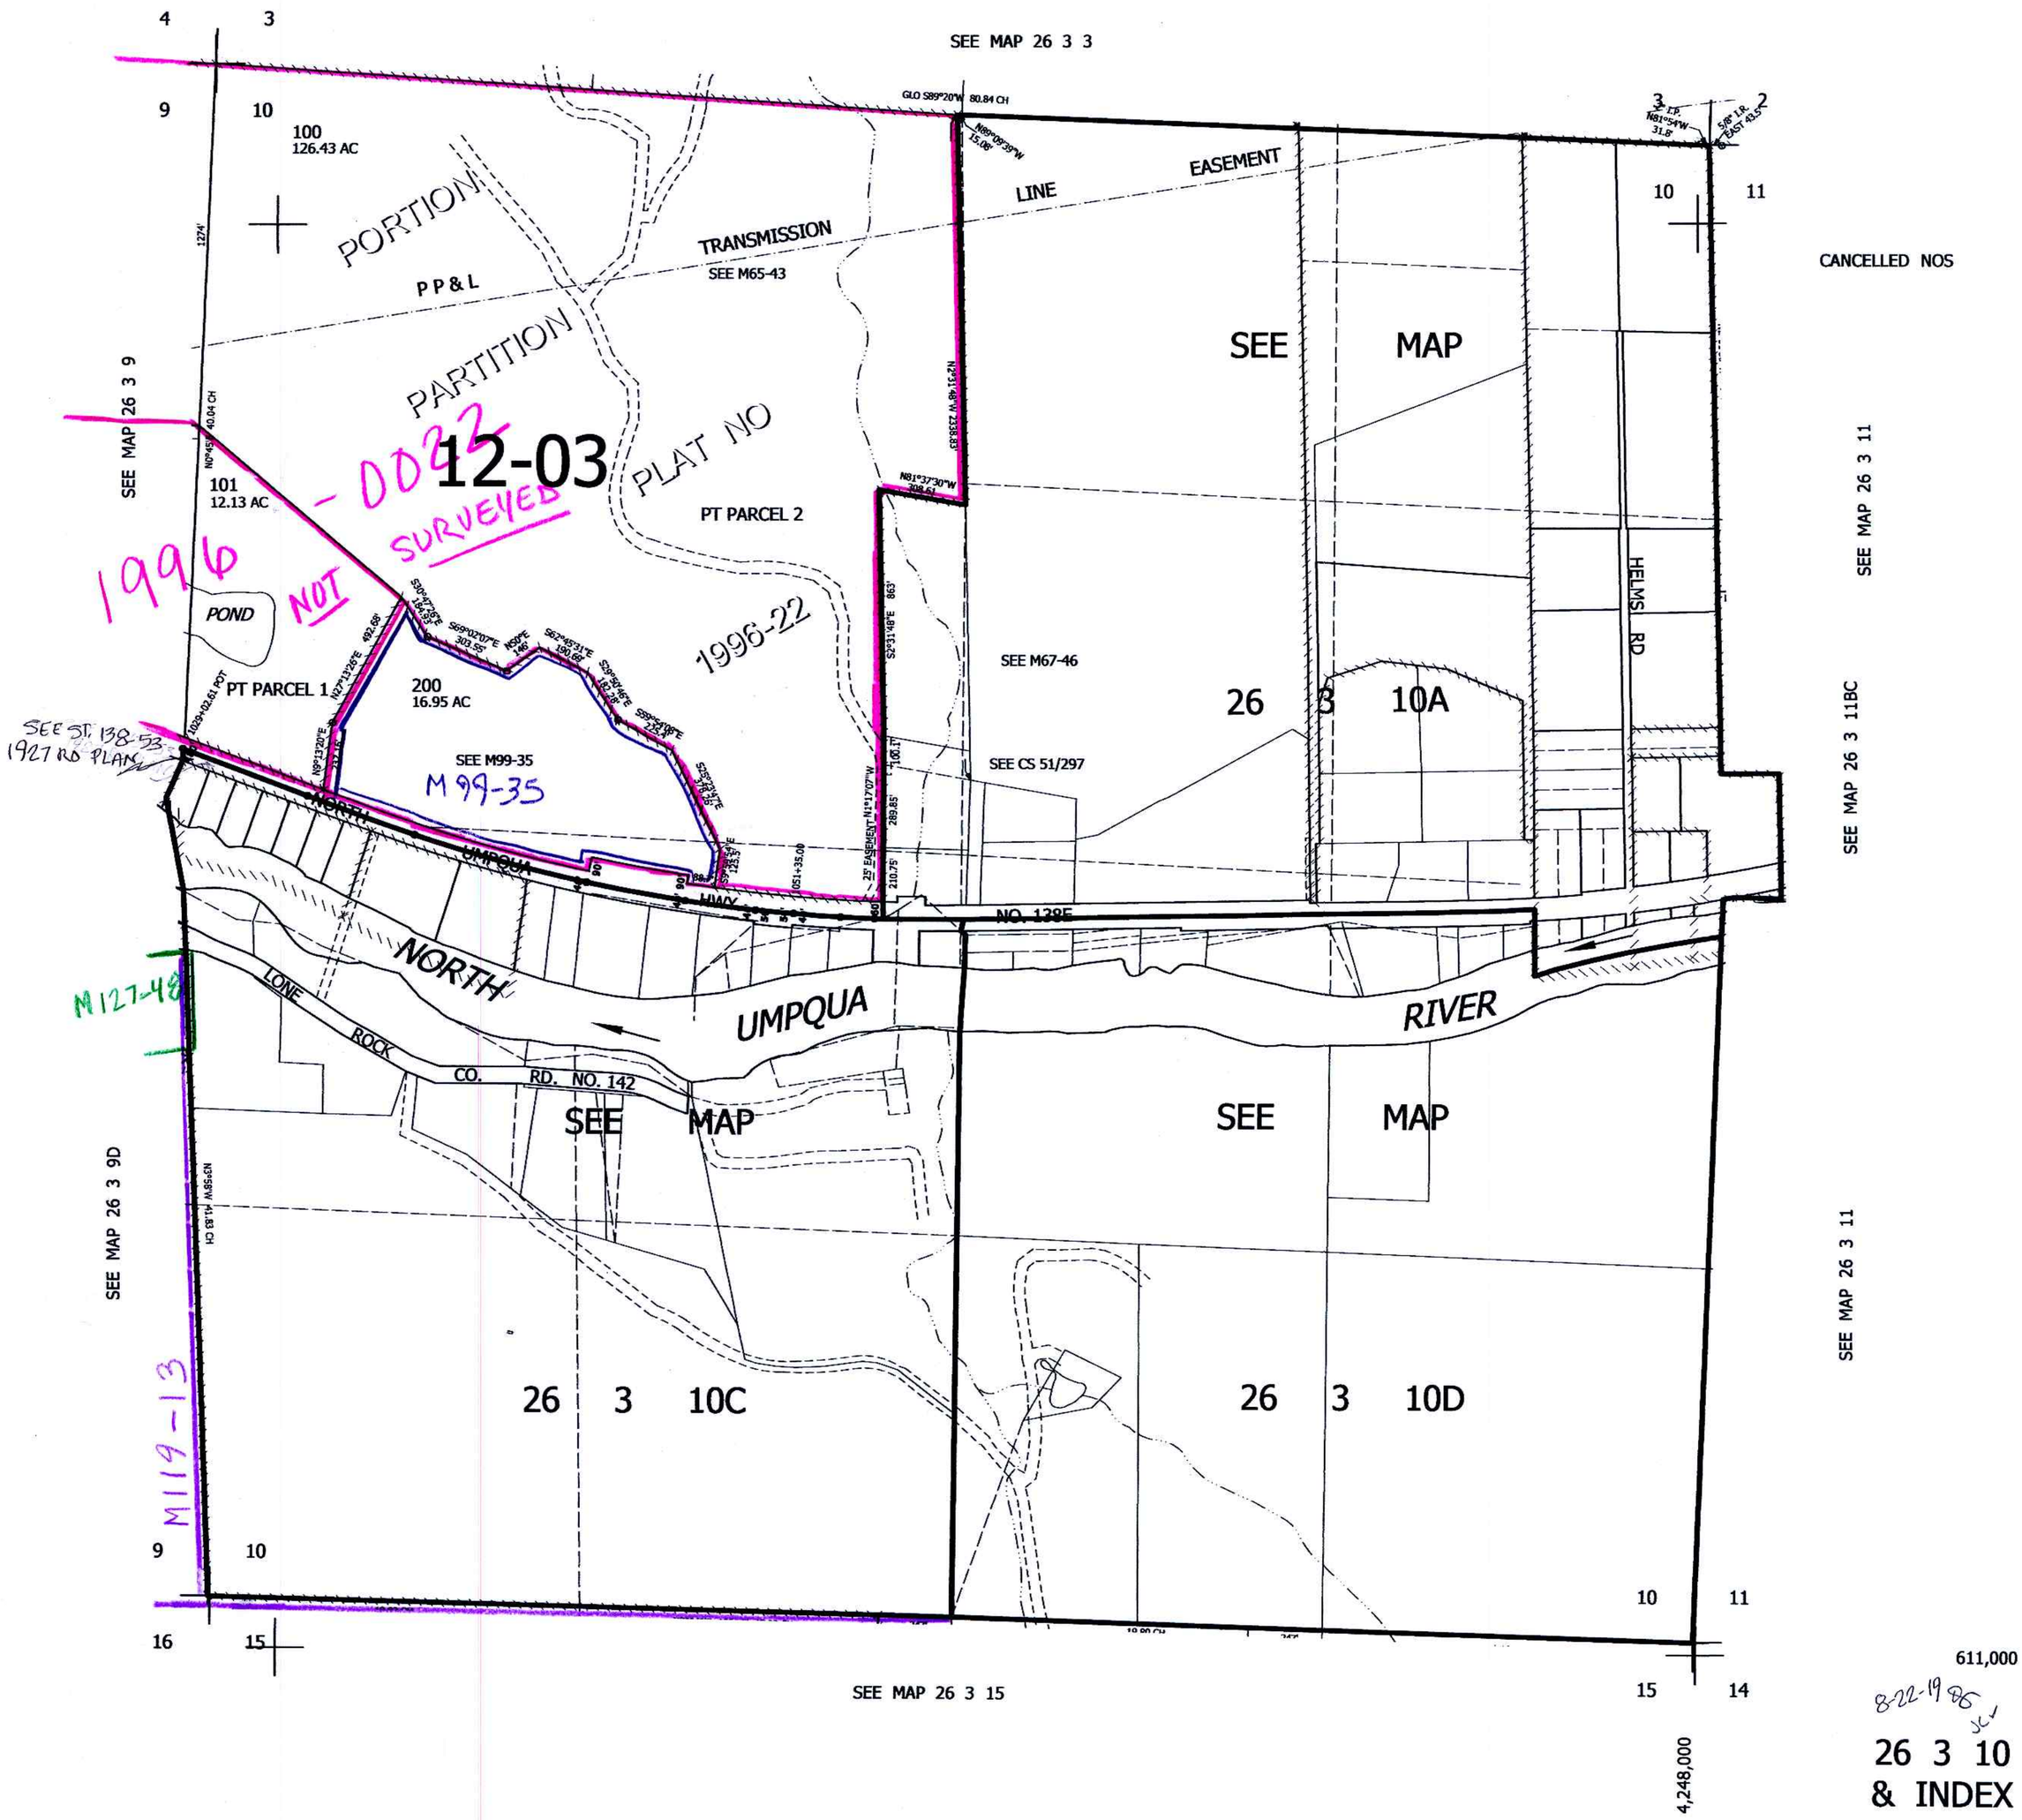
26 3 10 & INDEX