THIS MAP WAS PREPARED FOR ASSESSMENT PURPOSE ONLY.

NE1/4 SEC.11 T.26S. R.3W. W.M.
DOUGLAS COUNTY

1" = 200'

REVISED ON 8-21-19

26 3 11A & INDEX

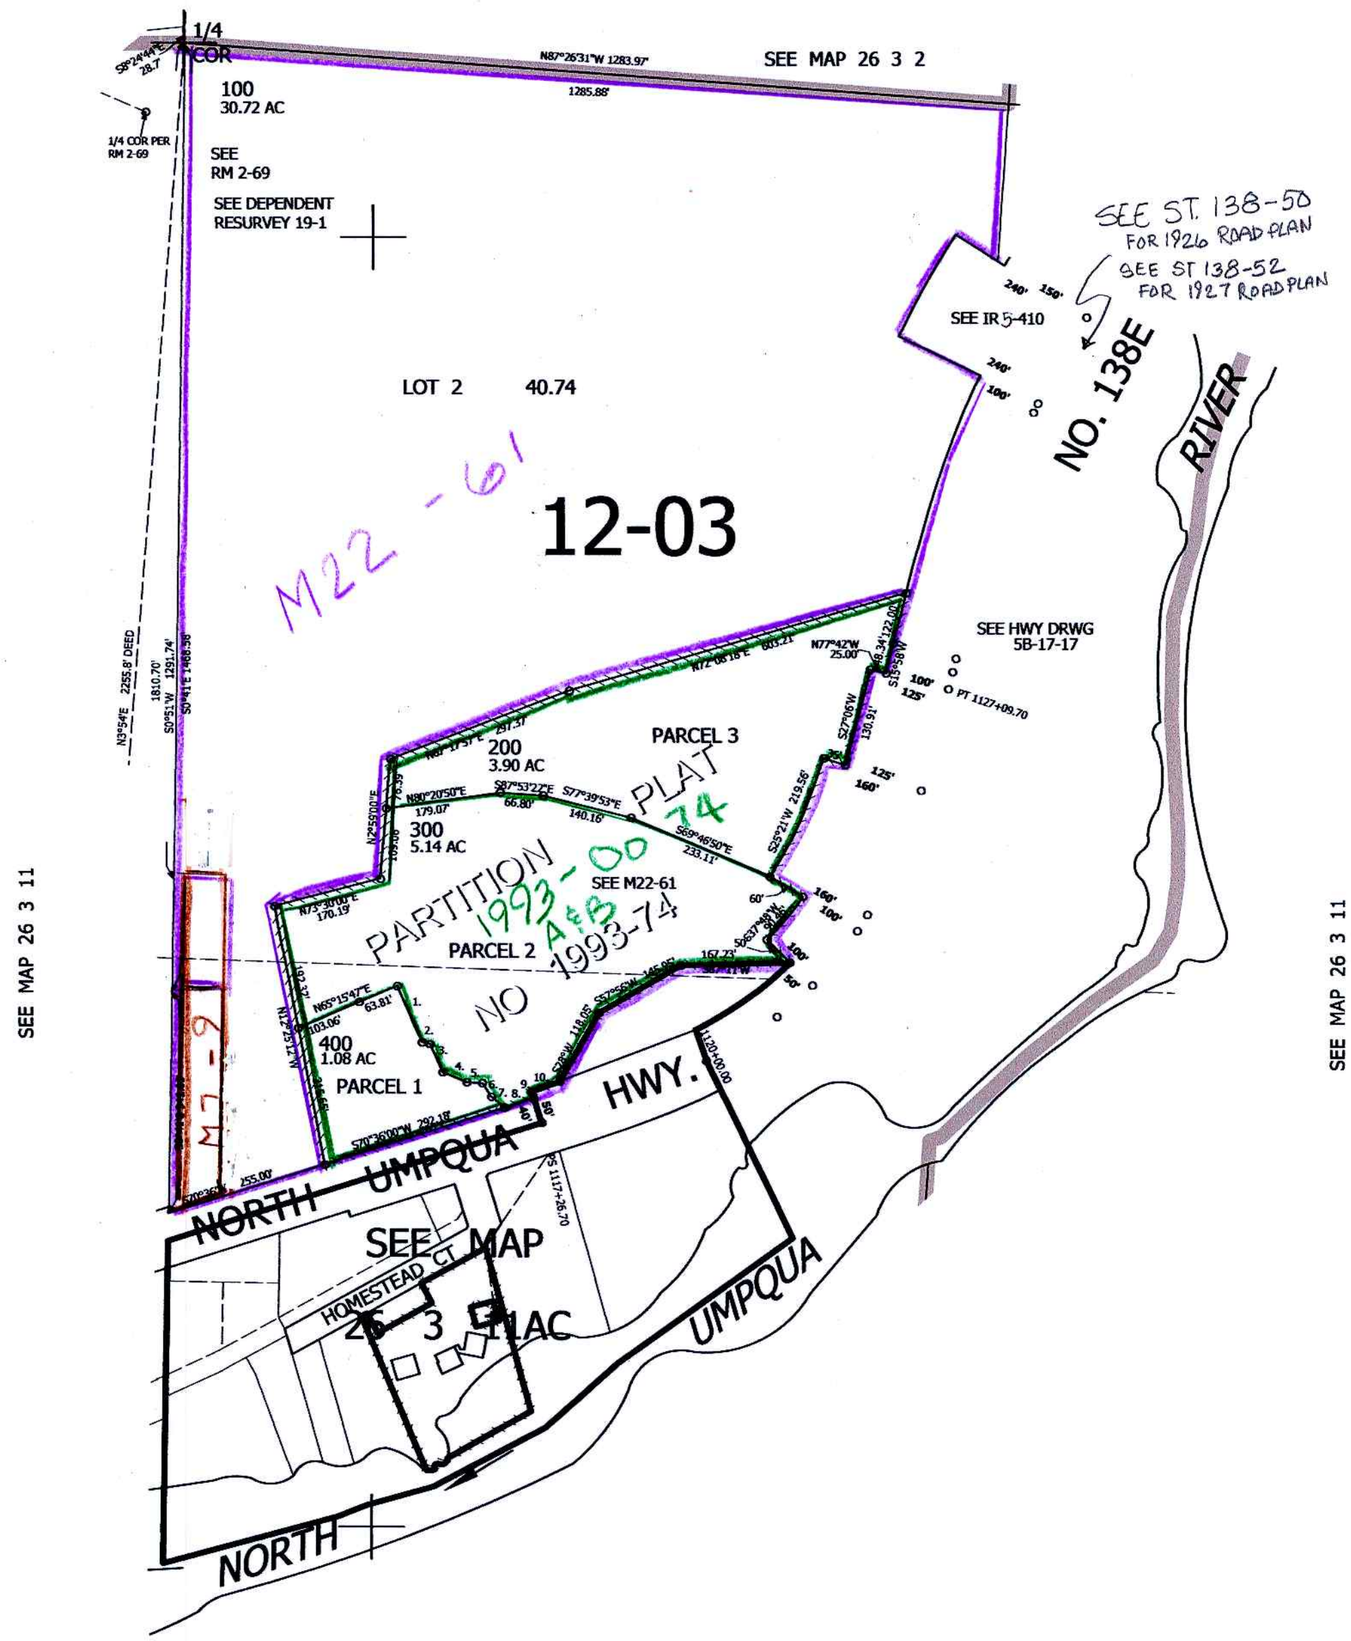

2 1

11 12

CANCELLED NOS

PARCEL 300

1. S25°33'55"E 95.35'
2. S79°40'36"E 12.38'
3. S26°49'39"E 484.33'
4. S69°18'35"E 40.35'
5. S89°06'10"E 24.15'
6. S34°35'15"E 25.14'
7. S52°09'03"E 26.52'
8. S70°36'00"W 47.65'
9. S19°29'47"E 10.11'
10. S64°09'51"W 49.98'

614,000

CEN SEC

1/4 COR

4,253,000

8-22-19 JCV

26 3 11A & INDEX