THIS MAP WAS PREPARED FOR ASSESSMENT PURPOSE ONLY.

SW1/4 NW1/4 SEC.11 T.26S. R.3W. W.M.
DOUGLAS COUNTY
1" = 100'

REVISED ON 12-3-20

26 3 11BC

CANCELLED NOS 900 1400 300

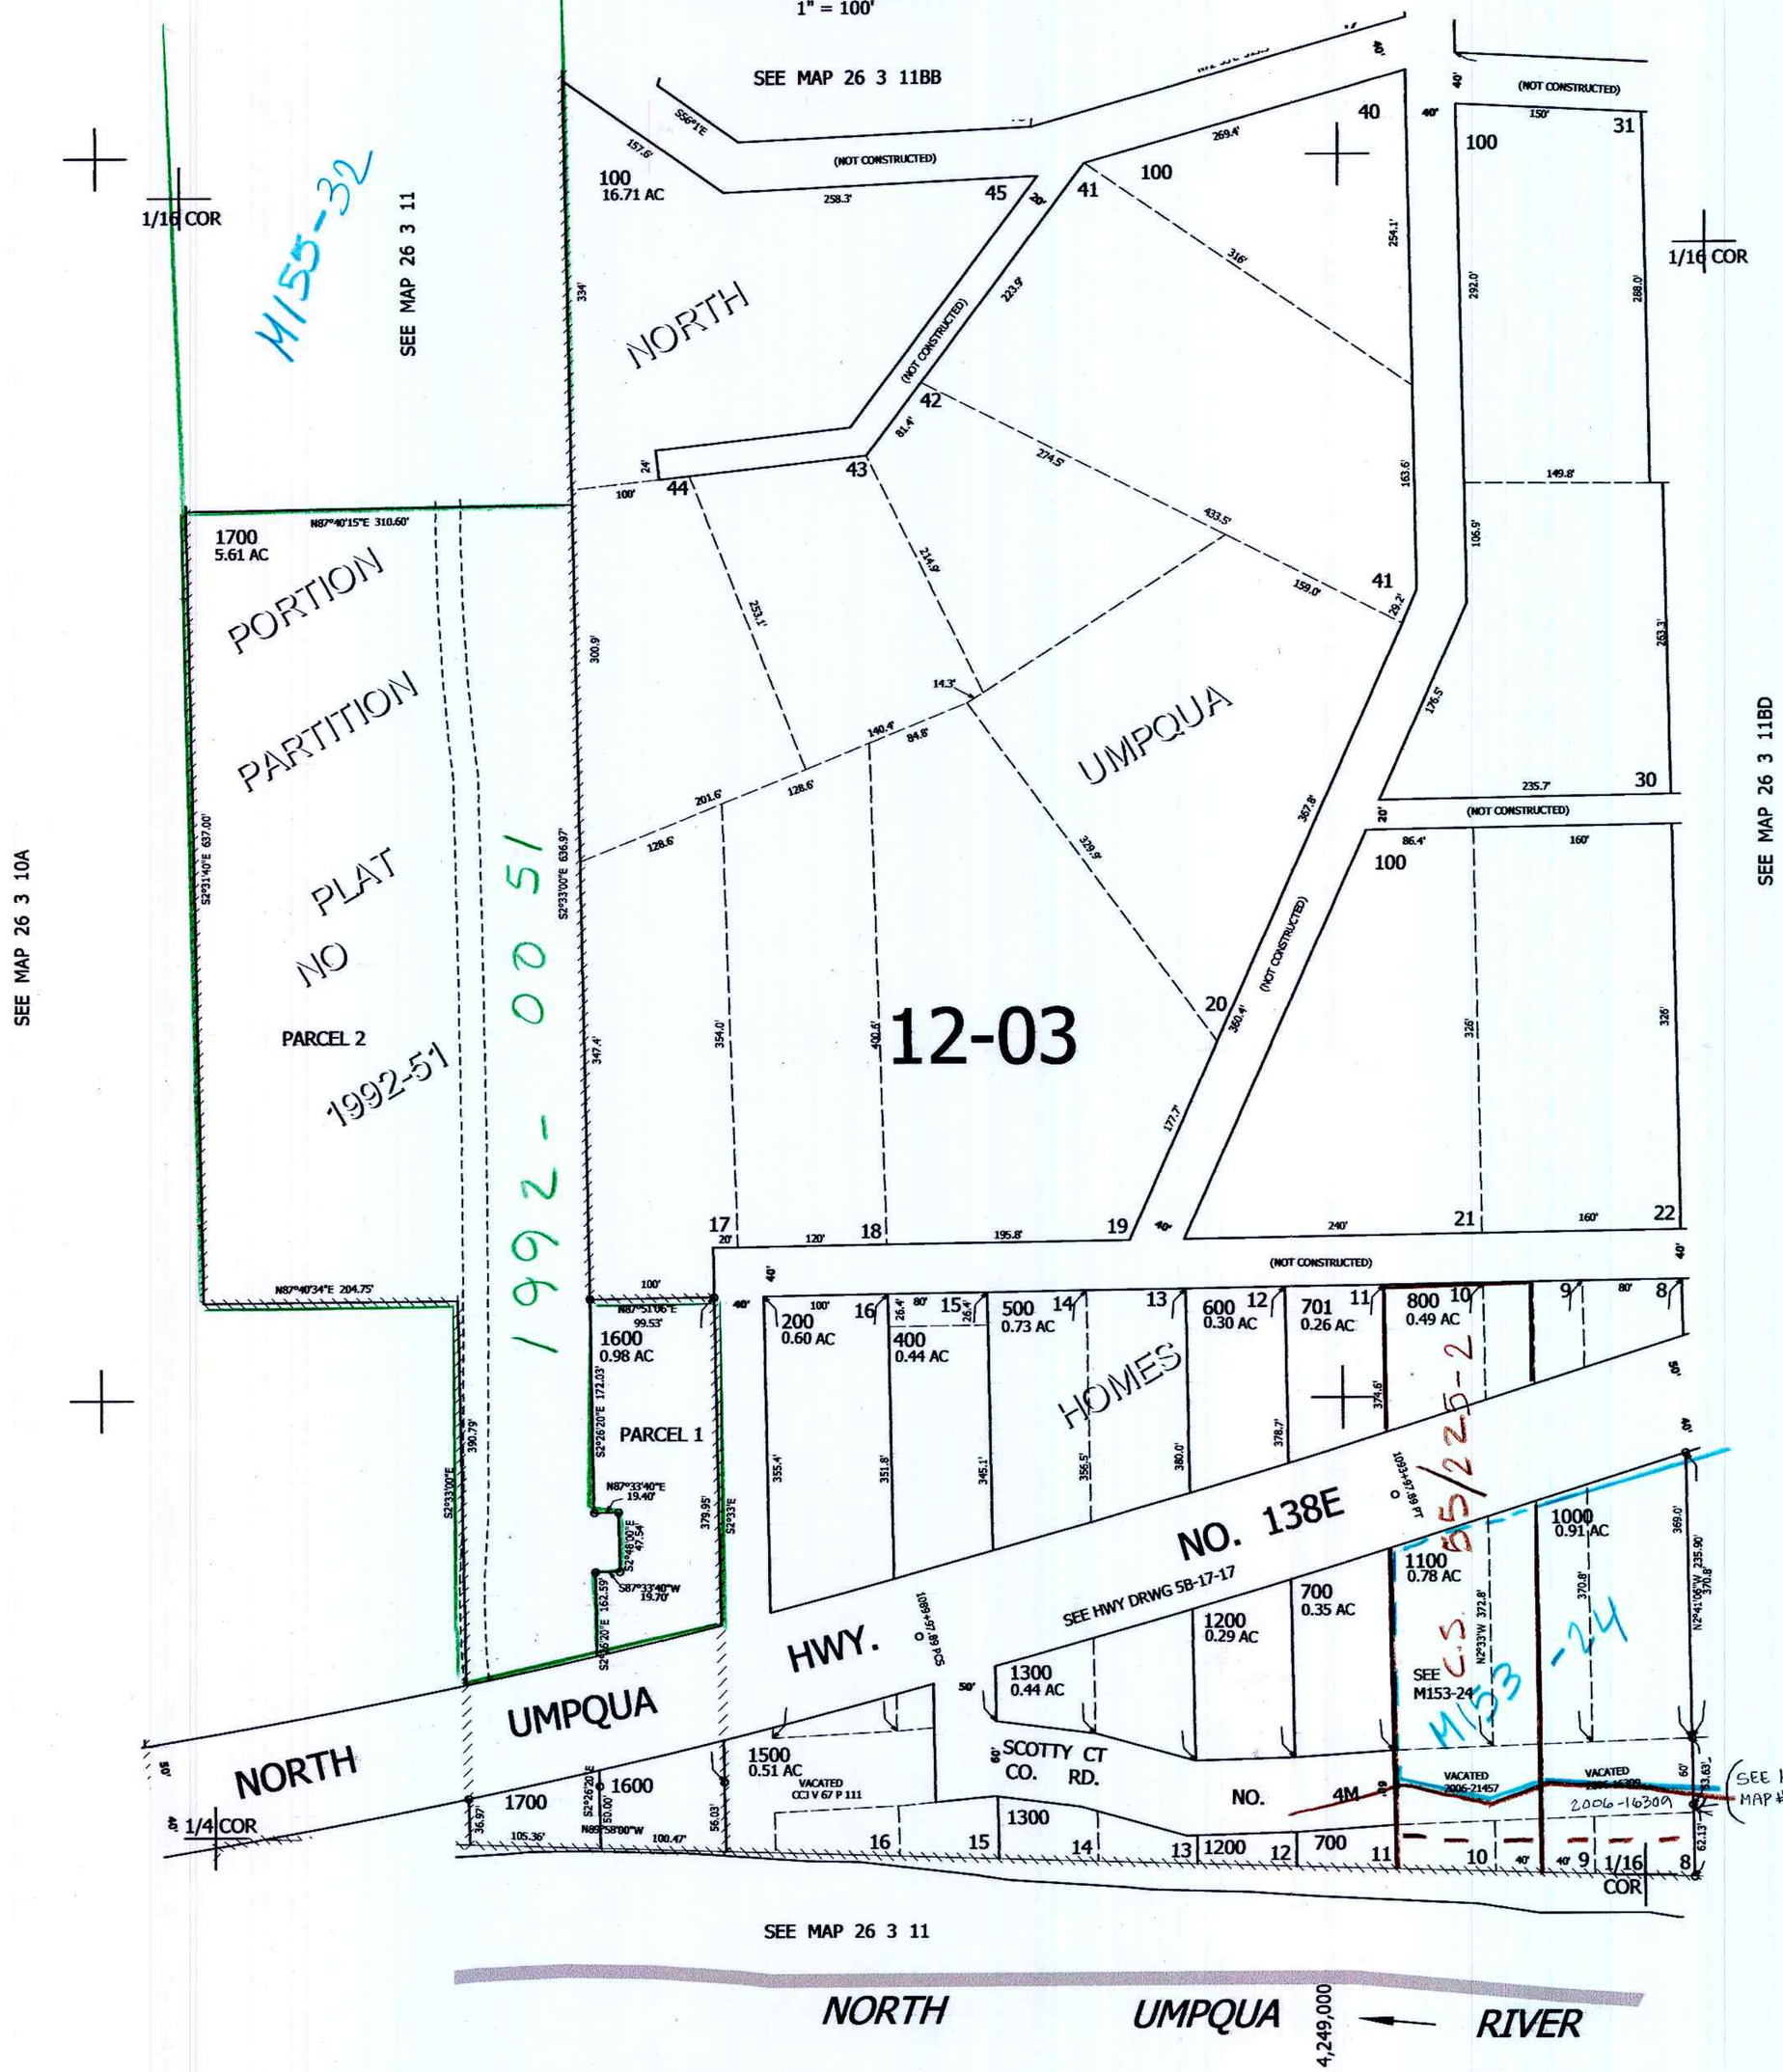

12/2020 DR

26 3 11BC