THIS MAP WAS PREPARED FOR ASSESSMENT PURPOSE ONLY.

SW1/4 SW1/4 SEC.17 T.26S. R.3W. W.M.
DOUGLAS COUNTY
1" = 100'

REVISED ON 3-28-16

26 3 17CC

CANCELLED NO'S 100 300 400 2404

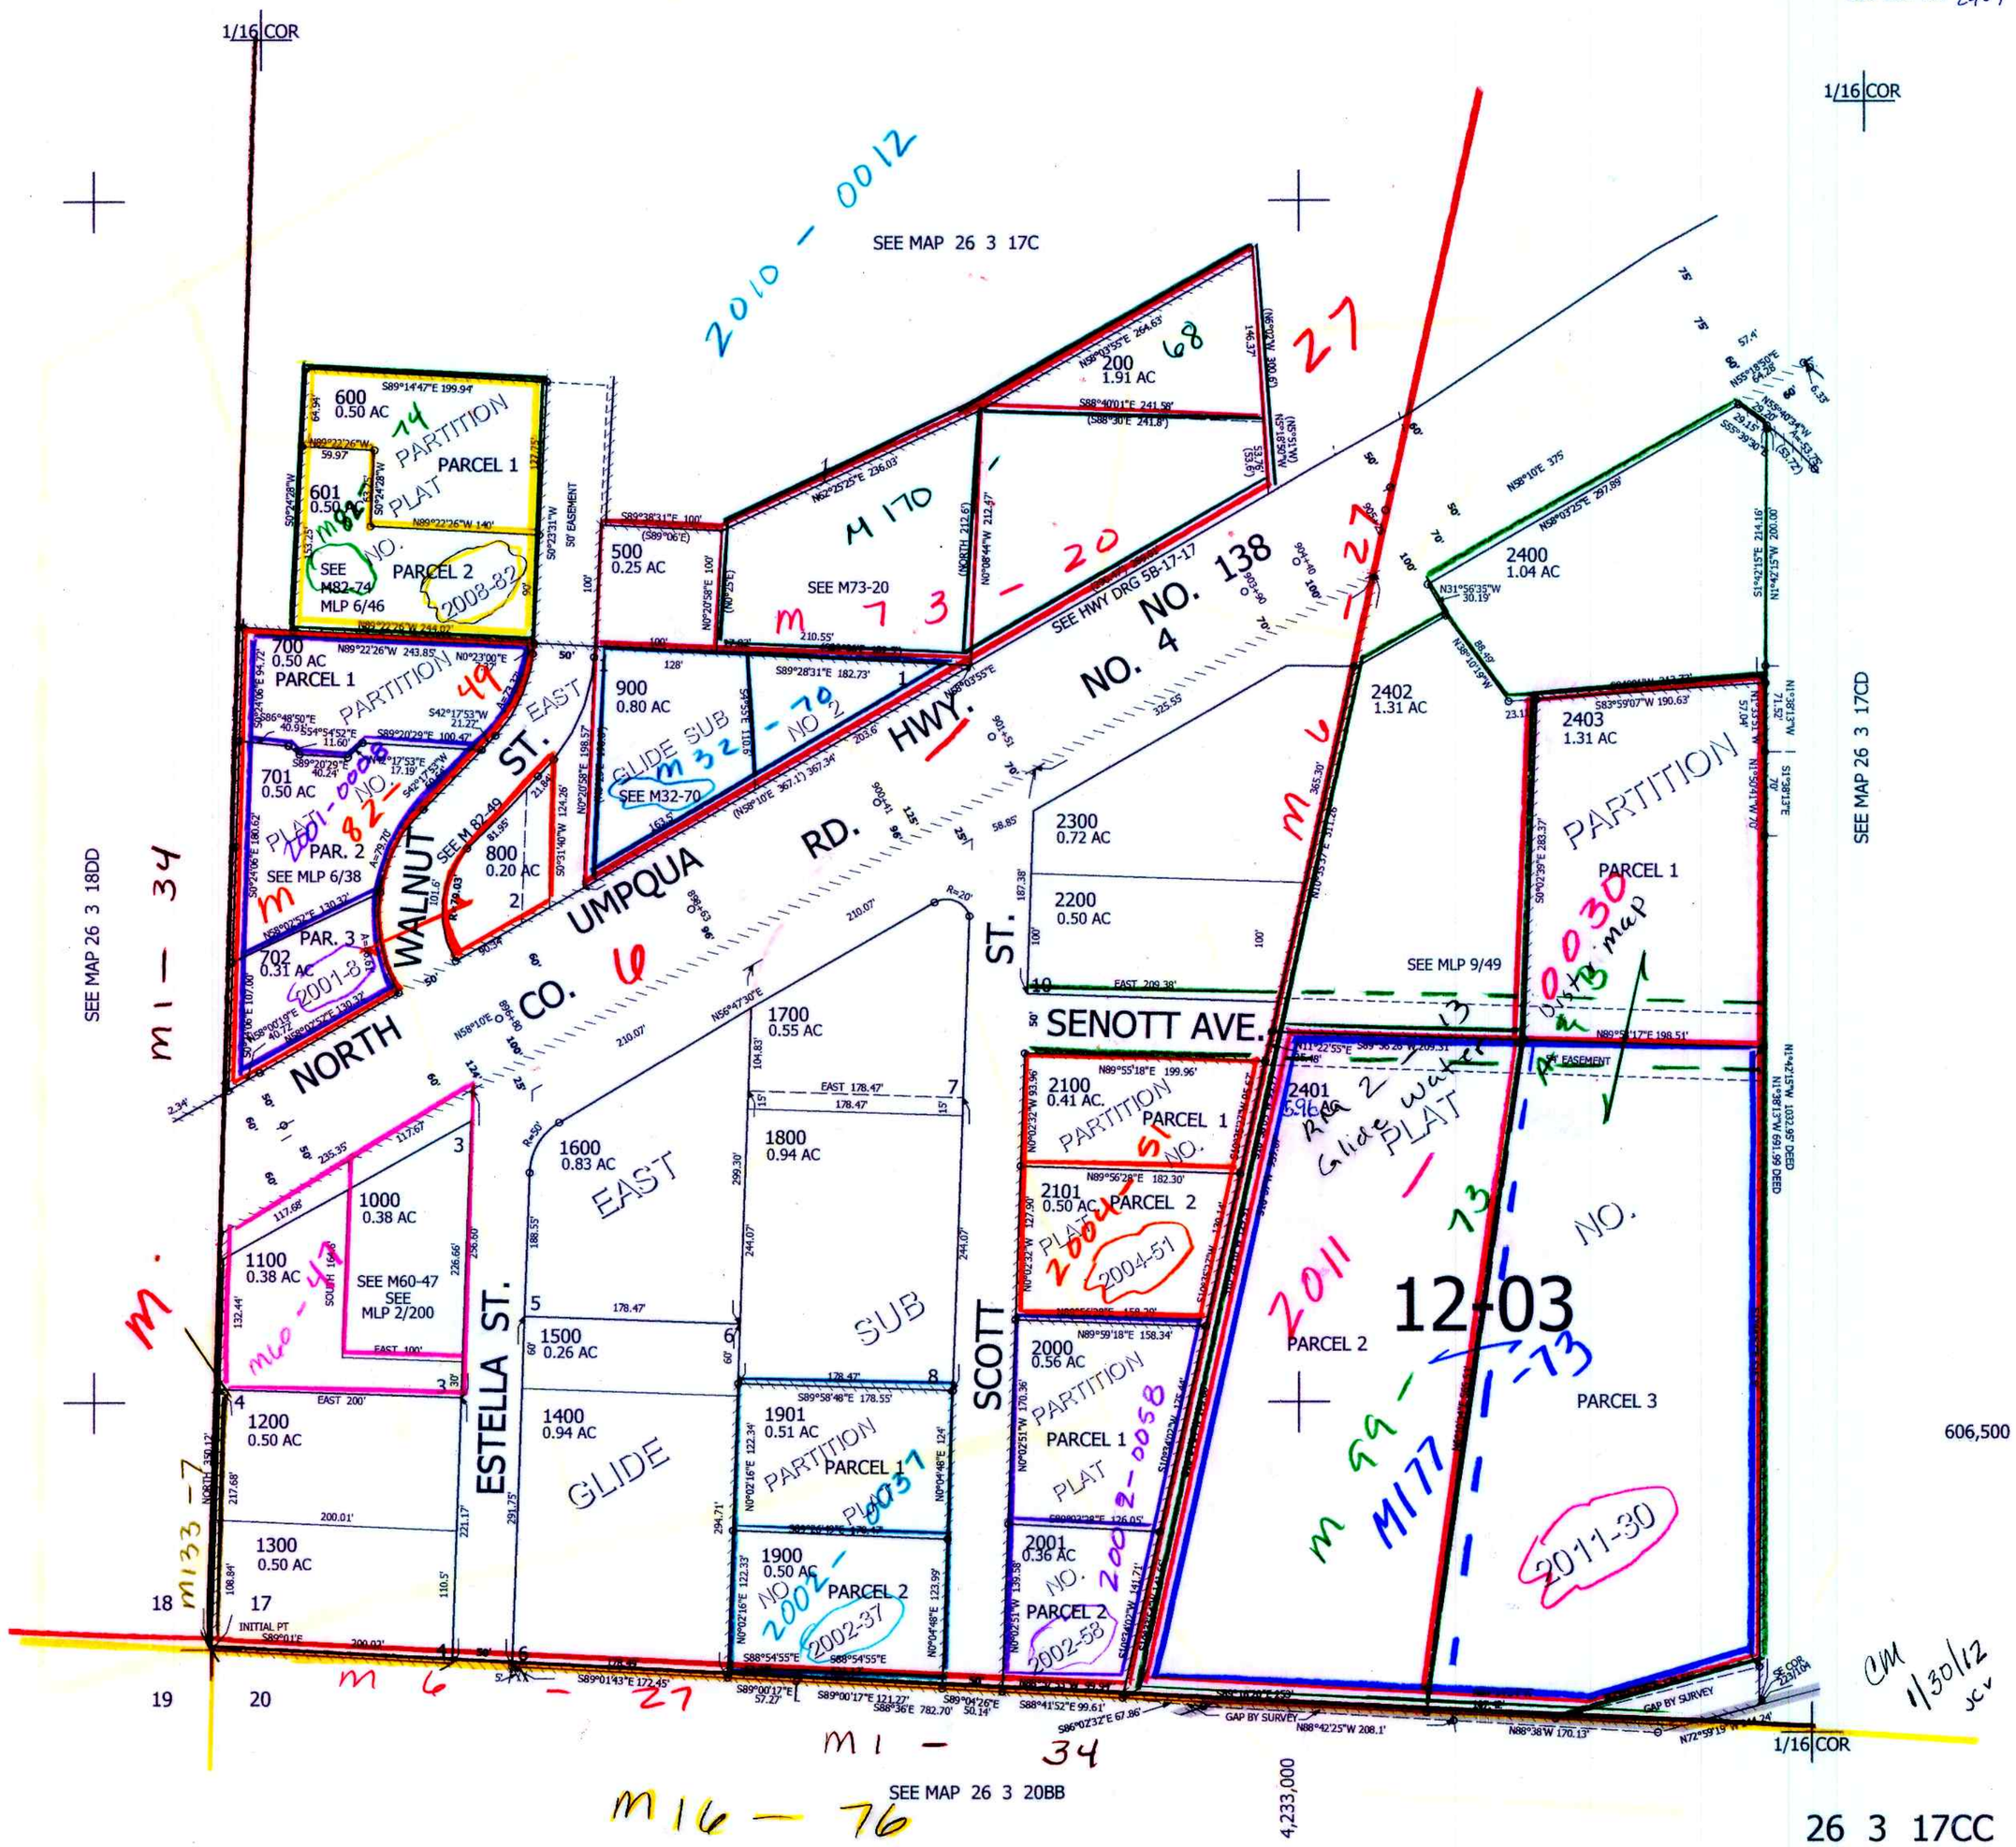

26 3 17CC