SECTION 18 T.26S. R.3W. W.M.
DOUGLAS COUNTY

1"-400'

26 3 18
& INDEX

THIS MAP WAS PREPARED FOR
ASSESSMENT PURPOSE ONLY.

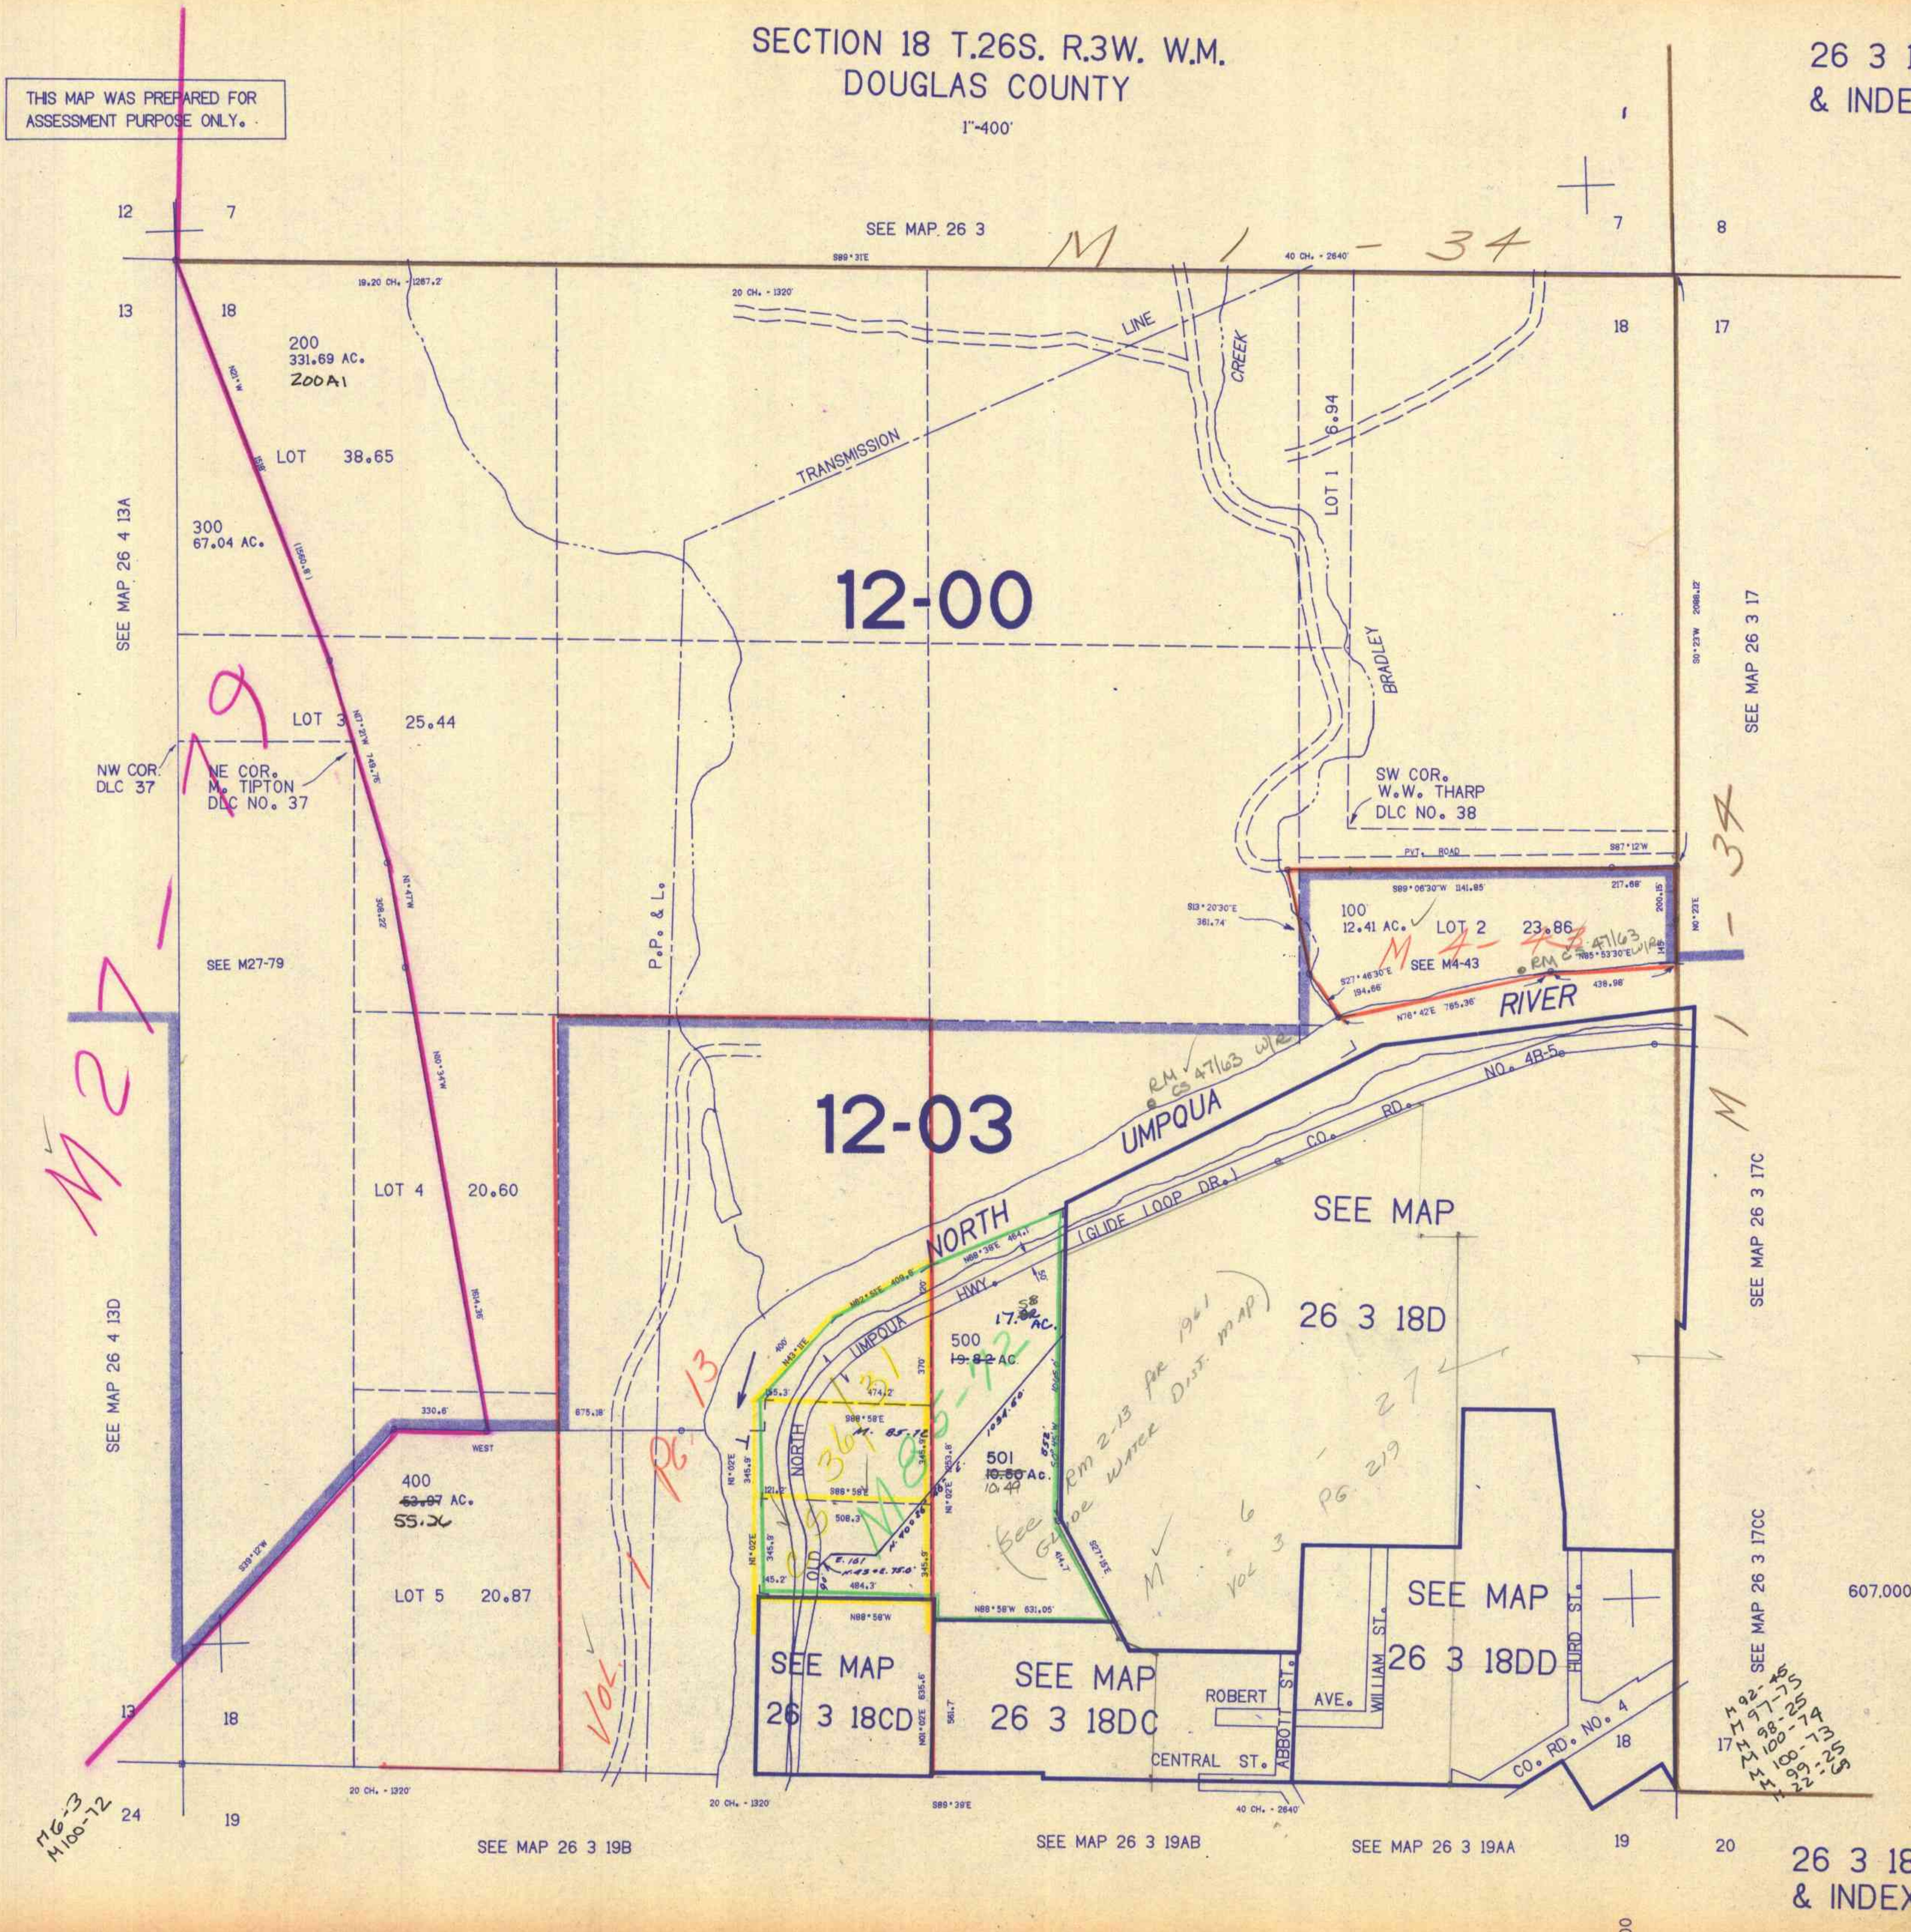

12
7
13
18
SEE MAP 26 3
S89°31'E
19.20 CH. - 1287.2'
20 CH. - 1320'
40 CH. - 2640'
M 1 - 34
7
8
18
17
200
331.69 AC.
200A1
N21°W
1518'
LOT 38.65
300
67.04 AC.
(1560.8')
TRANSMISSION
LINE
CREEK
LOT 1 6.94
BRADLEY
12-00
SEE MAP 26 4 13A
LOT 3 25.44
N17°21'W 749.76'
NW COR. DLC 37
NE COR. M. TIPTON DLC NO. 37
M27-79
N1°47'W
308.22'
SEE M27-79
N0°34'W
1514.36'
SW COR. W.W. THARP DLC NO. 38
PVT. ROAD
S87°12'W
S0°23'W 2088.12'
SEE MAP 26 3 17
S89°06'30"W 1141.85'
217.68'
200.15'
S13°20'30"E 361.74'
100
12.41 AC.
LOT 2 23.86
M 4-43
SEE M4-43
RM CS 47/63 W/R
N85°53'30"E
145'
N0°23'E
S27°46'30"E 194.66'
N76°42'E 765.36'
438.98'
RIVER
M 1 - 34
P.P. & L.
12-03
RM CS 47/63 W/R
UMPQUA
NORTH
NO. 4B-5.
CO. RD.
(GLIDE LOOP DR.)
SEE MAP
26 3 18D
SEE MAP 26 3 17C
LOT 4 20.60
N68°38'E 464.1'
N62°51'E 409.6'
120'
50'
HWY.
400'
N43°11'E
UMPQUA
NORTH
OLD
500
17.58 AC.
~~19.82~~ AC.
370'
155.3'
474.2'
S88°58'E
M. 85-12
CS 361/31
M85-12
1034.60'
1045'
S0°45'W
552'
501
~~10.80~~ Ac.
10.49
N1°02'E
345.9'
121.2'
S88°58'E
508.3'
N1°02'E
353.8'
40'
N.40°06'E
E.161
N.43°E. 75.0'
90'
345.8'
345.9'
45.2'
484.3'
N88°58'W
N88°58'W 631.05'
S27°15'E
414.7'
See RM 2-13 for 1961 Glide Water Dist. map)
M 6 - 27
VOL 3 PG. 219
Vol. 1 PG. 13
330.6'
WEST
675.18'
400
~~53.97~~ AC.
55.26
S39°12'W
LOT 5 20.87
SEE MAP 26 4 13D
SEE MAP
26 3 18CD
N01°02'E 635.6'
561.7'
SEE MAP
26 3 18DC
ROBERT
ST.
ABBOTT ST.
CENTRAL ST.
AVE.
WILLIAM ST.
SEE MAP
26 3 18DD
HURD ST.
CO. RD. NO. 4
SEE MAP 26 3 17CC
607,000
18
17
M 92-45
M 97-75
M 98-25
M 100-74
M 100-73
M 99-25
M 22-69
13
18
24
19
M6-3
M100-72
20 CH. - 1320'
S89°39'E
40 CH. - 2640'
SEE MAP 26 3 19B
SEE MAP 26 3 19AB
SEE MAP 26 3 19AA
19
20
311,000

26 3 18
& INDEX

10/84 R