THIS MAP WAS PREPARED FOR ASSESSMENT PURPOSE ONLY.

SW1/4 NE1/4 SEC.19 T.26S. R.3W. W.M.
DOUGLAS COUNTY

1" = 100'

REVISED ON
12-30-04

26 3 19AC

CANCELLED NO'S
600 3400

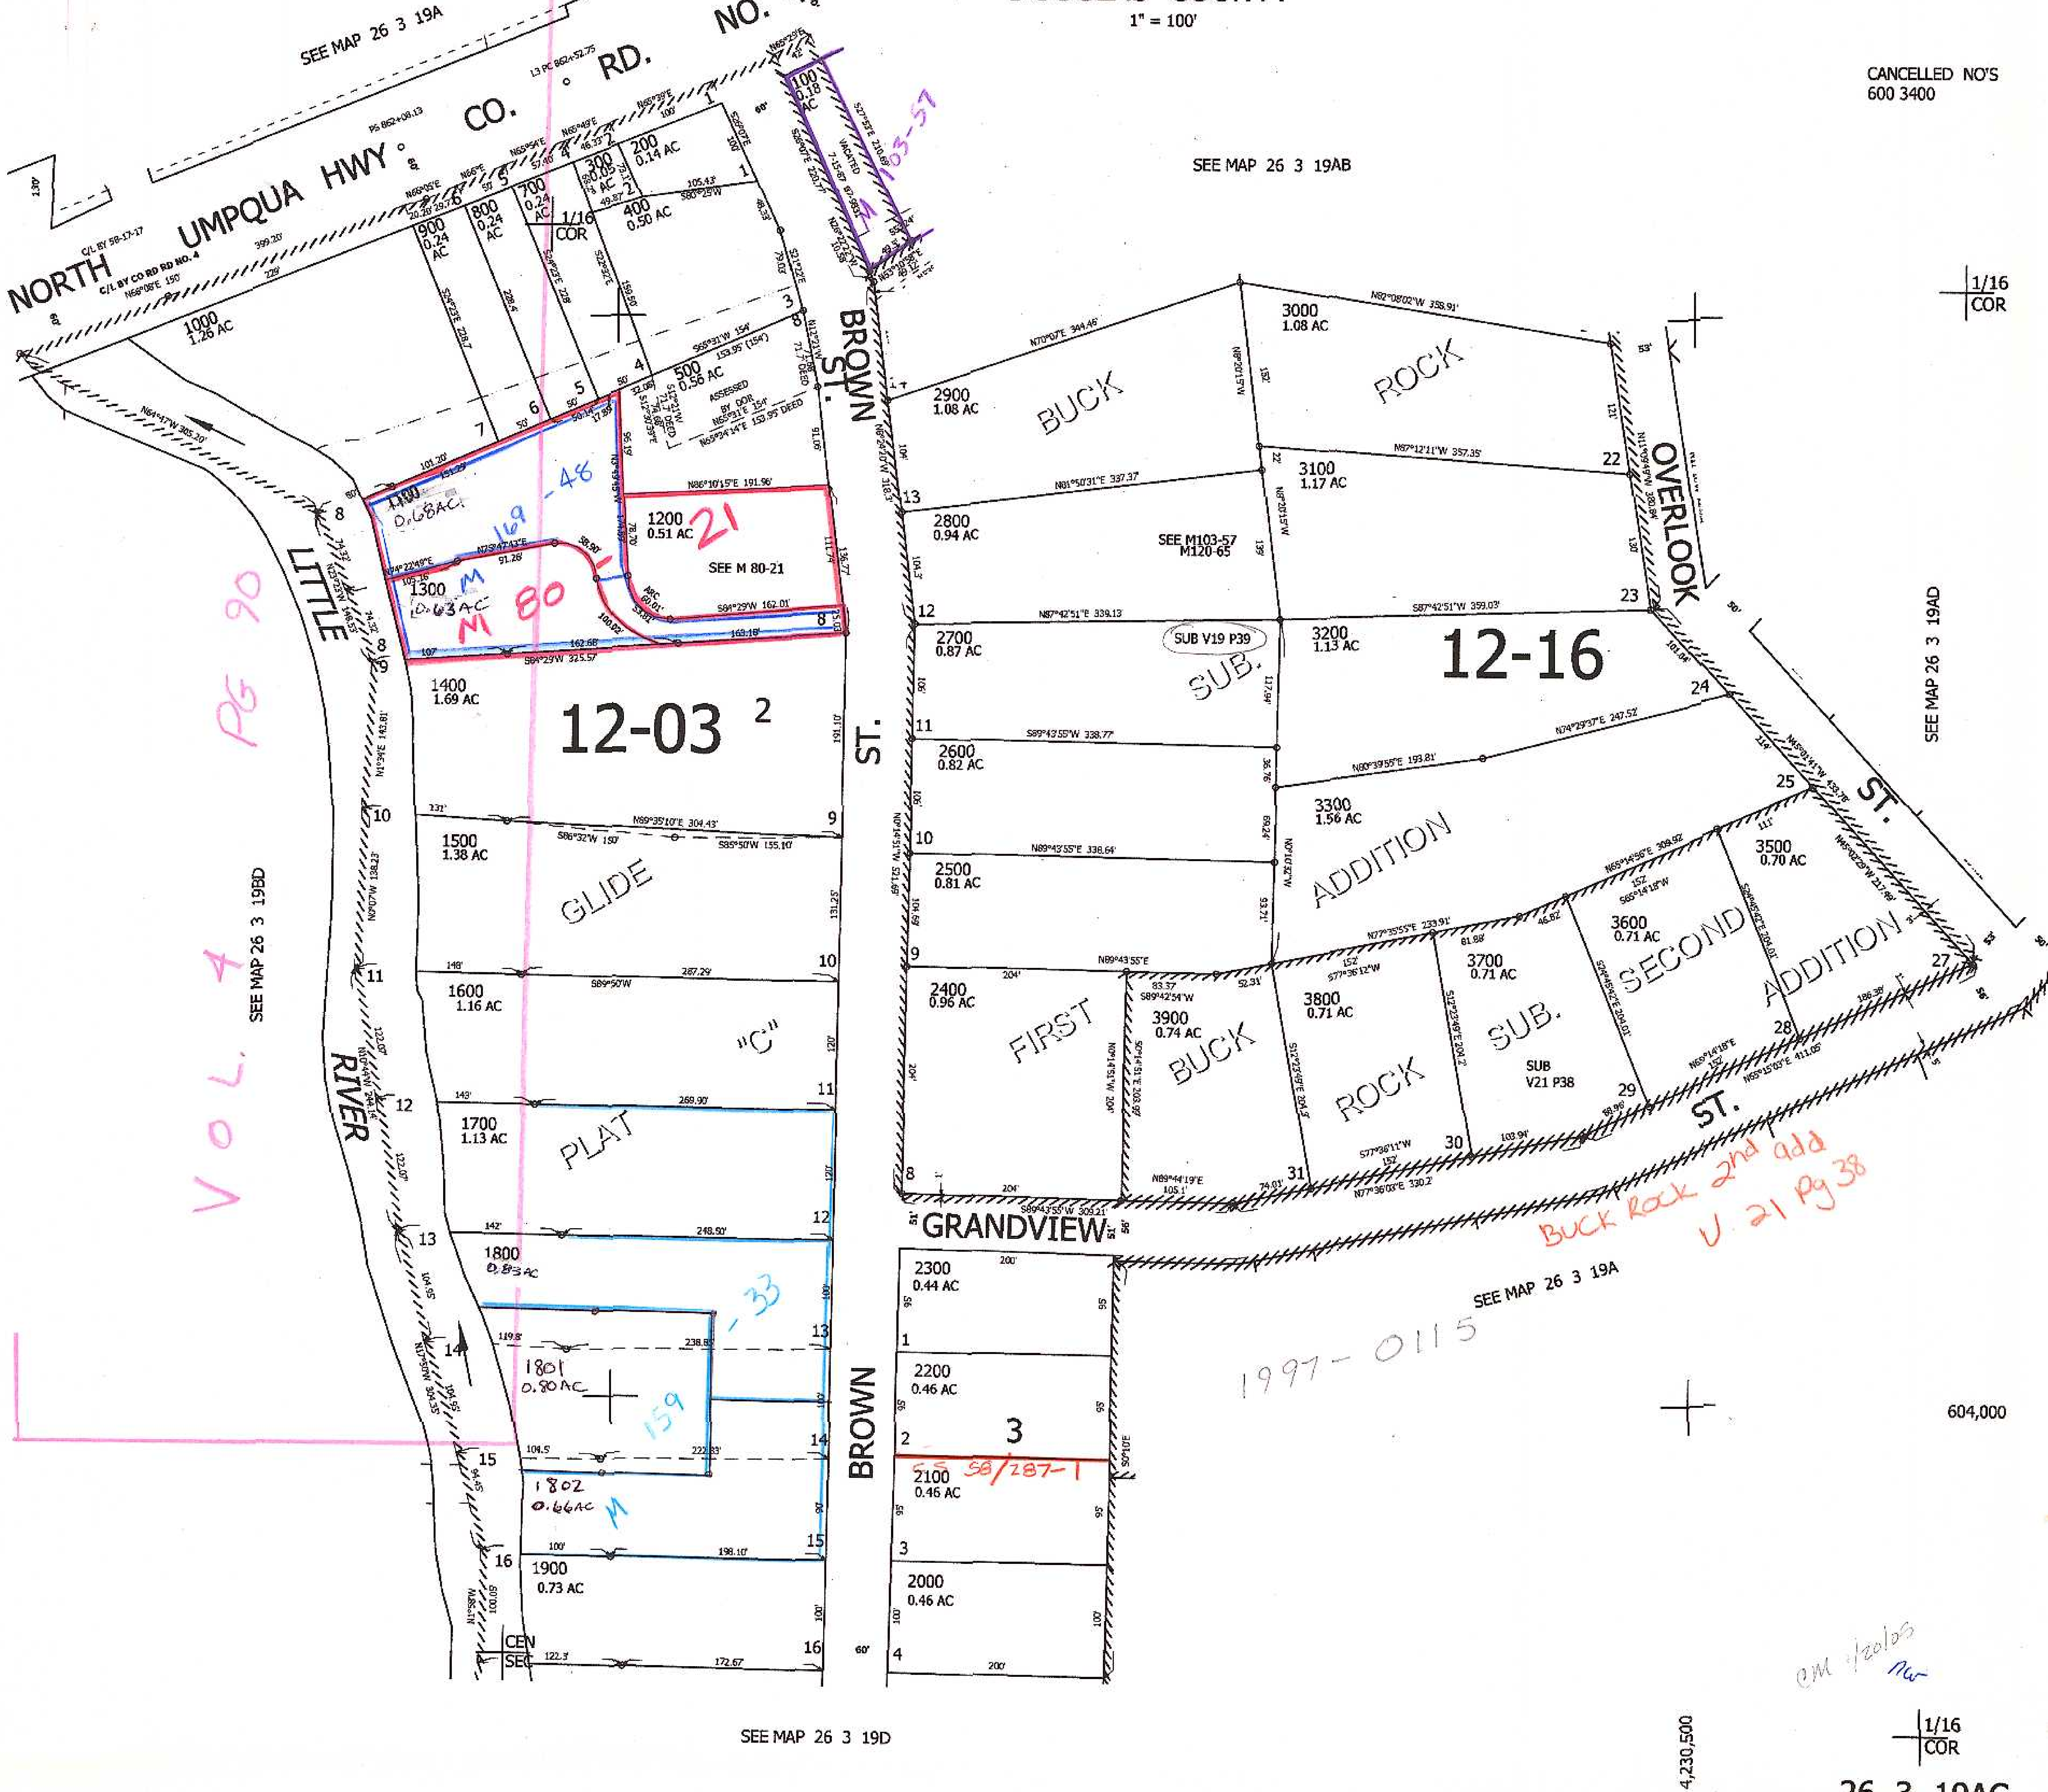
SEE MAP 26 3 19A
NORTH UMPQUA HWY. CO. RD. NO. 4
C/L BY 58-17-17
C/L BY CO RD RD NO. 4
N68°08'E 150'
399.20'
229'
PS 862+08.13
L3 PC 862+52.75
N66°05'E 20.20' 29.77
N66°E 50'
N65°54'E 57.40'
N65°49'E 46.33'
N65°39'E 100'
N65°29'E 42'
100 0.18 AC
VACATED 7-15-87 87-9831
S27°55'E 210.69'
S26°07'E 220.77'
N26°22'21"W 10.56'
N63°10'58"E 49.12'
M 103-57
200 0.14 AC
300 0.05 AC
400 0.50 AC
105.43' S80°29'W
49.87'
700 0.24 AC
800 0.24 AC
900 0.24 AC
1/16 COR
S24°23'E 228
228.4
S24°23'E 228.7
S22°32'E
159.50
1000 1.26 AC
500 0.56 AC
ASSESSED BY DOR
N65°31'E 154'
N65°34'14"E 153.95' DEED
S65°31'W 154' 153.95' (154')
S12°21'W 71.7' DEED 74.68'
S12°30'39"E 32.06'
N12°21'W 71.7' DEED 71.68
S21°12'E 79.02'
48.33'
N64°47'W 305.20'
101.20' 151.29'
1100 0.68AC
169-48
N0°59'49"W 96.19'
N86°10'15"E 191.96'
1200 0.51 AC
21
SEE M 80-21
111.74
136.77
N75°47'43"E 91.26'
N74°22'49"E 105.16
58.90'
78.70
ARC 60.01'
53.81'
100.02'
S84°29'W 162.01'
163.18'
162.68'
S84°29'W 325.57'
25.03
1300 0.63AC
M 80-
M
N25°07'W 148.53
74.32
LITTLE RIVER
1400 1.69 AC
12-03 2
191.10'
N1°34'E 143.81'
131'
N89°35'10"E 304.43'
S86°32'W 150'
S85°50'W 155.10'
1500 1.38 AC
GLIDE "C" PLAT
131.25'
N0°07'W 138.23'
148'
S89°50'W 287.29'
1600 1.16 AC
120'
N10°44'W 244.14
122.07'
143'
269.90'
1700 1.13 AC
142'
248.50'
1800 0.83AC
-33
119.8'
238.85'
1801 0.80AC
159
104.5'
222.83'
1802 0.66AC
M
104.95
N17°50'W 304.35'
94.45
100'
198.10'
1900 0.73 AC
N1°58'W 100.03
CEN SEC
122.3
172.67
60'
SEE MAP 26 3 19BD
VOL. 4 PG 90
BROWN ST.
N8°24'20"W 318.3'
N0°14'51"W 521.69'
104'
104.3'
106'
104.69
SEE MAP 26 3 19AB
N70°07'E 344.46'
2900 1.08 AC
BUCK ROCK SUB.
3000 1.08 AC
N82°08'02"W 358.91'
N8°20'15"W
152'
N87°12'11"W 357.35'
3100 1.17 AC
N1°50'31"E 337.37'
2800 0.94 AC
SEE M103-57 M120-65
139'
N87°42'51"E 339.13
S87°42'51"W 359.03'
2700 0.87 AC
SUB V19 P39
3200 1.13 AC
117.94'
12-16
S89°43'55"W 338.77'
2600 0.82 AC
36.76'
N80°39'55"E 193.81'
N74°29'37"E 247.52
3300 1.56 AC
69.24'
N0°10'32"W
93.71'
N89°43'55"E 338.64'
2500 0.81 AC
ADDITION
OVERLOOK ST.
N11°09'49"W 380.84'
53'
121'
130'
50'
101.04'
114'
N45°01'41"W 433.76
N45°02'29"W 217.89'
SEE MAP 26 3 19AD
1/16 COR
N89°43'55"E
204'
2400 0.96 AC
FIRST BUCK ROCK
83.37 S89°42'54"W
52.31'
3900 0.74 AC
N0°14'51"W 204'
S0°14'51"E 203.99'
N89°44'19"E 105.1'
74.01'
S89°43'55"W 309.21'
N77°35'55"E 233.91'
152' S77°36'12"W
81.88'
46.82'
3800 0.71 AC
S12°23'49"E 204.5'
3700 0.71 AC
S12°23'49"E 204.2'
N65°14'56"E 309.92
152' S65°14'18"W
3600 0.71 AC
S24°45'42"E 204.01'
111'
3500 0.70 AC
SECOND ADDITION
SUB. SUB V21 P38
S77°36'11"W 152'
N77°36'03"E 330.2'
103.94'
88.96'
N65°14'18"E 152'
N65°15'03"E 411.05'
186.38'
ST.
Buck Rock 2nd add V. 21 Pg 38
GRANDVIEW
51'
56'
SEE MAP 26 3 19A
2300 0.44 AC
200'
95
2200 0.46 AC
3
SS 58/287-1
2100 0.46 AC
S0°10'E
2000 0.46 AC
100'
1997-0115
604,000
SEE MAP 26 3 19D
CM 1/20/05
4,230,500
1/16 COR

26 3 19AC