

THIS MAP WAS PREPARED FOR ASSESSMENT PURPOSE ONLY.


SECTION 29 T.26S. R.4W. W.M. DOUGLAS COUNTY

REVISED ON 4-19-95

26 4 29

1"=400'

SEE MAP 26 4 20

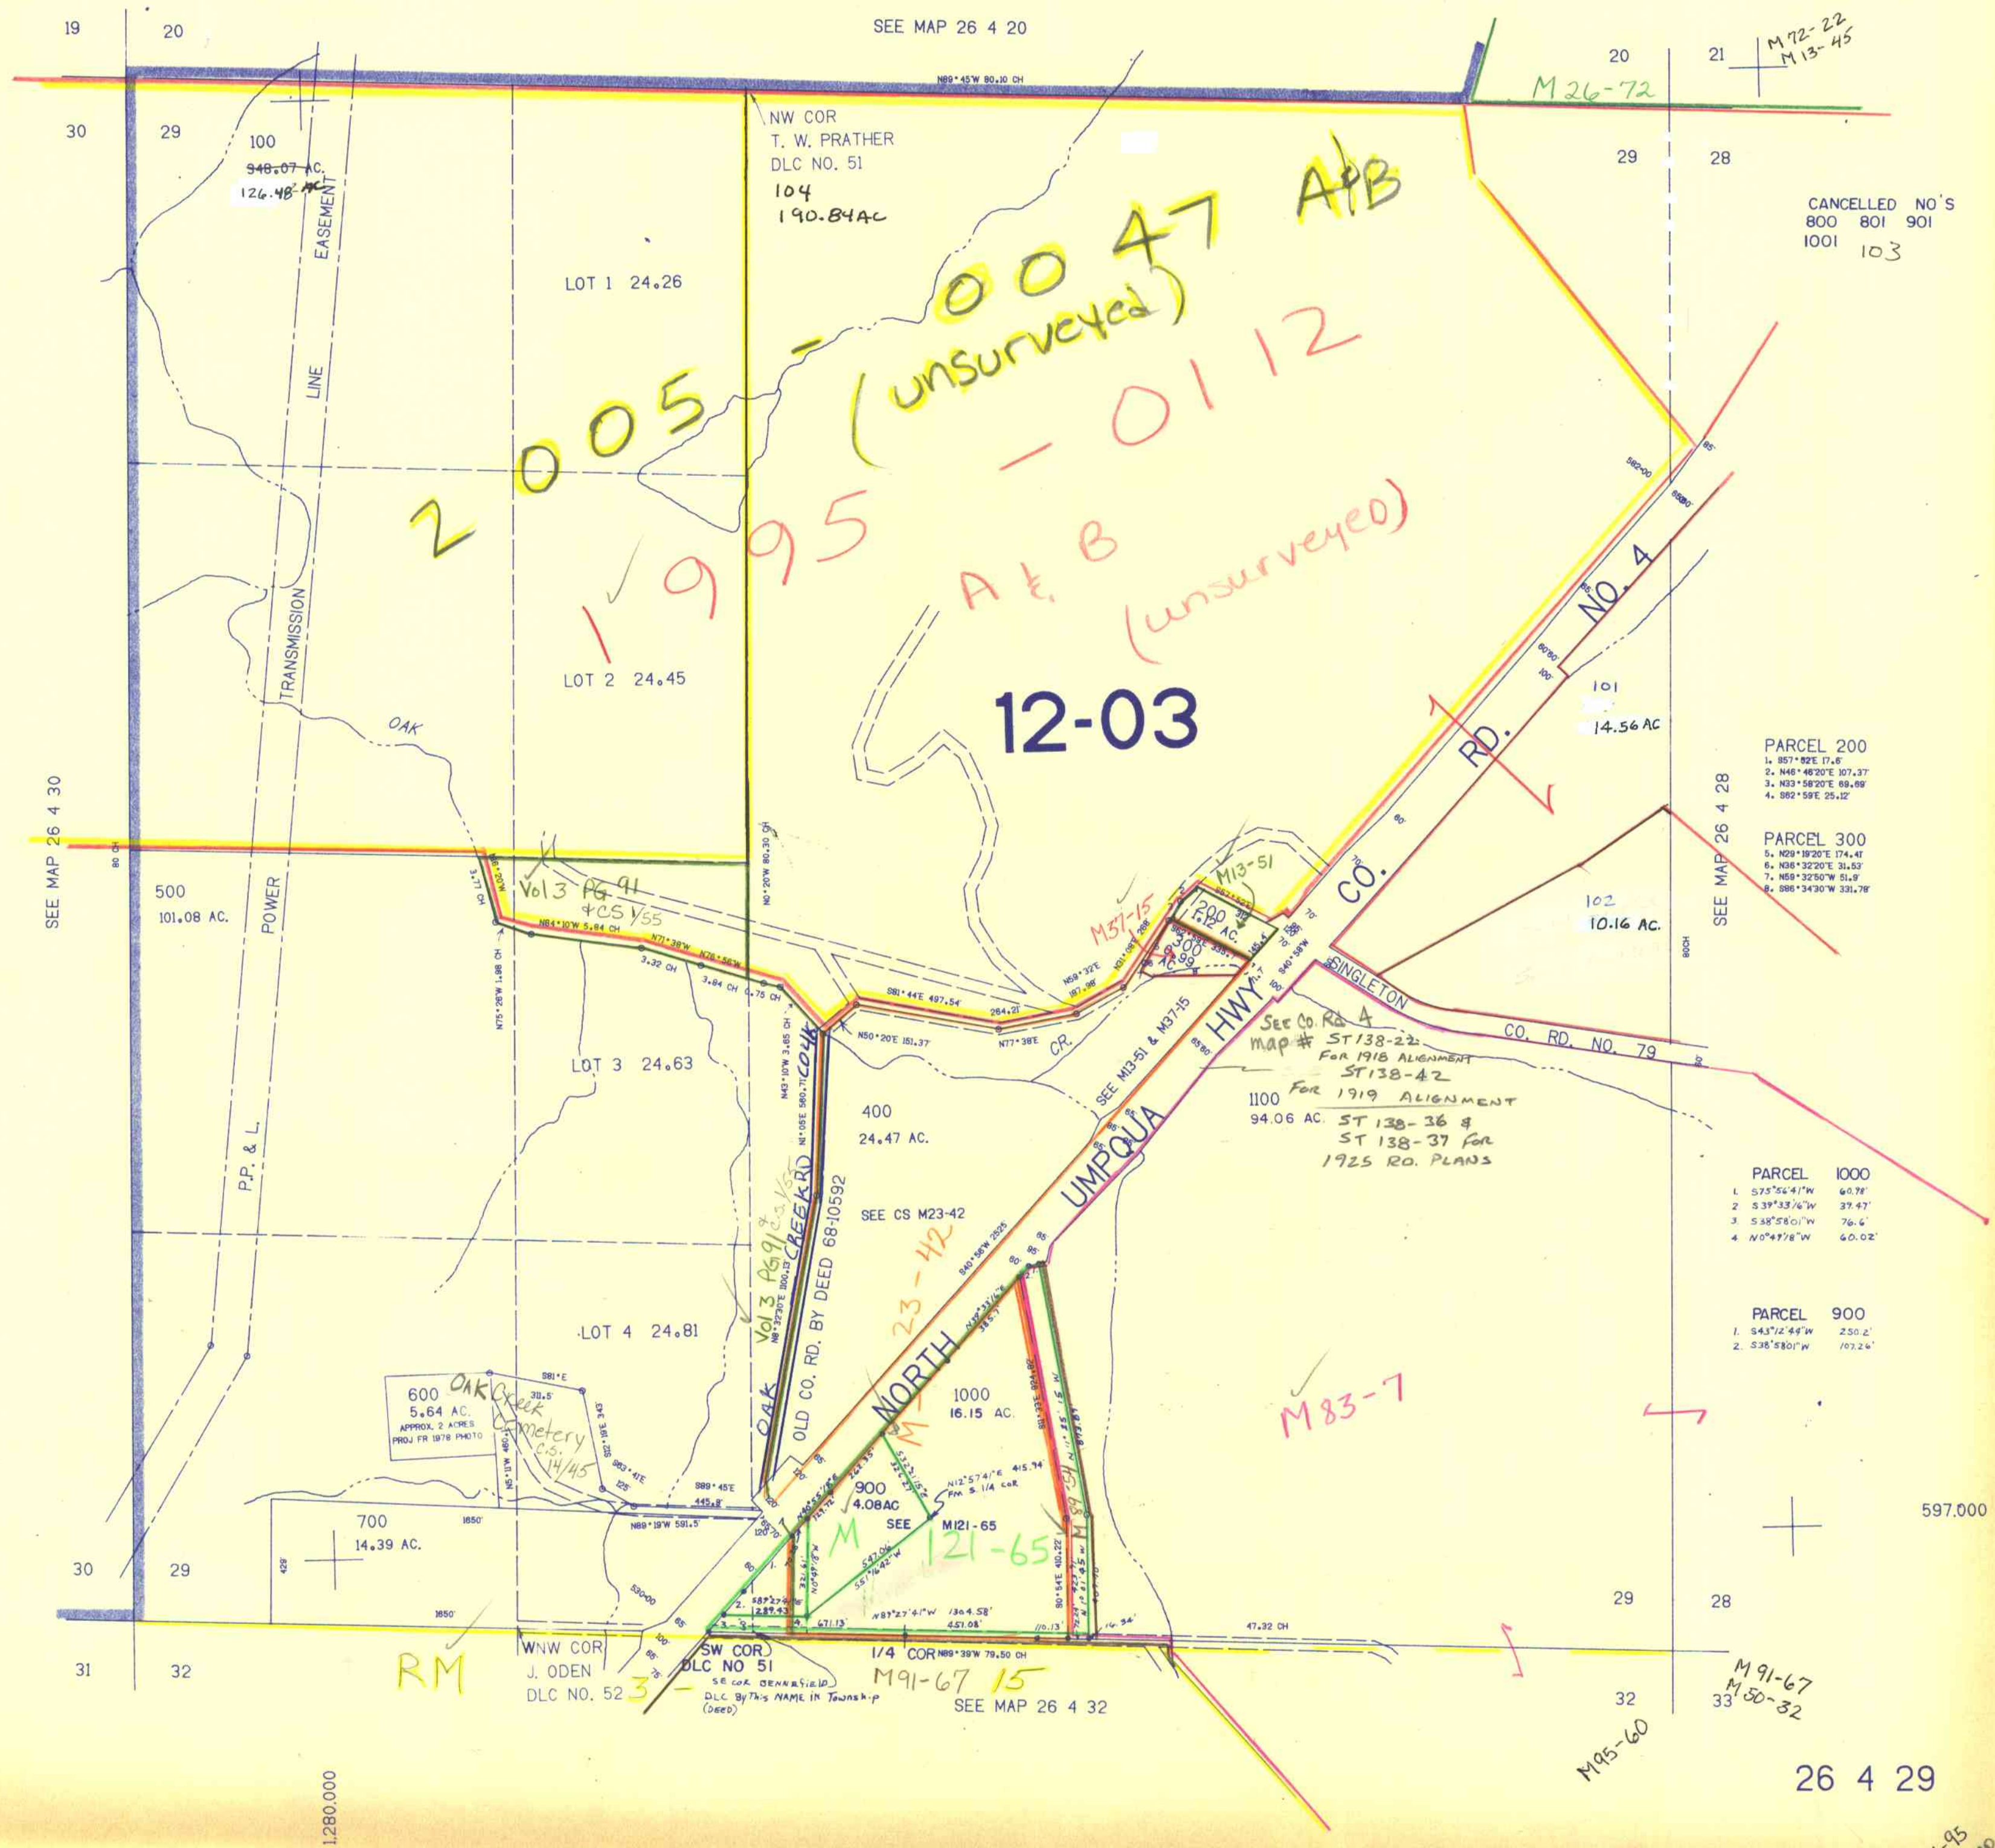

CANCELLED NO'S
800 801 901
1001 103

PARCEL 200
1. S57°32'E 17.6'
2. N48°46'20"E 107.37'
3. N33°58'20"E 89.89'
4. S82°59'E 25.12'

PARCEL 300
5. N28°18'20"E 174.41'
6. N36°32'20"E 31.53'
7. N59°32'50"W 51.9'
8. S86°34'30"W 331.78'

PARCEL 1000
1. S75°56'41"W 60.78'
2. S39°33'36"W 37.47'
3. S58°58'01"W 76.6'
4. N0°47'8"W 60.02'

PARCEL 900
1. S43°12'44"W 250.2'
2. S38°58'01"W 107.26'

SEE CO. RD. A
MAP # ST 138-22
FOR 1918 ALIGNMENT
ST 138-42
FOR 1919 ALIGNMENT
ST 138-36 &
ST 138-37 FOR
1925 RD. PLANS

600 OAK Creek
5.64 AC
APPROX. 2 ACRES
PROJ. FR. 1978 PHOTO
C.S. 14/45

RM

WNW COR J. ODEN
DLC NO. 52
SW COR J. ODEN
DLC NO. 51
DLC BY THIS NAME IN Township (Deed)

SEE MAP 26 4 32

M95-60

M91-67
M50-32

26 4 29


5-95
54 JP